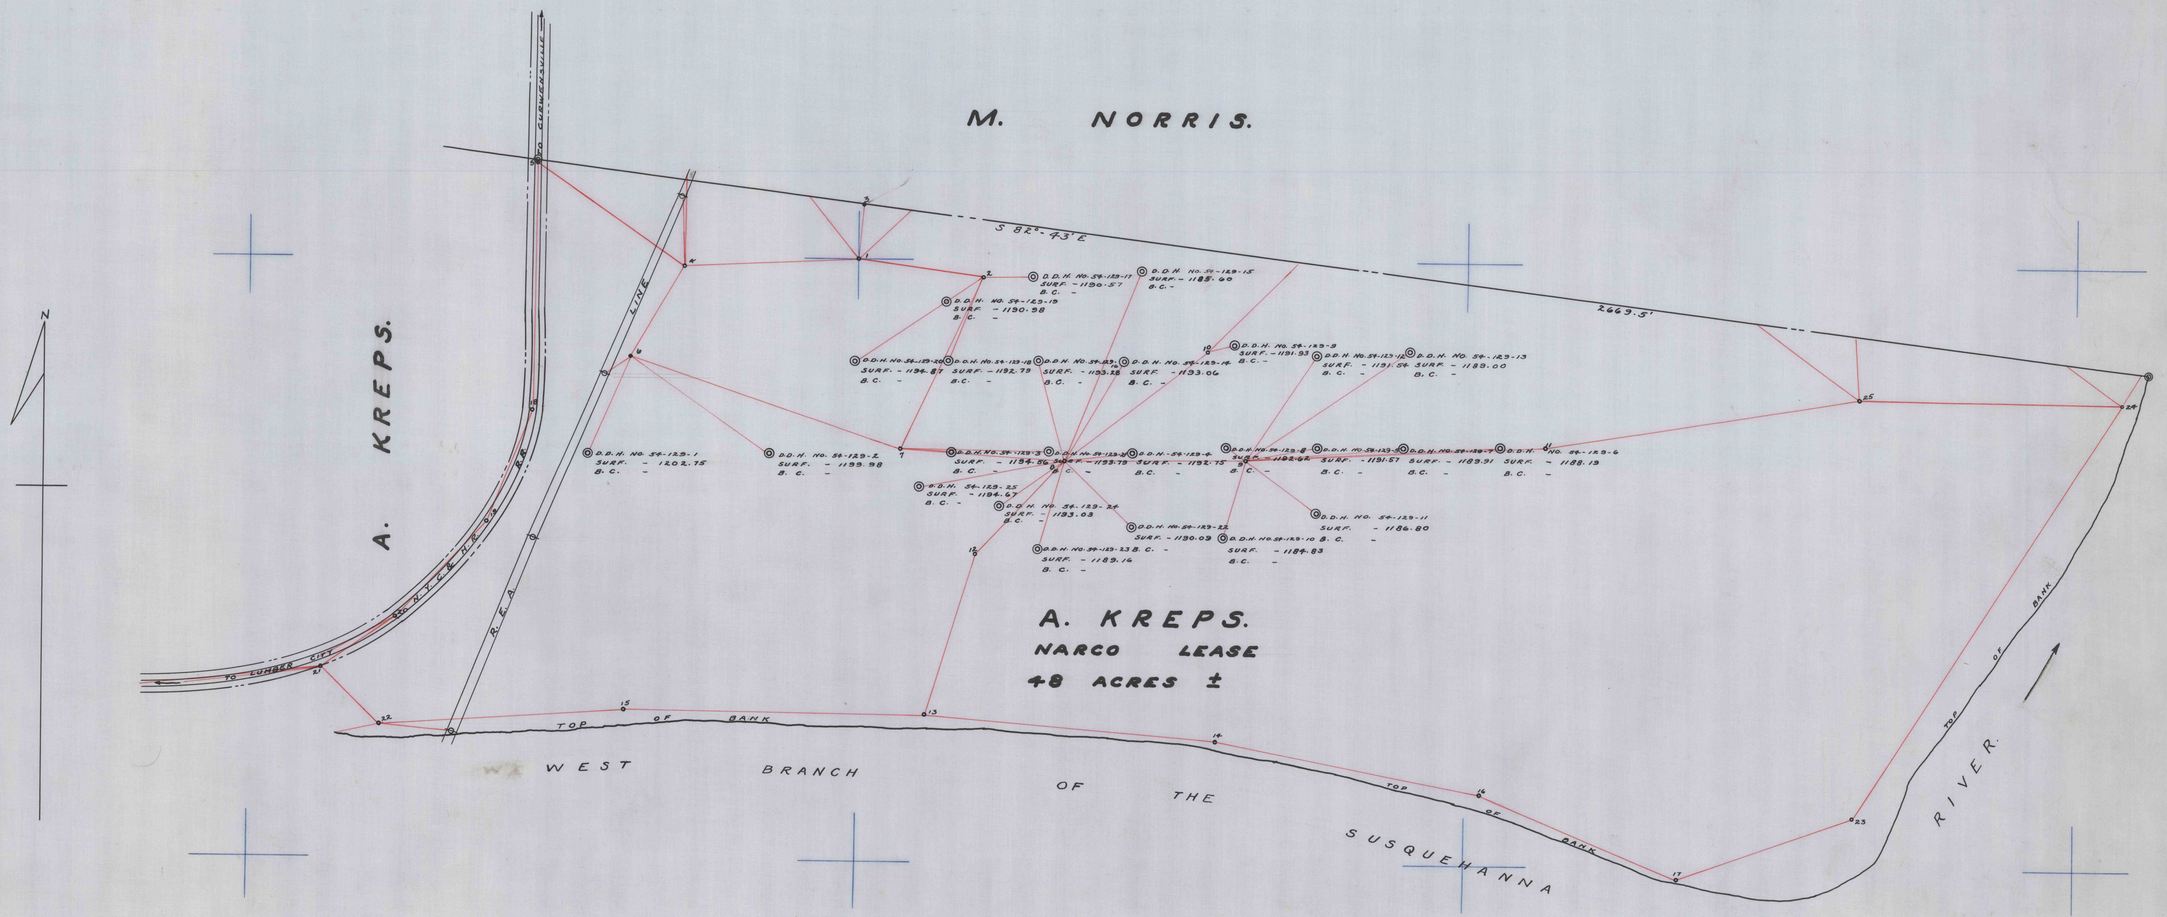

NORTH AMERICAN REFRACTORIES CO.
CLEVELAND, OHIO

MAP SHOWING 1954 DRILLING ON A. KREPS PROPERTY, LUMBER CITY, PA.

SCALE: 1" = 100'
DRAWN: J.R.H., Jr.
DATE: AUGUST 6, 1954
CHECKED:

NOTE BOOK No. 257 - Pgs. 29 to 35

INDEX No. — 50-3-1254