


JOHN WELLS

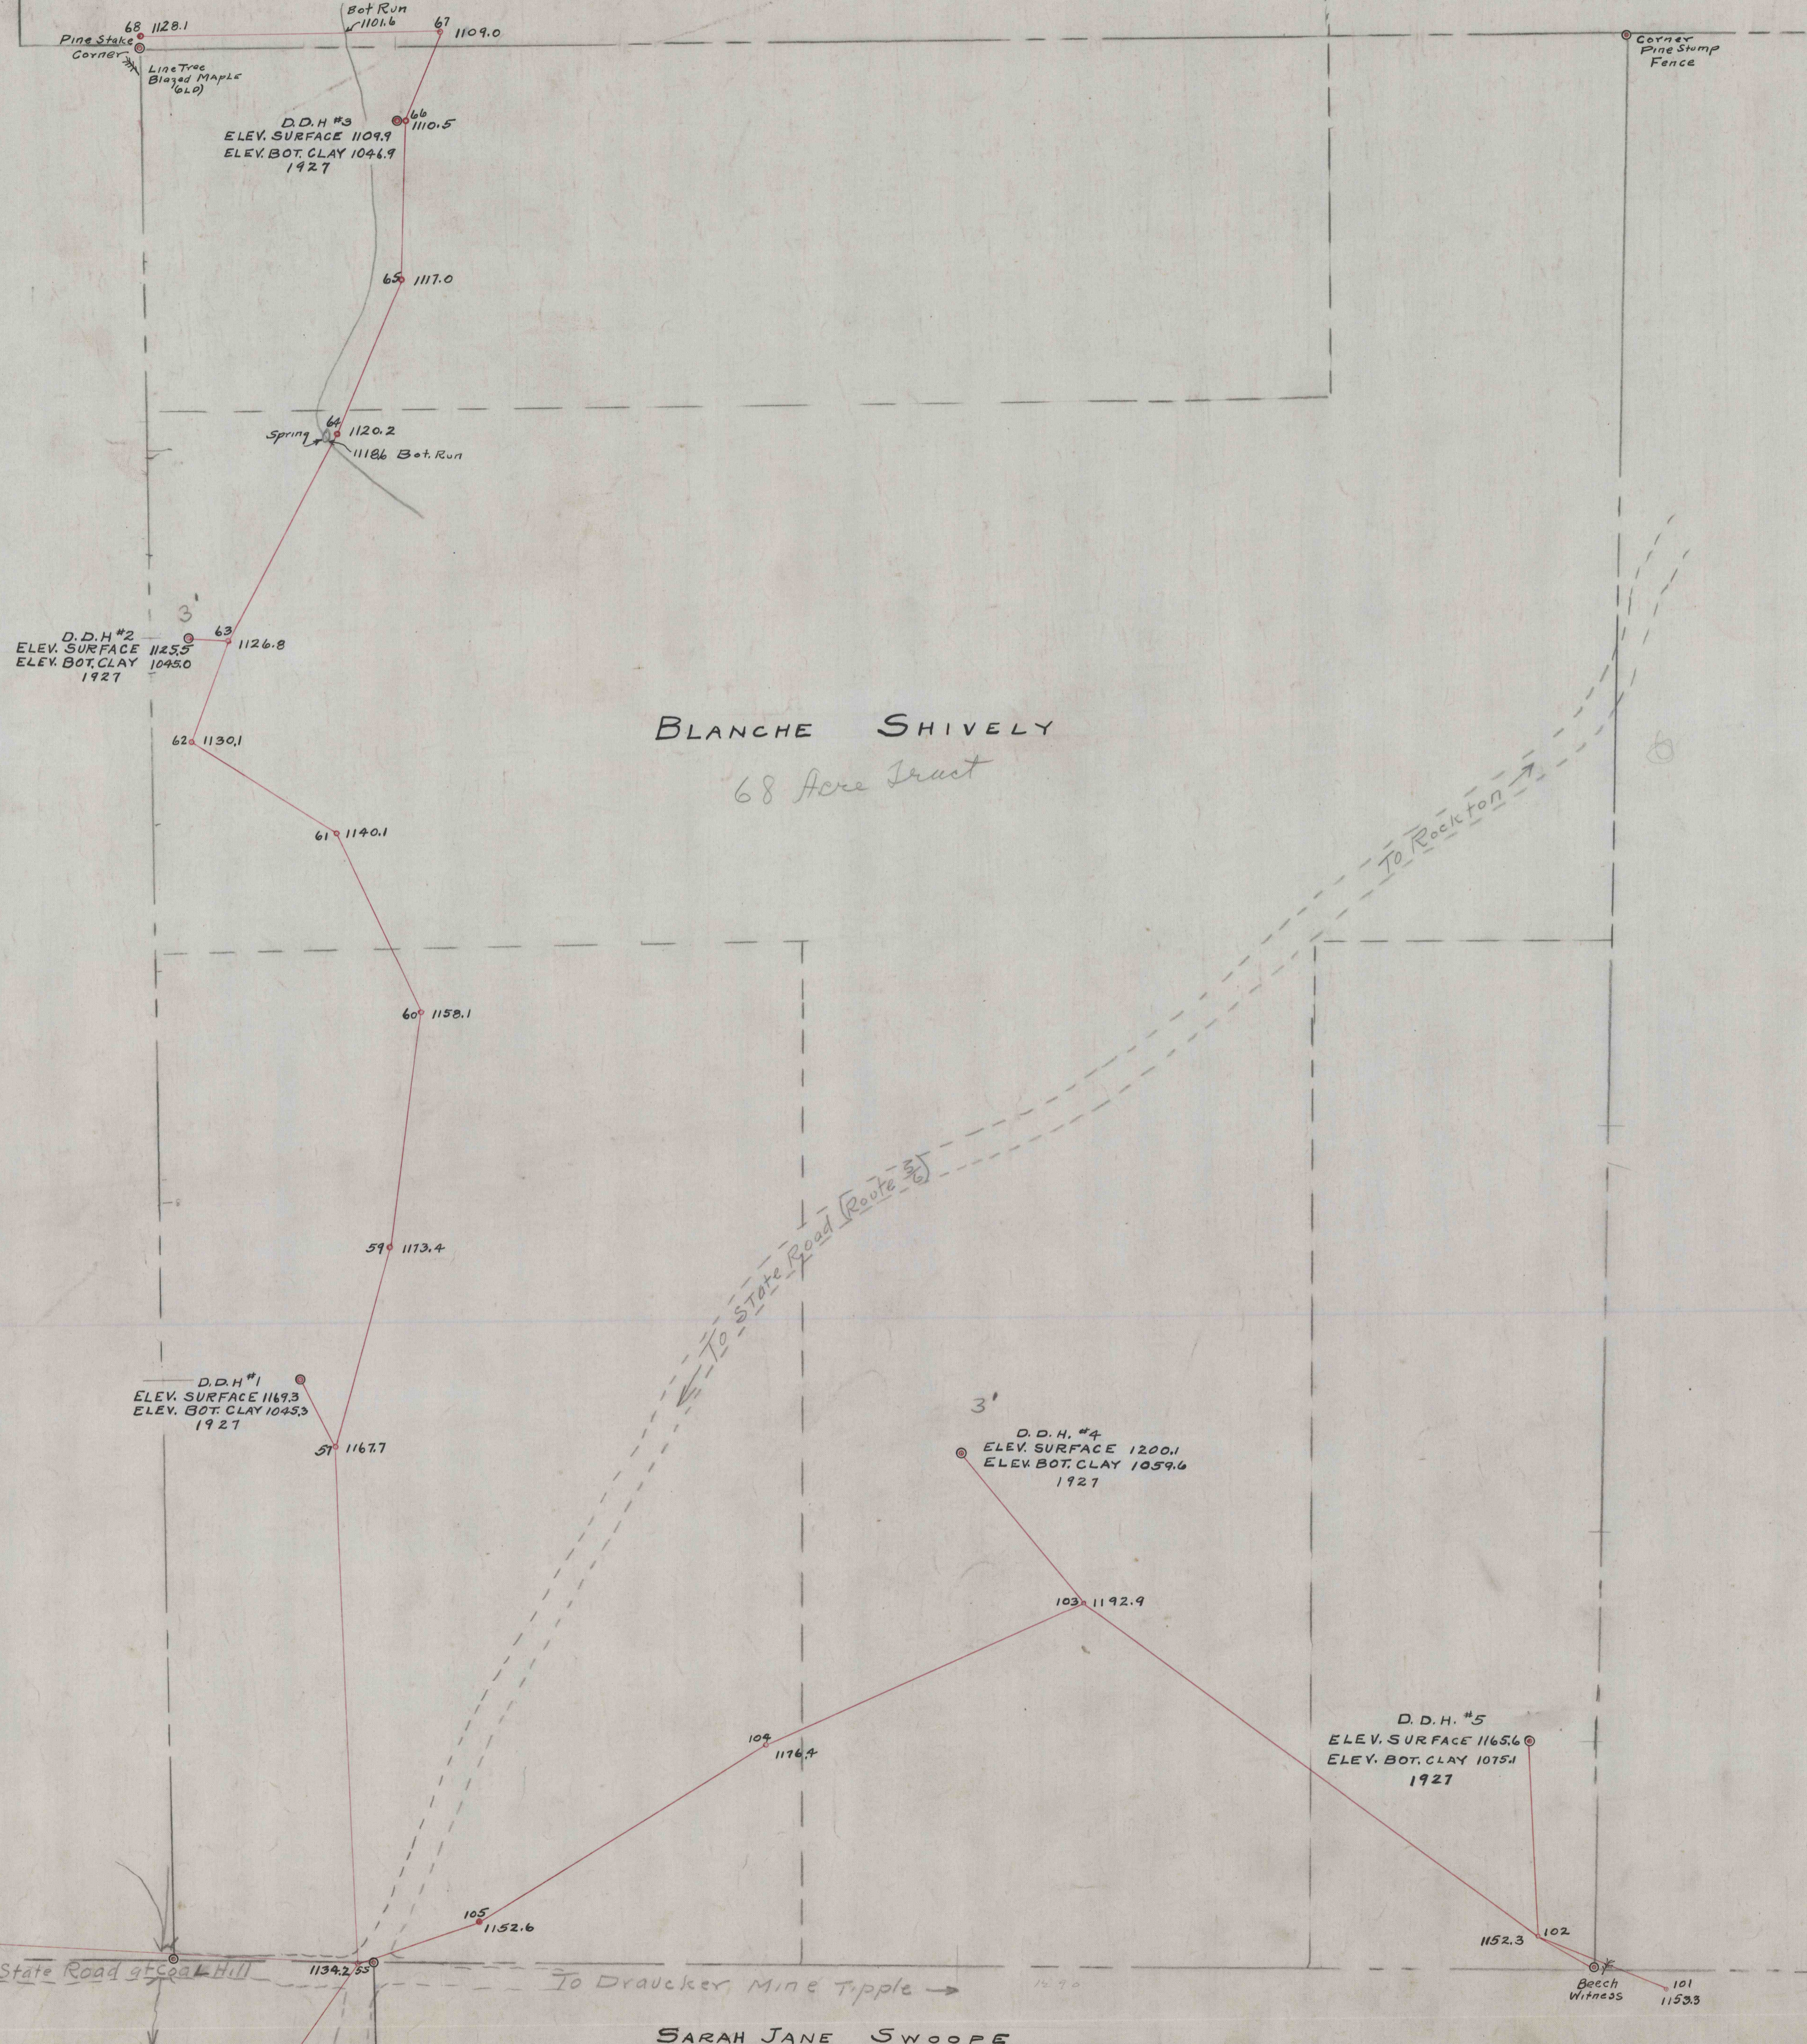

LOUISE SHIVELY

BLANCHE SHIVELY
68 Acre Tract

E.W. HOLLIPETER

JOHN NEELEY

SARAH JANE SWOOPE

NOTE:-
ELEVATIONS TAKEN FROM
DATUM AT DRAUCKER MINE.

CRESCENT REFRACTORIES CO.
CURWENSVILLE, CLEARFIELD COUNTY, PA.
ENGINEERING DEPARTMENT

MAP SHOWING THE LOCATION OF
DIAMOND DRILL HOLES ON THE
PROPERTY OF BLANCHE SHIVELY

DRAWN <i>R.I.</i>	SCALE 1" = 100'	1076 I
CHECKED	DATE 10-27-27	5-3-138
REFERENCE	ORDER	

MARGARET RENTZ