

DDH #4
2'-6"

D.D.H. #7
3'

JOHN WELLS


Record Under Wells

1137.6 79
Bot. Run 1136.0
Fence Corner

Corner Pine stump Fence

D.D.H. #5
SURF. 1184.7
CLAY 1064.7

800 1135.9

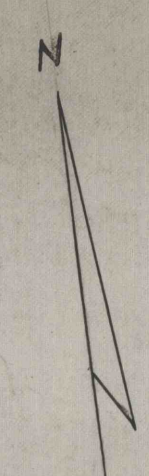

To Rockton

4'-
81 1131.8

D.D.H. #1
ELEV. SURFACE 1131.9
ELEV. BOT. CLAY 1078.4
1927

OLD D.D.H.
ELEV. SURFACE 1122.4
82

To State Road (Route 5)

1113.6 83

84 1110.6

Bot. Run 1103.7

Bot. Run 1101.4

OLD D.D.H.
GOOD CLAY

87 1113.3

88 1118.0

BLANCHE SHIVELY

E. W. HOLLIPETER

CLAY 43 acres.
4'-6"

89 1124.0

W B K I R K

D.D.H. #3
ELEV. SURFACE 1159.3
ELEV. BOT. CLAY 1089.8
1927
Faulty Measure No Core

NOTE:-

ELEVATIONS TAKEN FROM DATUM AT DRAUCKER MINE.

Cleared

D.D.H. #2
ELEV. SURFACE 1172.4
ELEV. BOT. CLAY 1098.4
1927
Faulty Measure No Core

90 1169.1

Blazed Beech Witness Corner Stake Pulled out recently
91 1190.4

WOODS

DDH #5 SANDY

5' GOOD CLAY
OLD D.D.H.
APPR. SUR. 1206.

95 1191.2

102
Beech Witness Corner not Marked
101 1153.3

Wire Fence (Down)

98 1206.1

97 1206.1

SARAH JANE SWOOPÉ

MRS. MARGARET PENTZ

DDH #2
3' SANDY

CRESCENT REFRACTORIES CO.
CURWENSVILLE, CLEARFIELD COUNTY, PA.
ENGINEERING DEPARTMENT

MAP SHOWING THE LOCATION OF DIAMOND DRILL HOLES ON THE PROPERTY OF E.W. HOLLIPETER.

DRAWN R.S.Z.
CHECKED
REFERENCE

SCALE 1"=100 FT.
DATE 10-28-27
ORDER 50-3-140

1077-I