

SHARON FIRE BRICK CO.


CALVIN J. BILGER

HANNA J. THOMAS EST  
(HOMESTEAD TRACT).

D.S. SOLLEY

ISAAC BLOOM

ELEVATIONS:—  
DATUM - G.H. WISE  
100 ACRE TRACT.

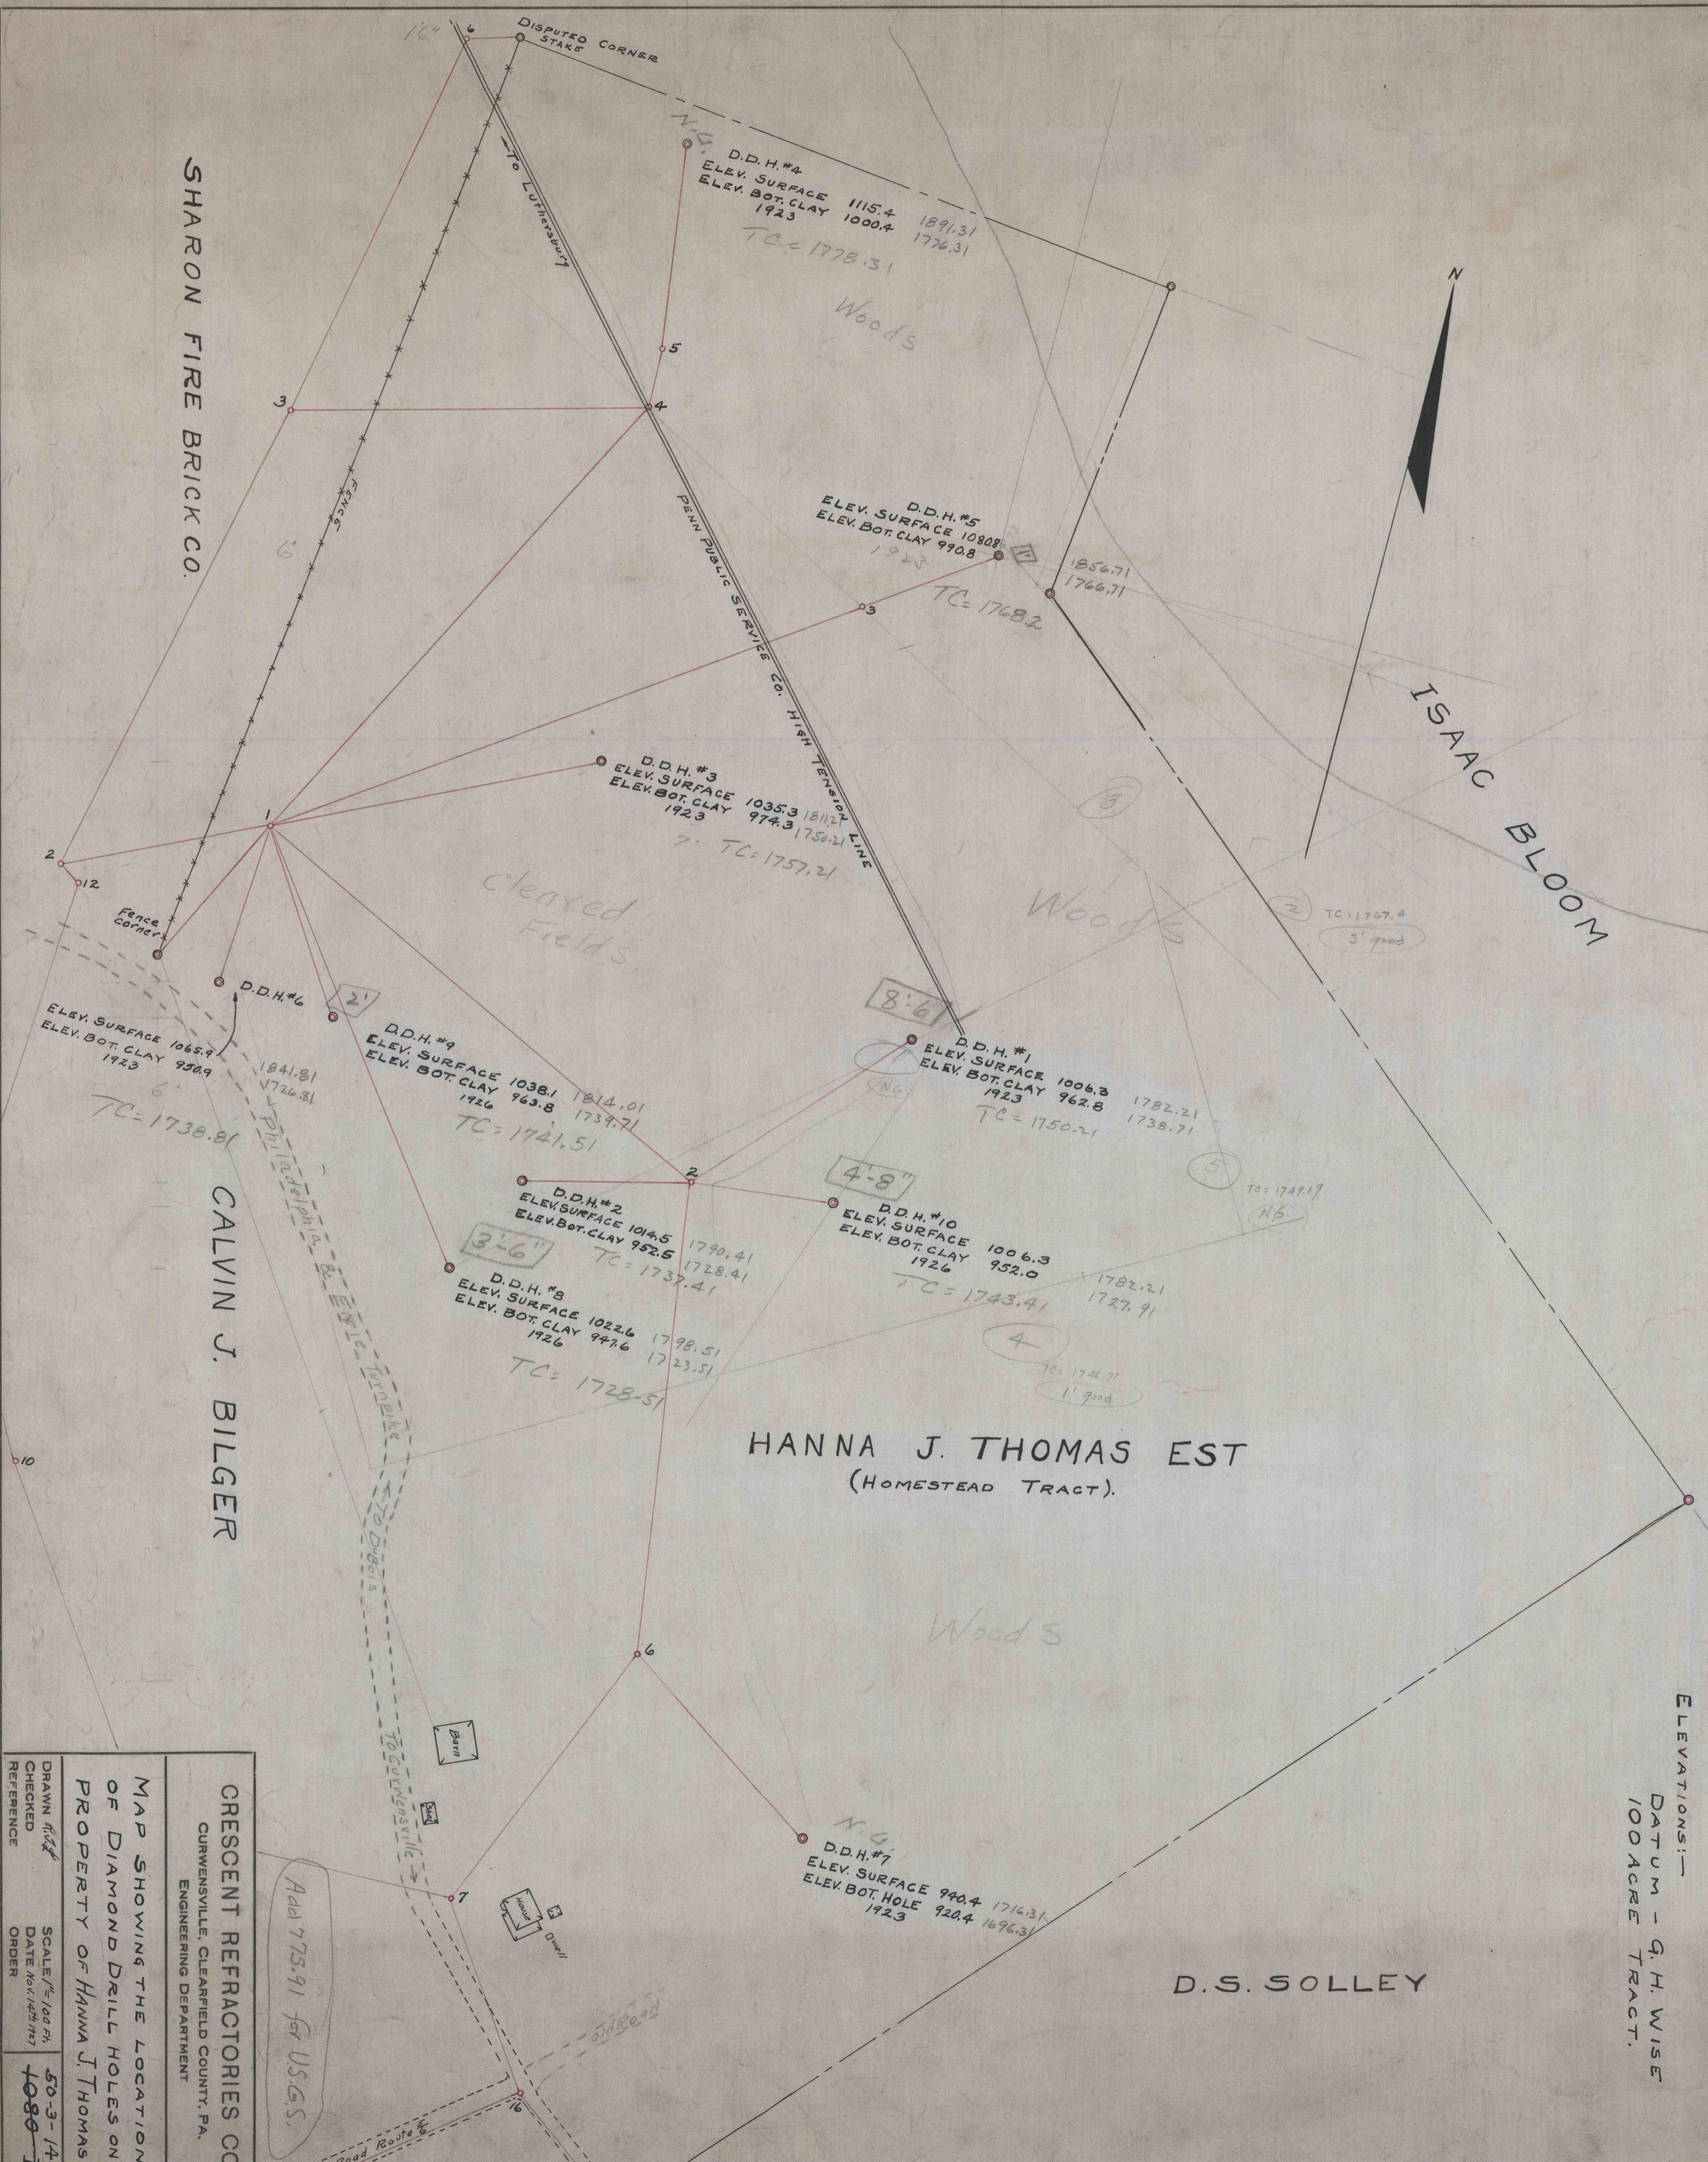

CRESCENT REFRACTORIES CO.  
CURWENSVILLE, CLEARFIELD COUNTY, PA.  
ENGINEERING DEPARTMENT

MAP SHOWING THE LOCATION OF DIAMOND DRILL HOLES ON THE PROPERTY OF HANNA J. THOMAS EST.

DRAWN BY: [Signature]  
CHECKED: [Signature]  
REFERENCE:

SCALE: 1" = 100 FT.  
DATE: Nov. 14, 1957  
ORDER: 50-3-146  
1080-I

Add 775.91 for U.S.G.S.