

Hanna J. Thomas Est  
Homestead Tract

Swampy

Swampy

LEVI THOMAS

C. J. BILGER

D. S. SOLLY

NOTE:-  
PROPERTY LINES ARE  
PLOTTED FROM DESCRIPTION

McCall Heirs



ISAAC THOMAS

L. H. WEBER

HARRY BICKEL

D.D.H.#1  
ELEV. SURFACE 949.8  
ELEV. BOT. CLAY 867.9

14  
D.D.H.#2  
ELEV. SURFACE 961.0  
ELEV. BOT. CLAY 866.0

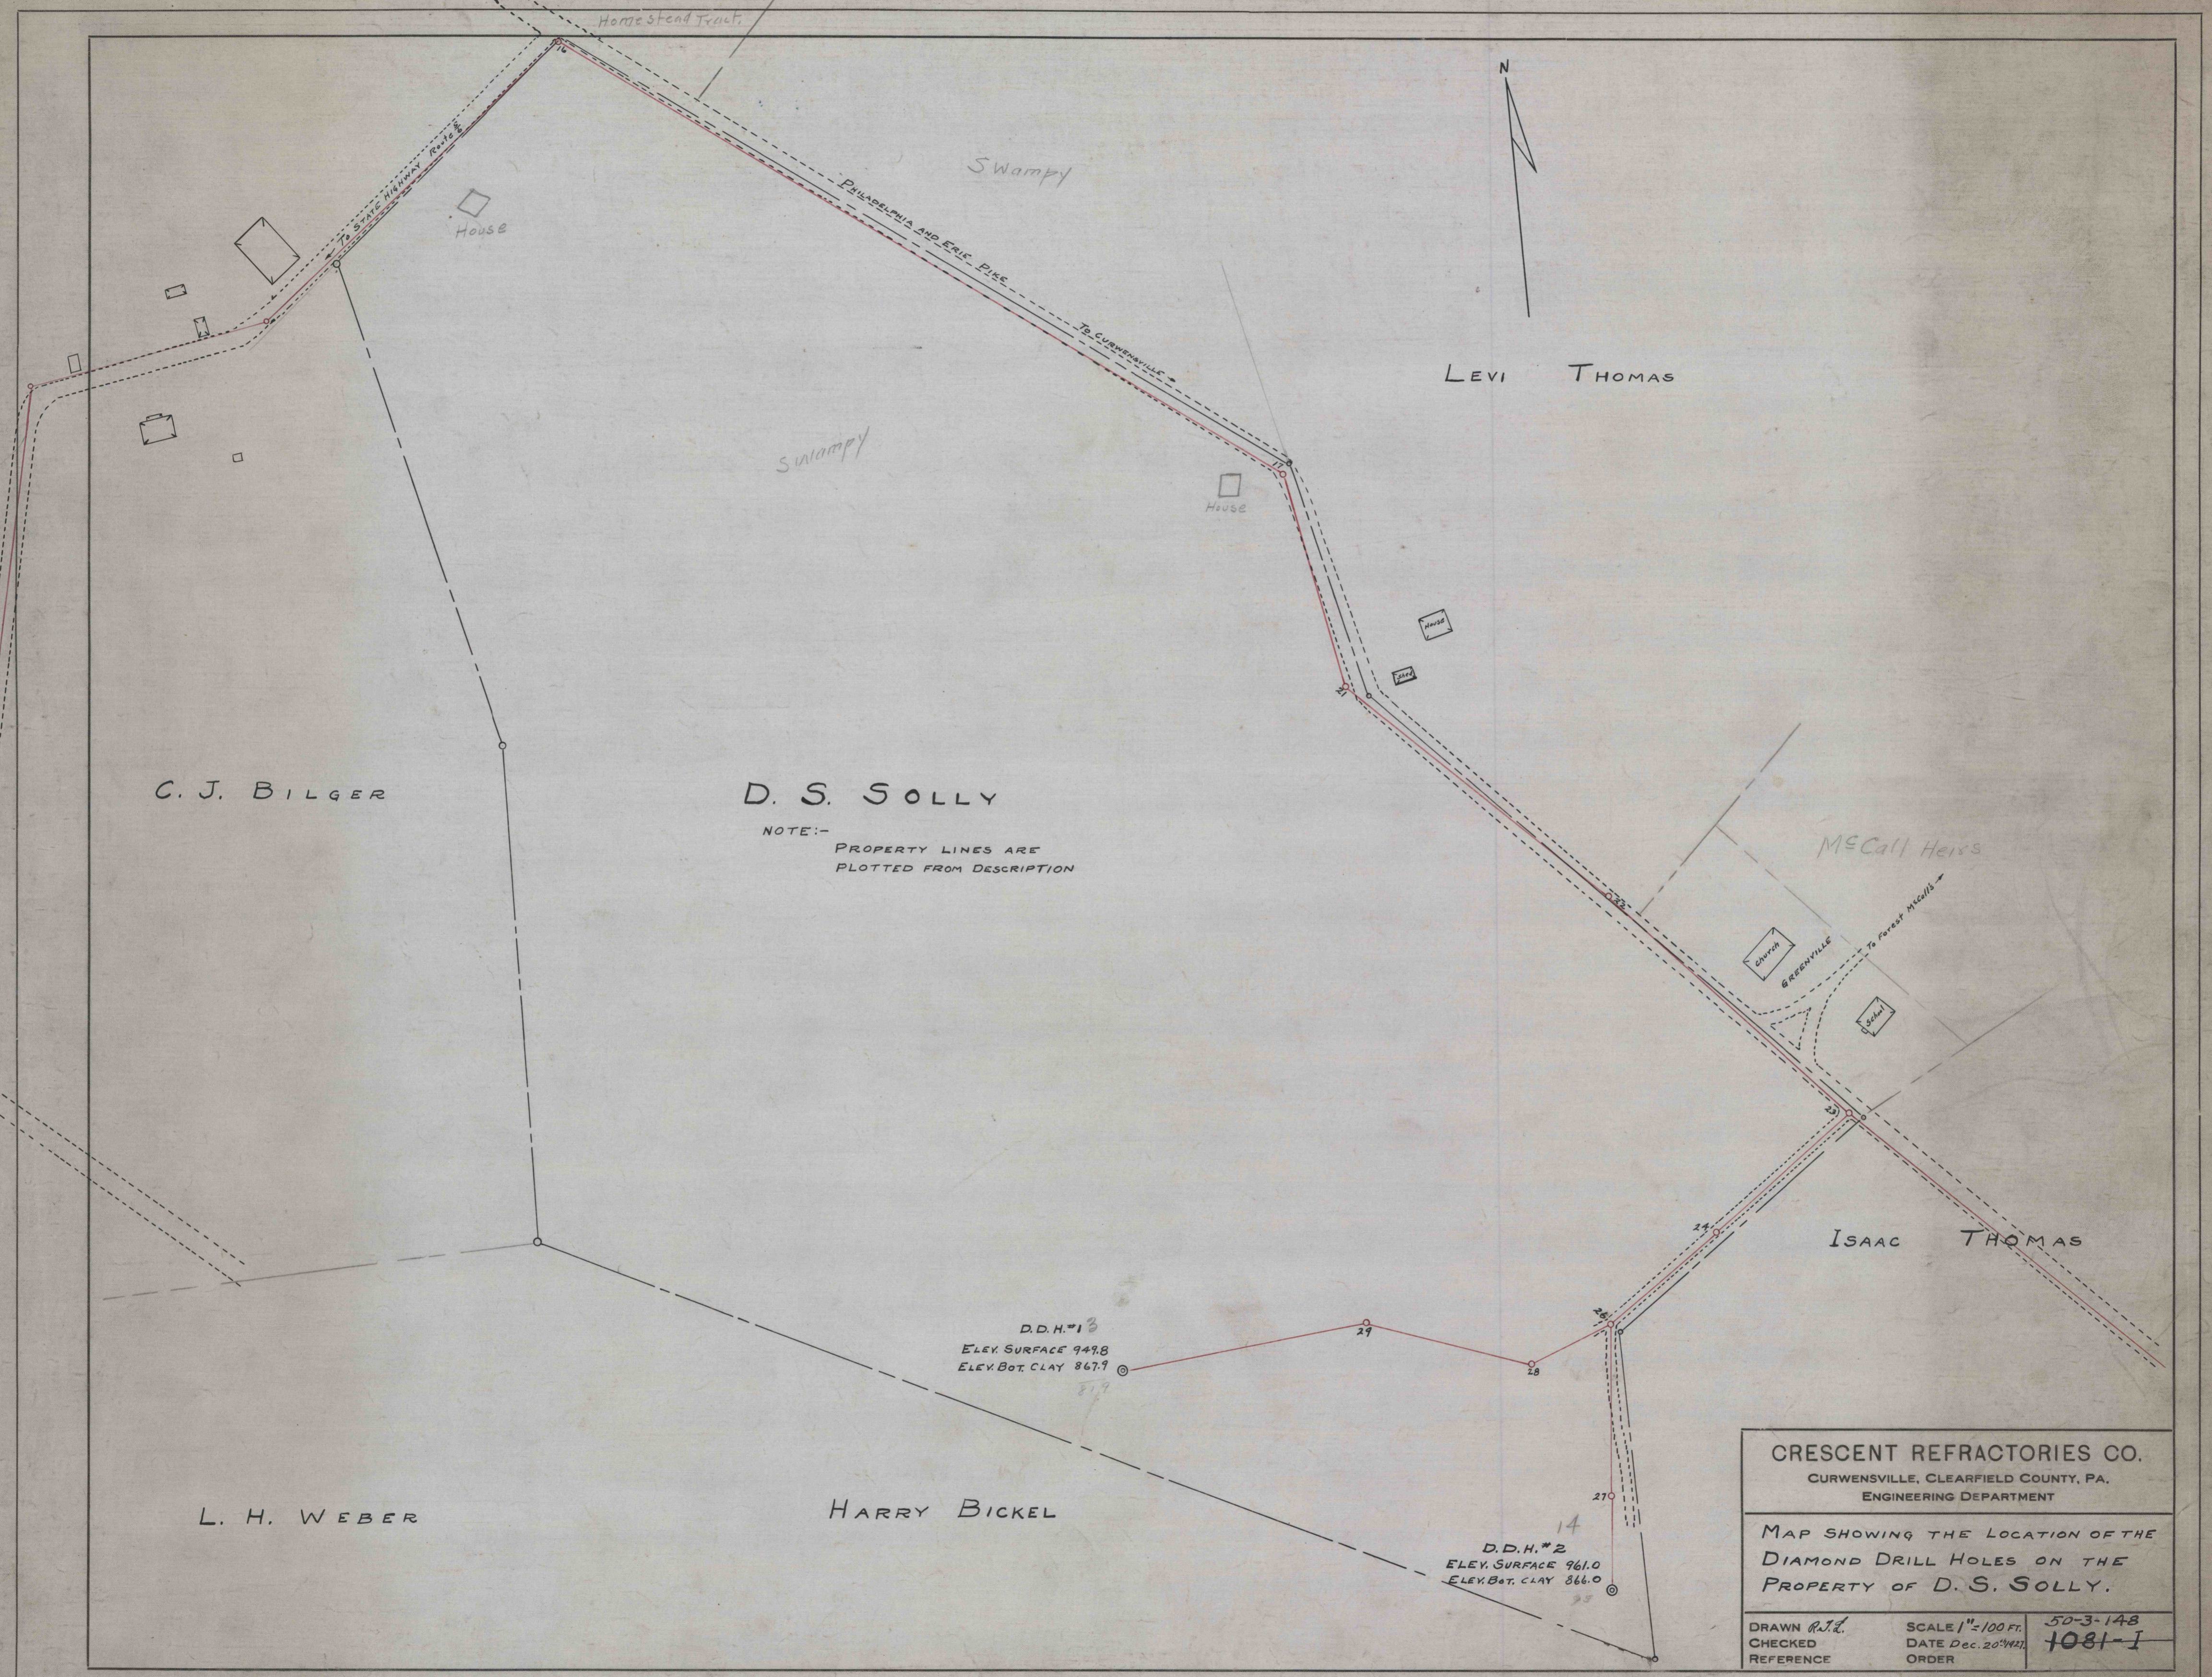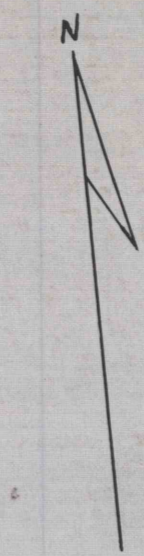

CRESCENT REFRACTORIES CO.		
CURWENSVILLE, CLEARFIELD COUNTY, PA.		
ENGINEERING DEPARTMENT		
MAP SHOWING THE LOCATION OF THE DIAMOND DRILL HOLES ON THE PROPERTY OF D. S. SOLLY.		
DRAWN <i>R.T.L.</i>	SCALE 1"=100 Ft.	50-3-148
CHECKED	DATE Dec. 20th 1921	1081-1
REFERENCE	ORDER	