

PHILOMENA DUFOUR

HARRISON SHAFFER

D.D.H.#3
ELEV. SURFACE 938.6
ELEV. BOT. CLAY 775.6

D.D.H.#4
ELEV. SURFACE 940.5
ELEV. BOT. CLAY 805.5

D.D.H.#1
ELEV. SURFACE 988.7
ELEV. BOT. CLAY 870.7

D.D.H.#2
ELEV. SURFACE 981.9
ELEV. BOT. CLAY 845.9

WARREN CHARLES

NOTE:-
PROPERTY LINES PLOTTED
FROM DESCRIPTION.

PERCY HOLTON

KENDALL

C. HARTZFELT

IRA DUNSWORTH

IRA DUNSWORTH


JOS. KORB

VINCENT SWOPERT

TO CURWENSVILLE →

← TO D'BOIS

STATE HIGHWAY
ROUTE 5

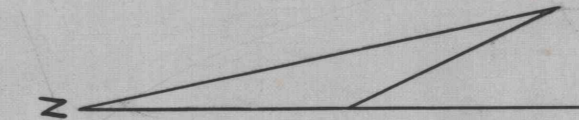

CRESCENT REFRACTORIES CO. CURWENSVILLE, CLEARFIELD COUNTY, PA. ENGINEERING DEPARTMENT		
MAP SHOWING THE LOCATION OF DIAMOND DRILL HOLES ON THE PROPERTY OF WARREN CHARLES.		
DRAWN R.J.L.	SCALE 1"=100 FT.	50-3-150
CHECKED	DATE Dec. 21/1921	1082-1
REFERENCE	ORDER	

50-3-150