


EMILY RHINEHART EST.
NARCO CLAY LEASE
30 A. ±

HAROLD GRAHAM
NARCO CLAY LEASE
22 A. ±

JAMES & JANET CARR
NARCO CLAY LEASE
101 A. ±

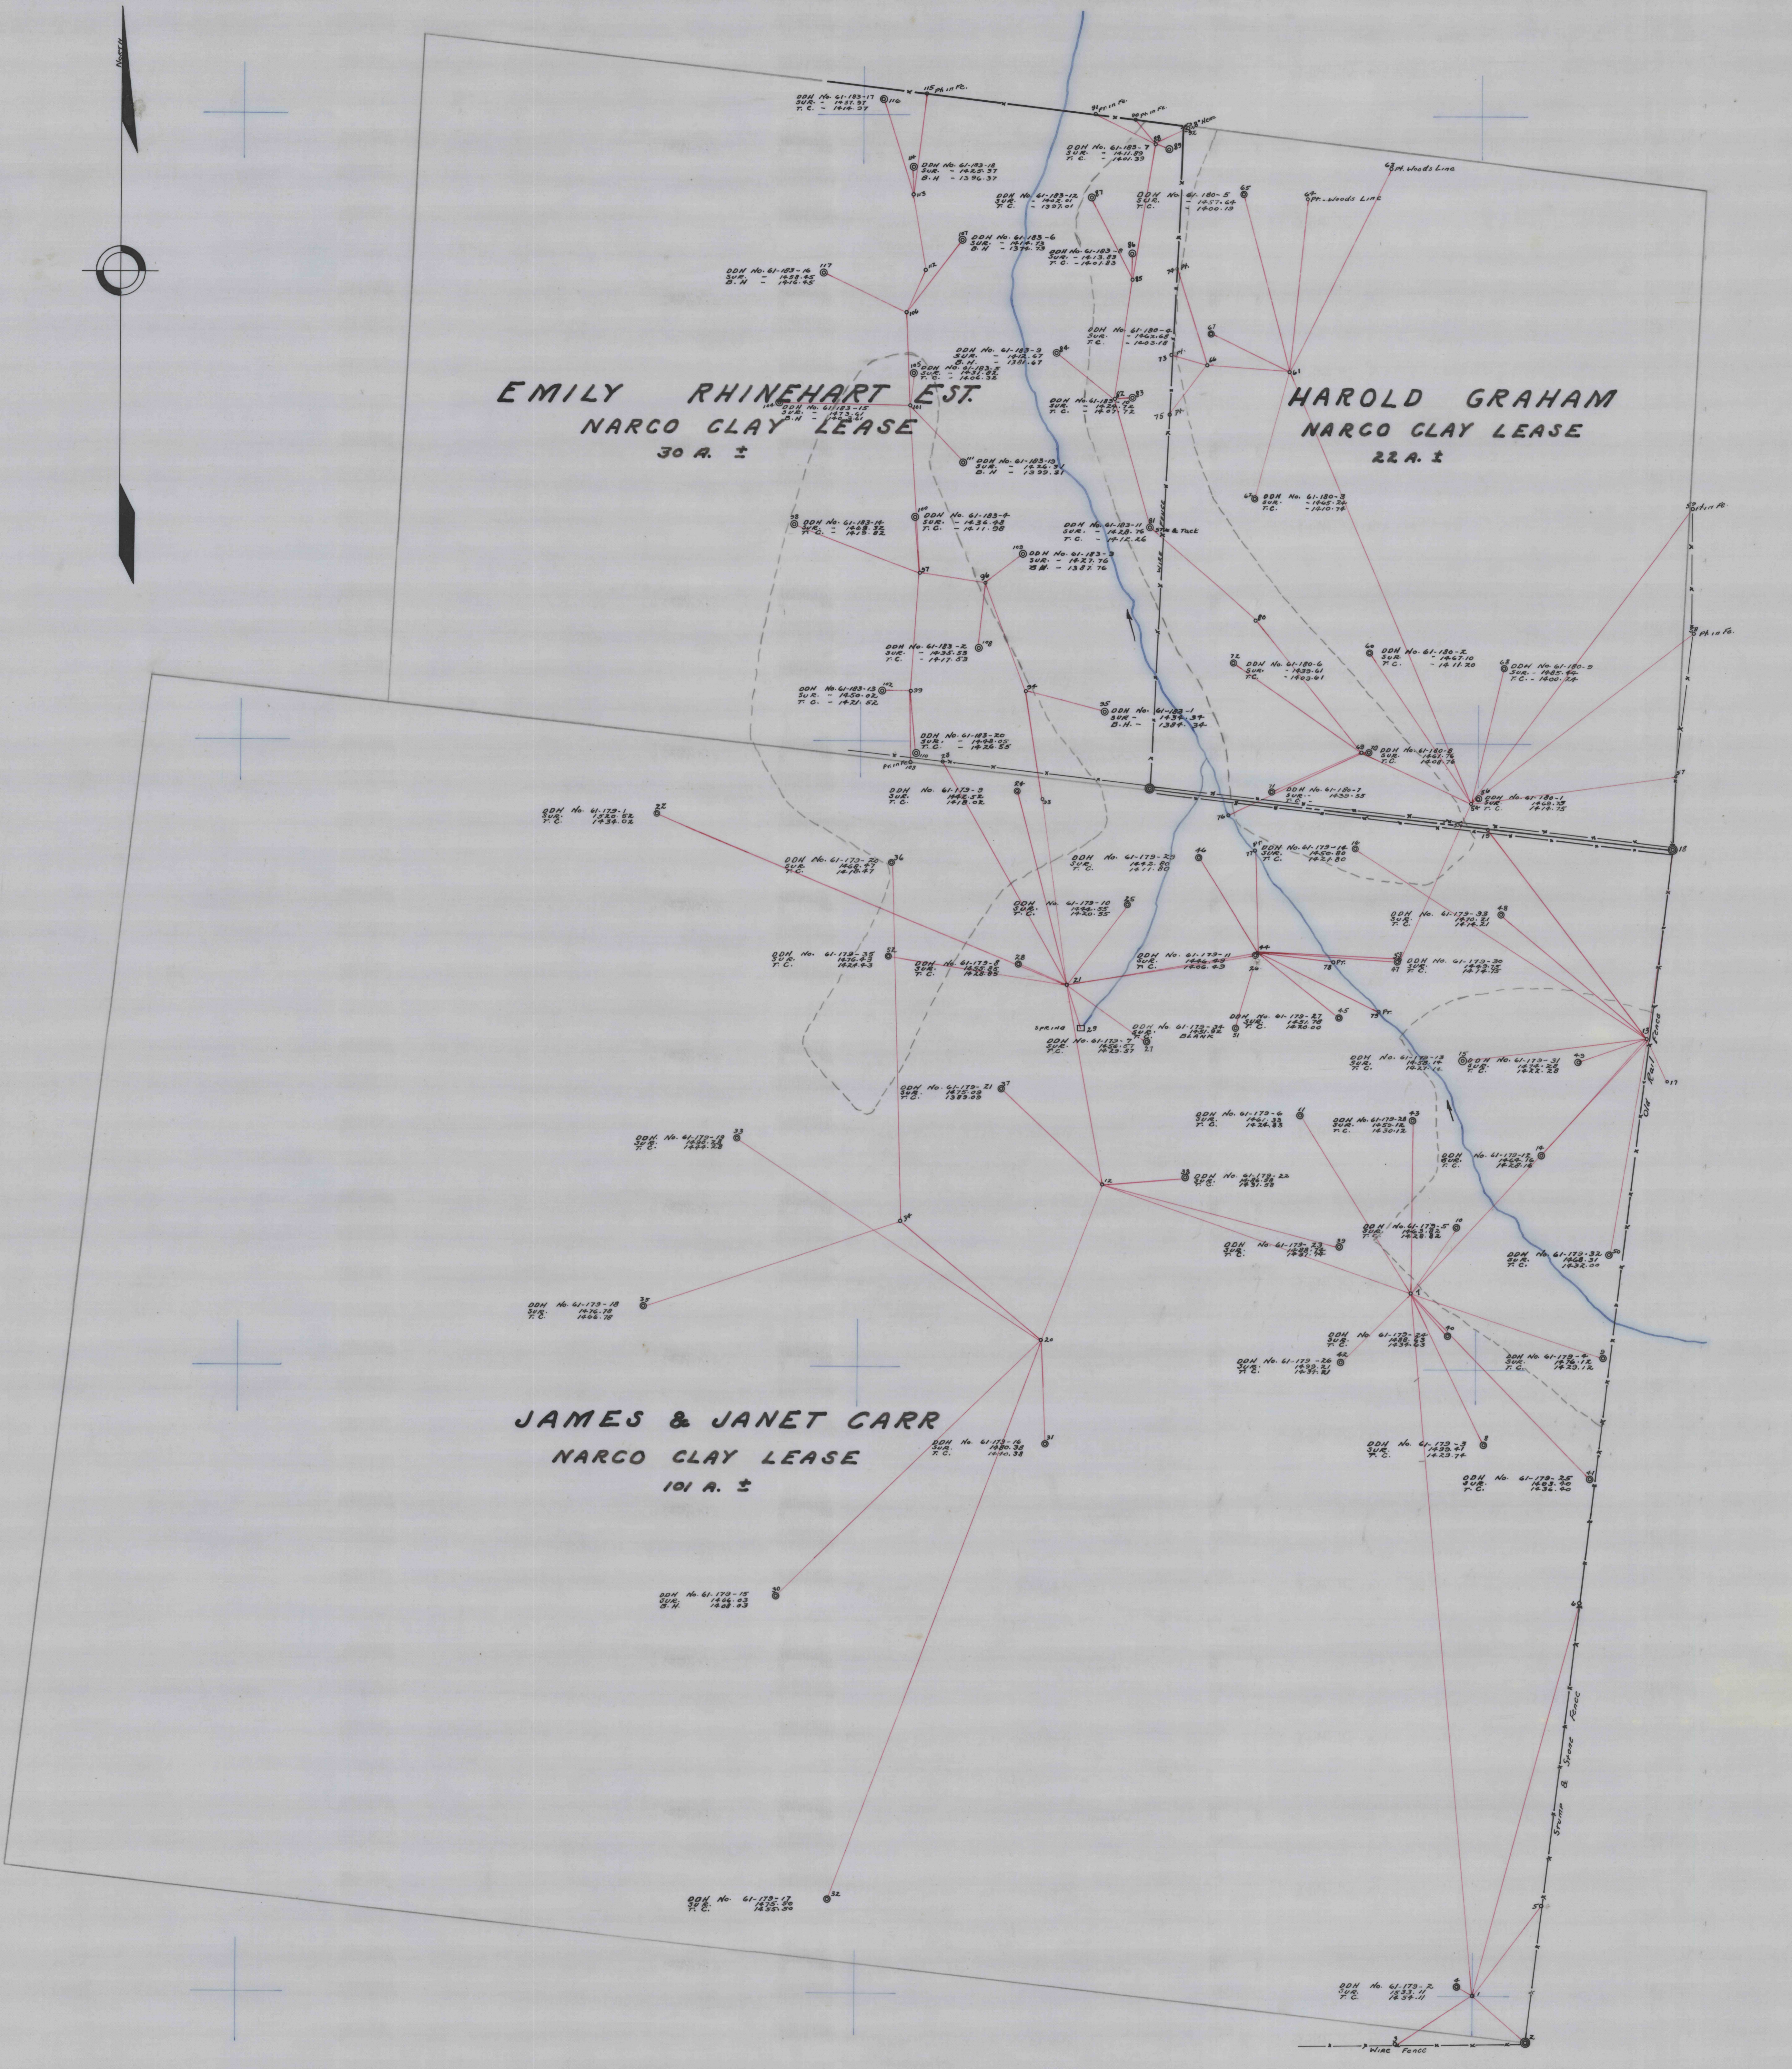

NORTH AMERICAN REFRACTORIES CO.
CLEVELAND, OHIO.

MAP SHOWING 1961 DRILLING ON
CARR, GRAHAM & RHINEHART TRACTS.
GRAHAM TOWNSHIP, CLEARFIELD CO., PENNSYLVANIA
SCALE: 1" = 100 FT. DRAWN: J.R.H., Jr. CHECKED: _____, 1961
DRAWN FROM SURVEYS - N.B. No. 281.

INDEX No. 50-3-1518