

MARY E. WOLFE

FENCE
14 CORNER

VERDA M. KNEPP SURFACE
WILLIAM MEASE EST. MINERALS

VERDA M. KNEPP

CLYDE DUNLAP SUR.
WILLIAM MEASE EST. MIN.


WM. MEASE EST.

MORRIS TOWNSHIP
ALVIE COWDER

GRAHAM TOWNSHIP

SYLVESTER & DOROTHY MAY SMEAL

NORTH AMERICAN REFRACTORIES COMPANY
CLEVELAND 14, OHIO
MAP SHOWING
DRILL HOLE LOCATIONS
ON CLYDE DUNLAP PROPERTY
LOCATED IN BOGGS TWP. CLFD. CO.
SCALE 1" = 100'
DRAWN 12-13-61 J.C.M. APPROVED
INDEX No. 50-3-1520

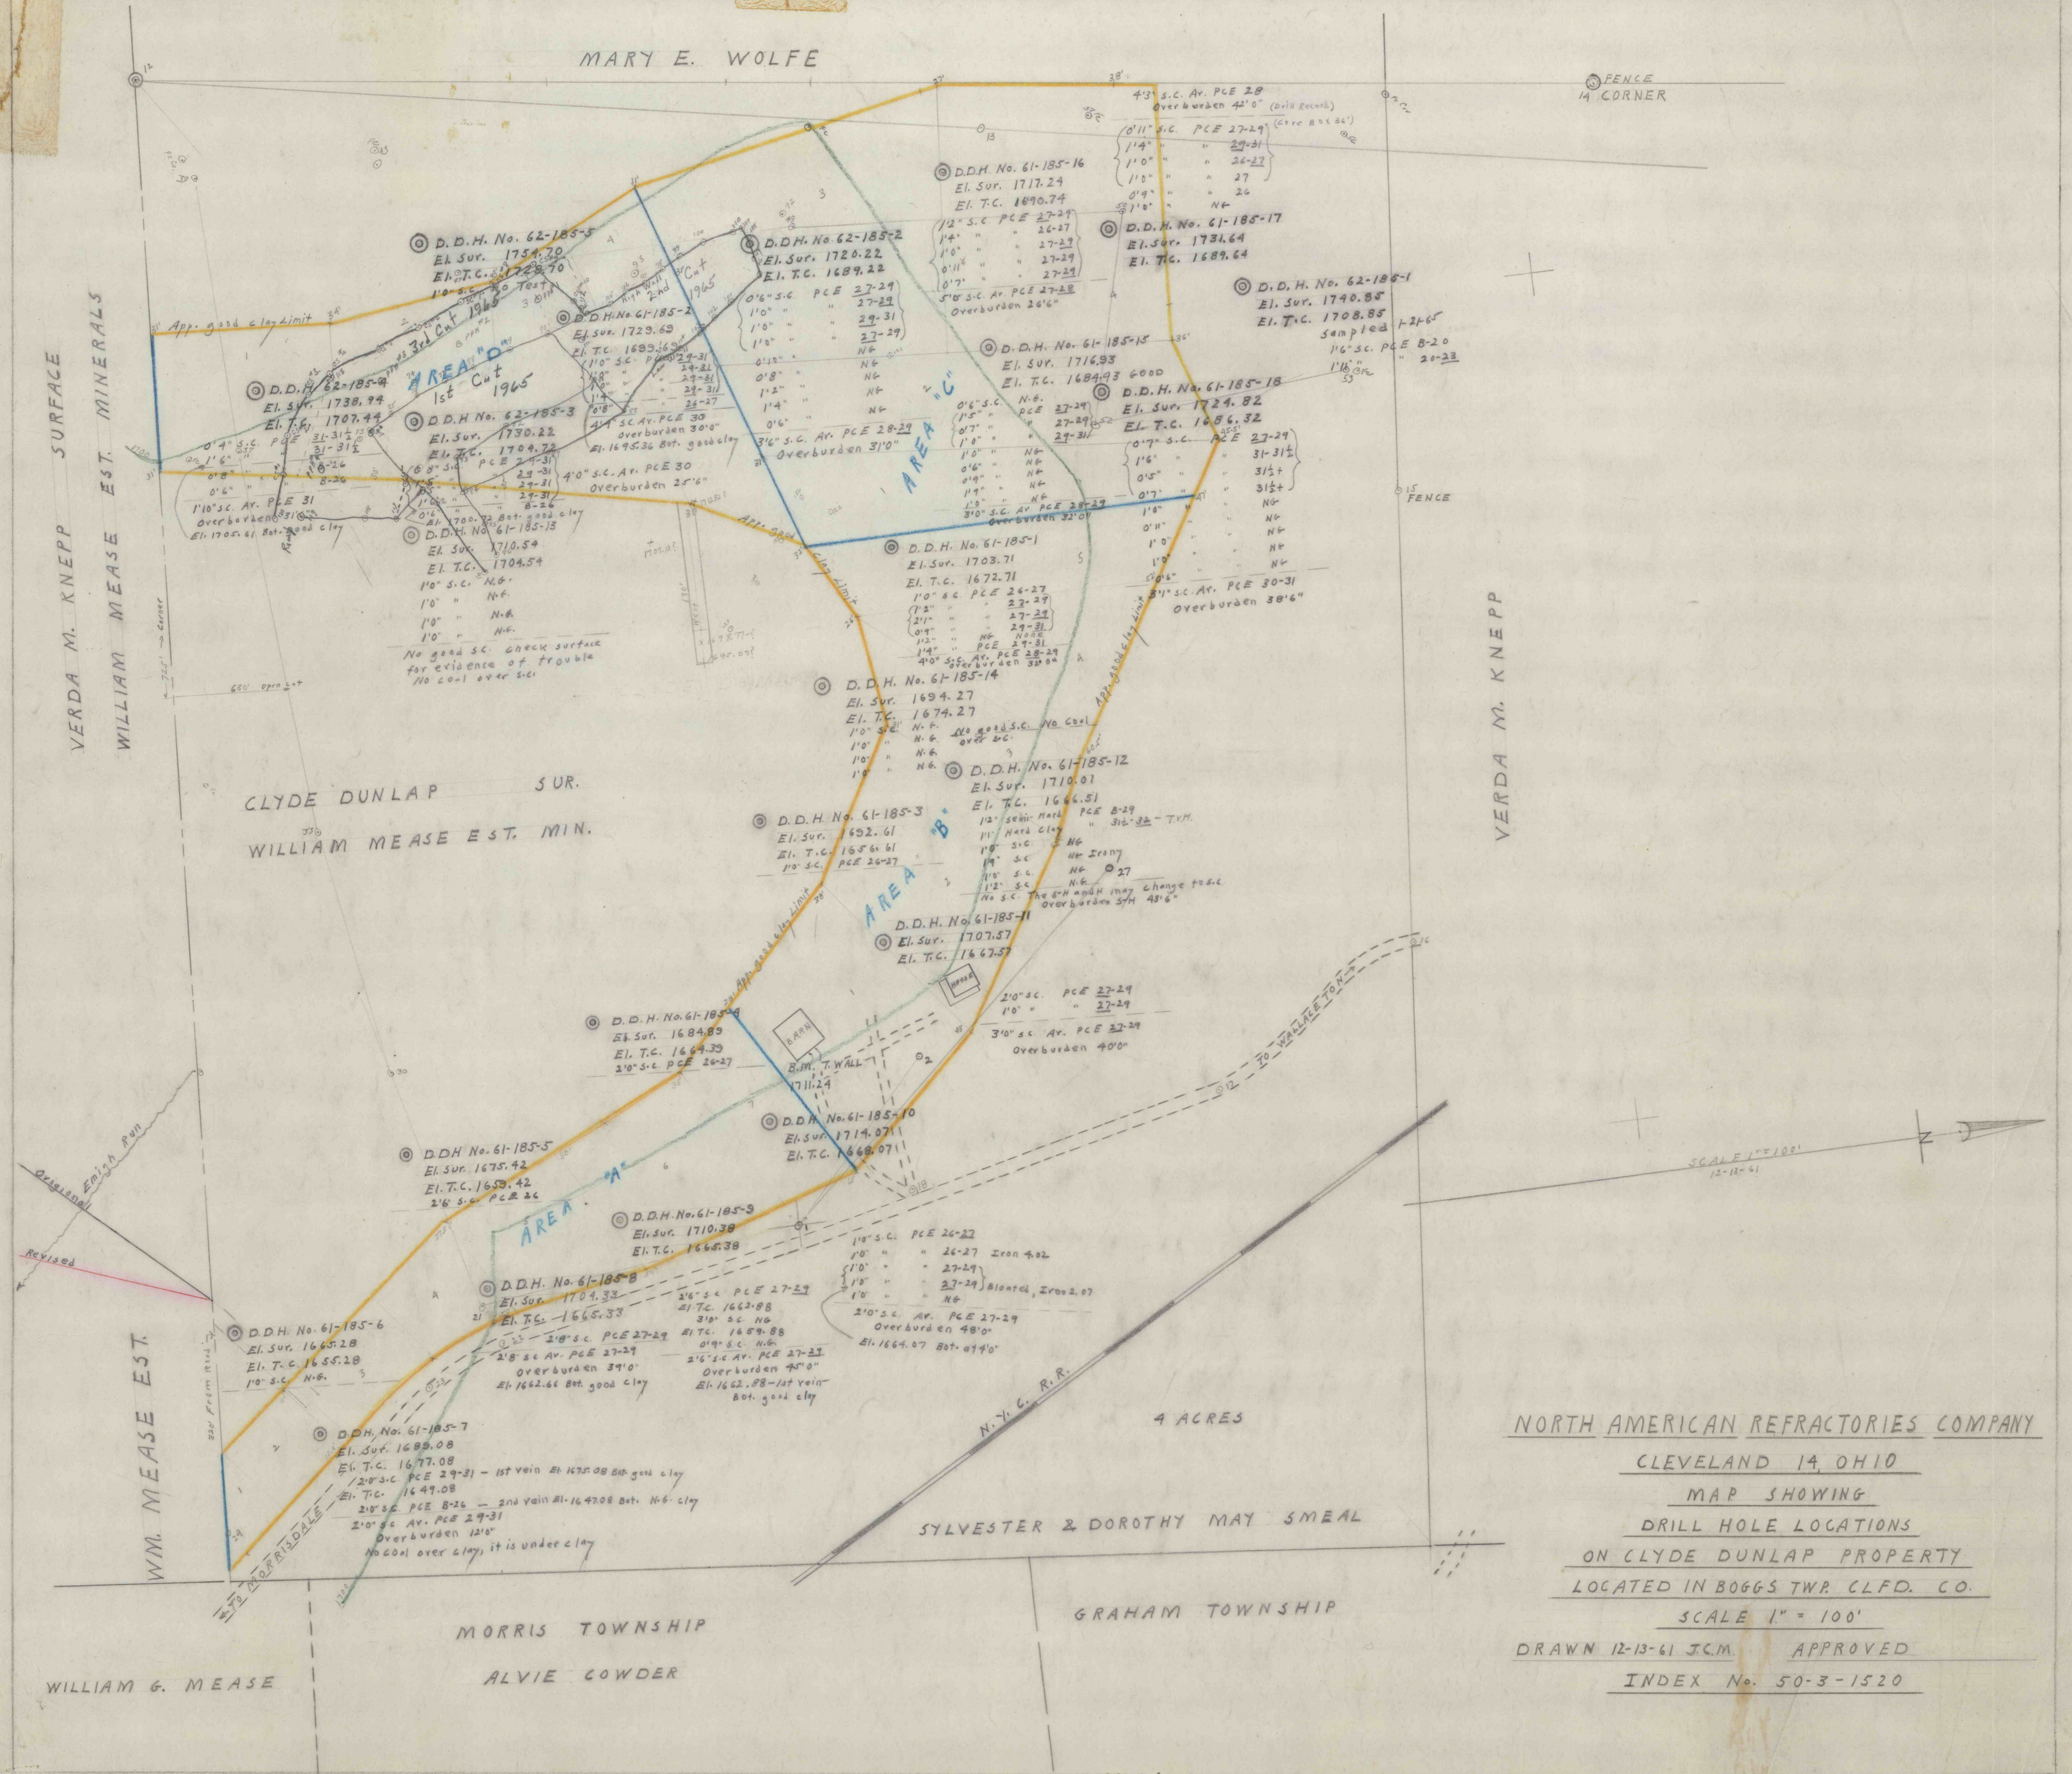

50-3-1520

50-3-1520 BERN-0508