
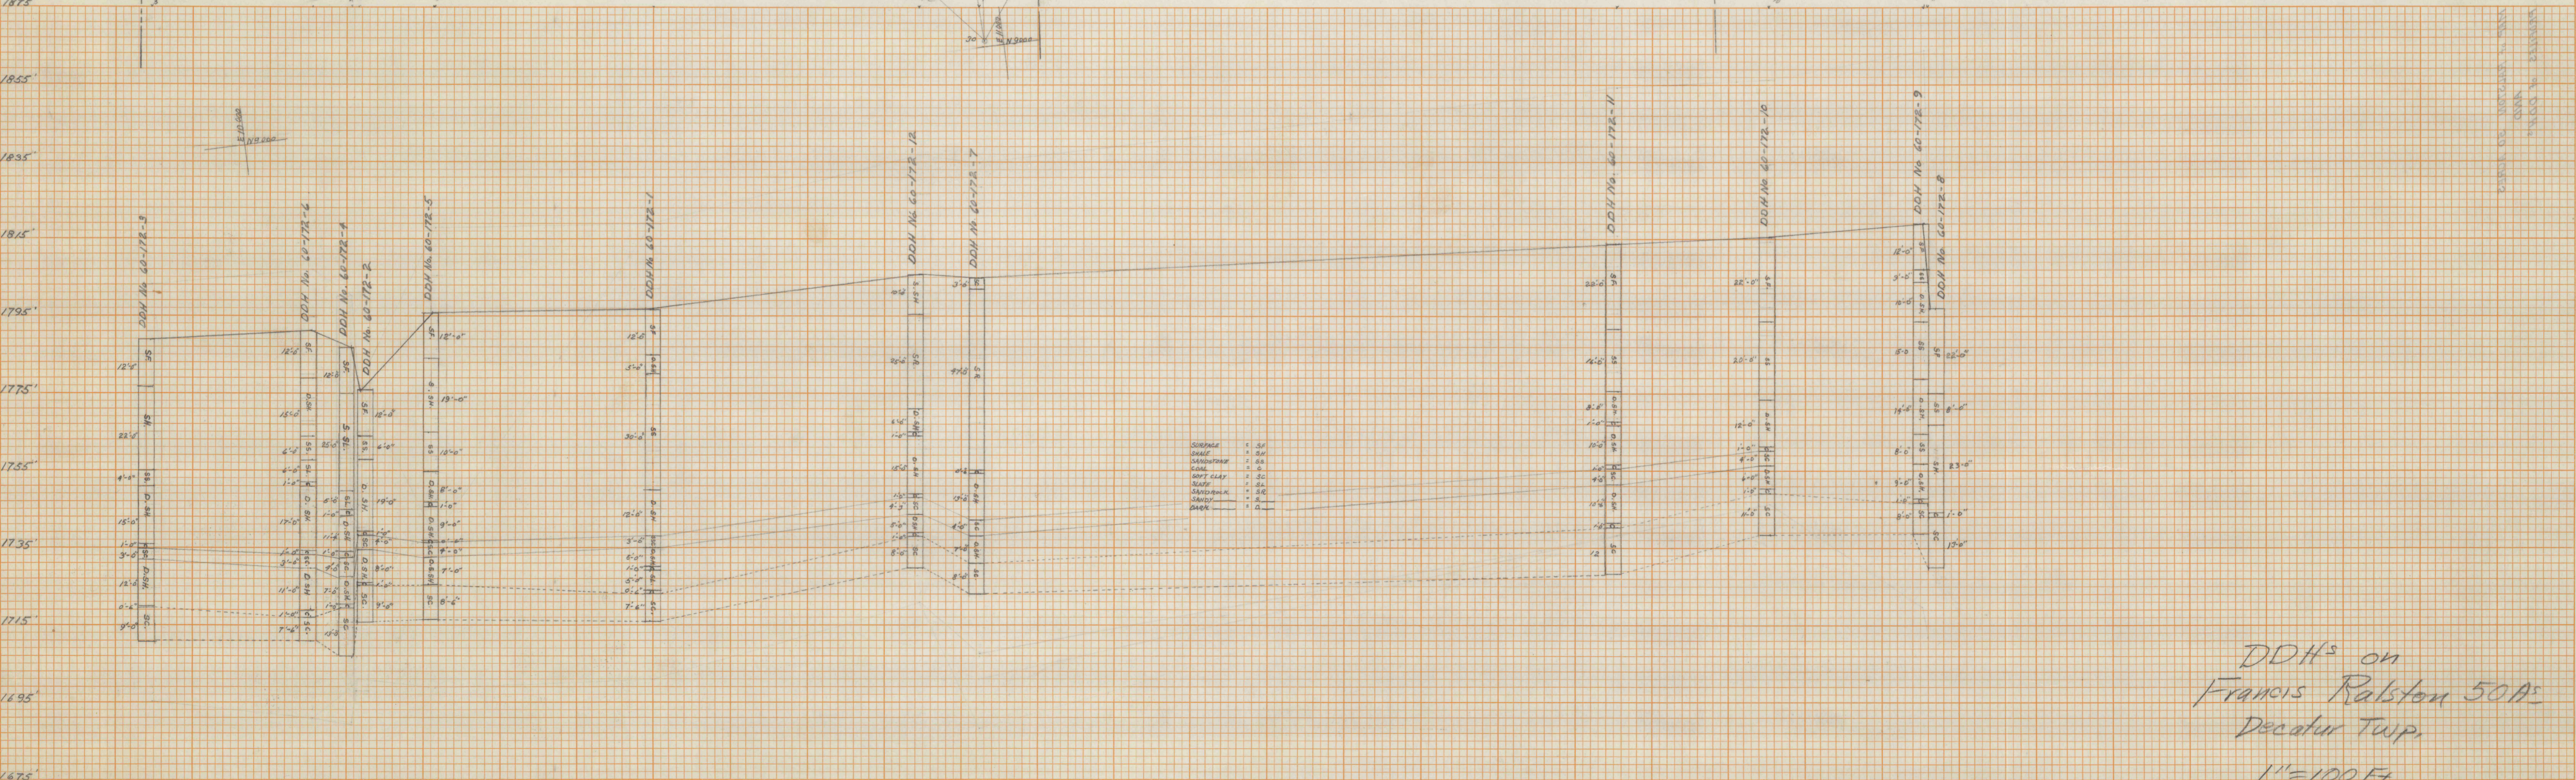


20-2-1253

FINAL SURVEY	BY	DATE
SURVEY		
PLOTTED		
NOTE BOOK		
AREAS CHECKED		
NO.		

ORIGINAL SURVEY	BY	DATE
SURVEY		
PLOTTED		
NOTE BOOK		
AREAS CHECKED		
NO.		

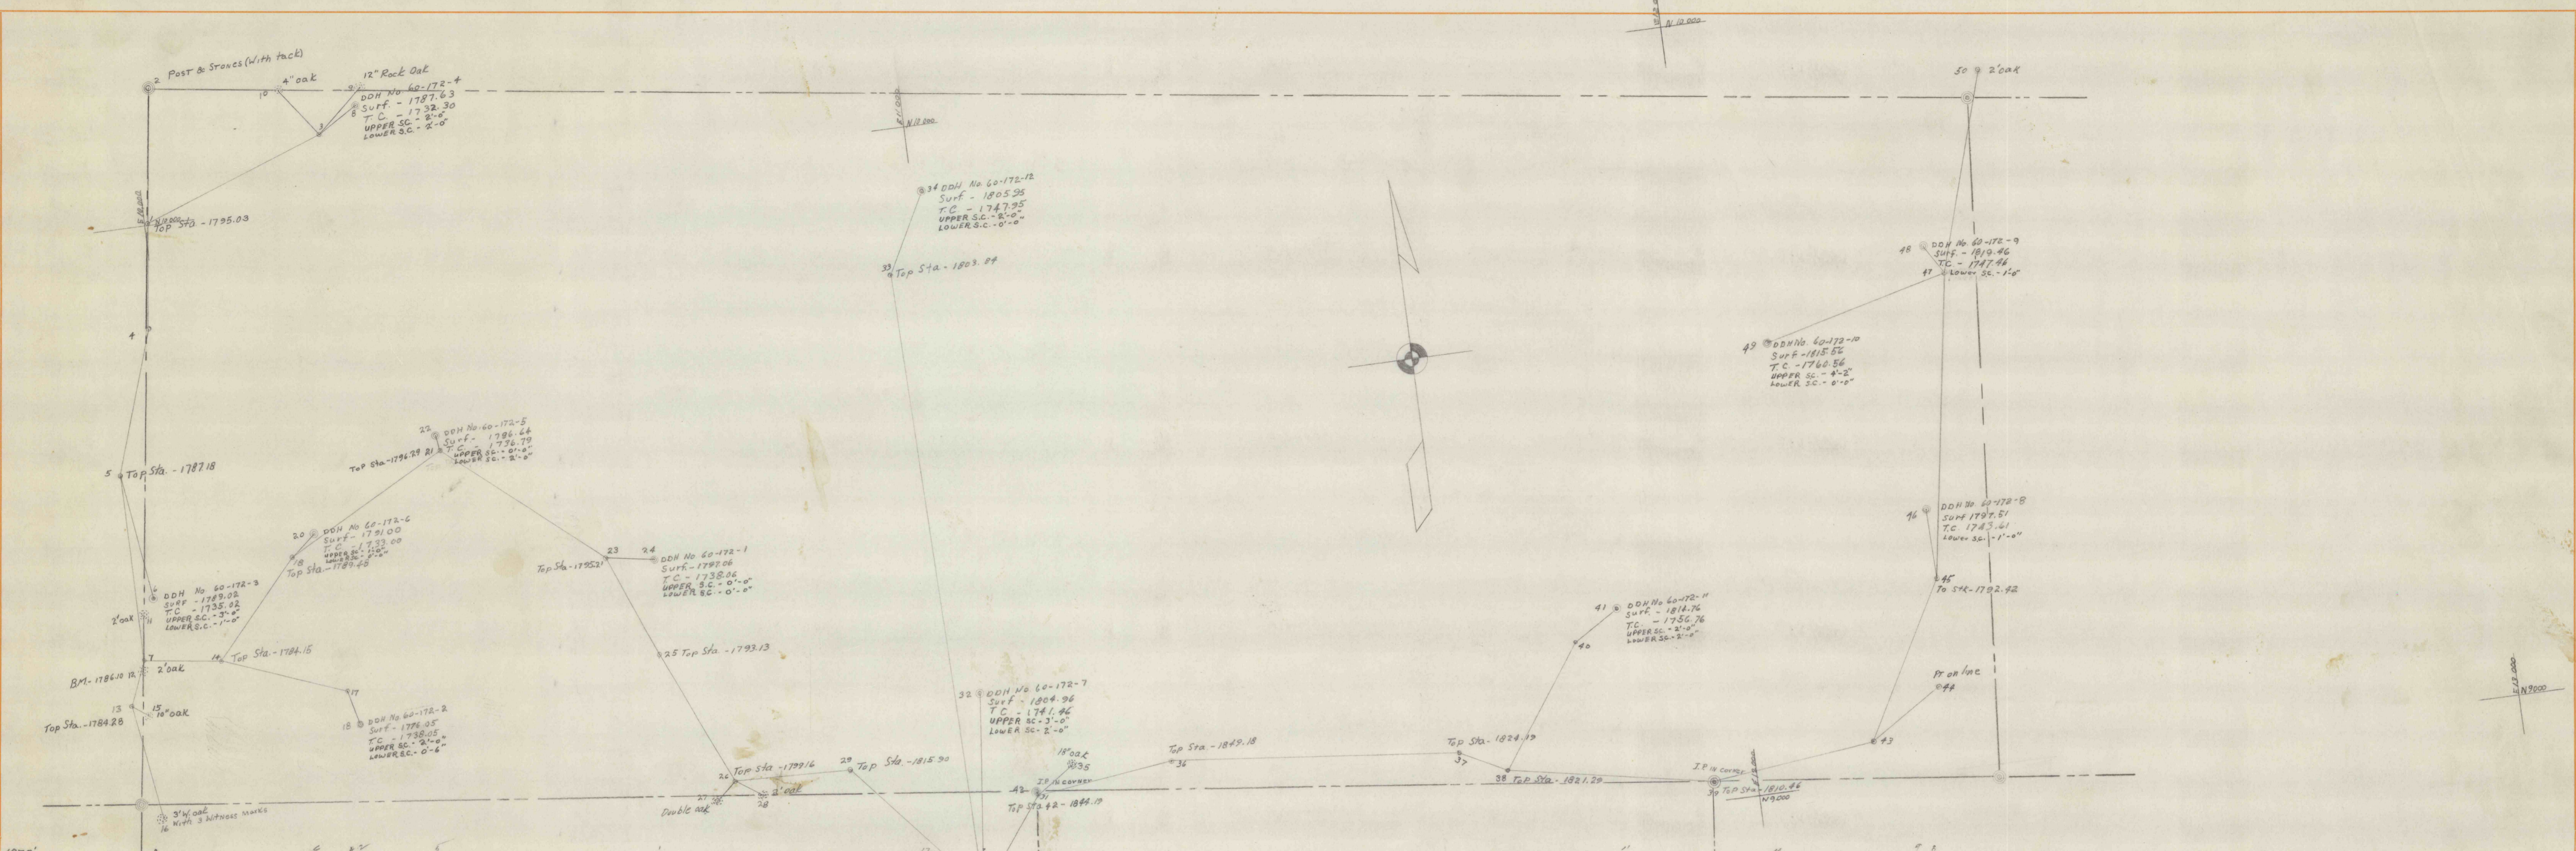

DDH's on  
Francis Ralston 50A  
Decatur Twp.  
1"=100 Ft.

20-2-1253