


BOUNDARY

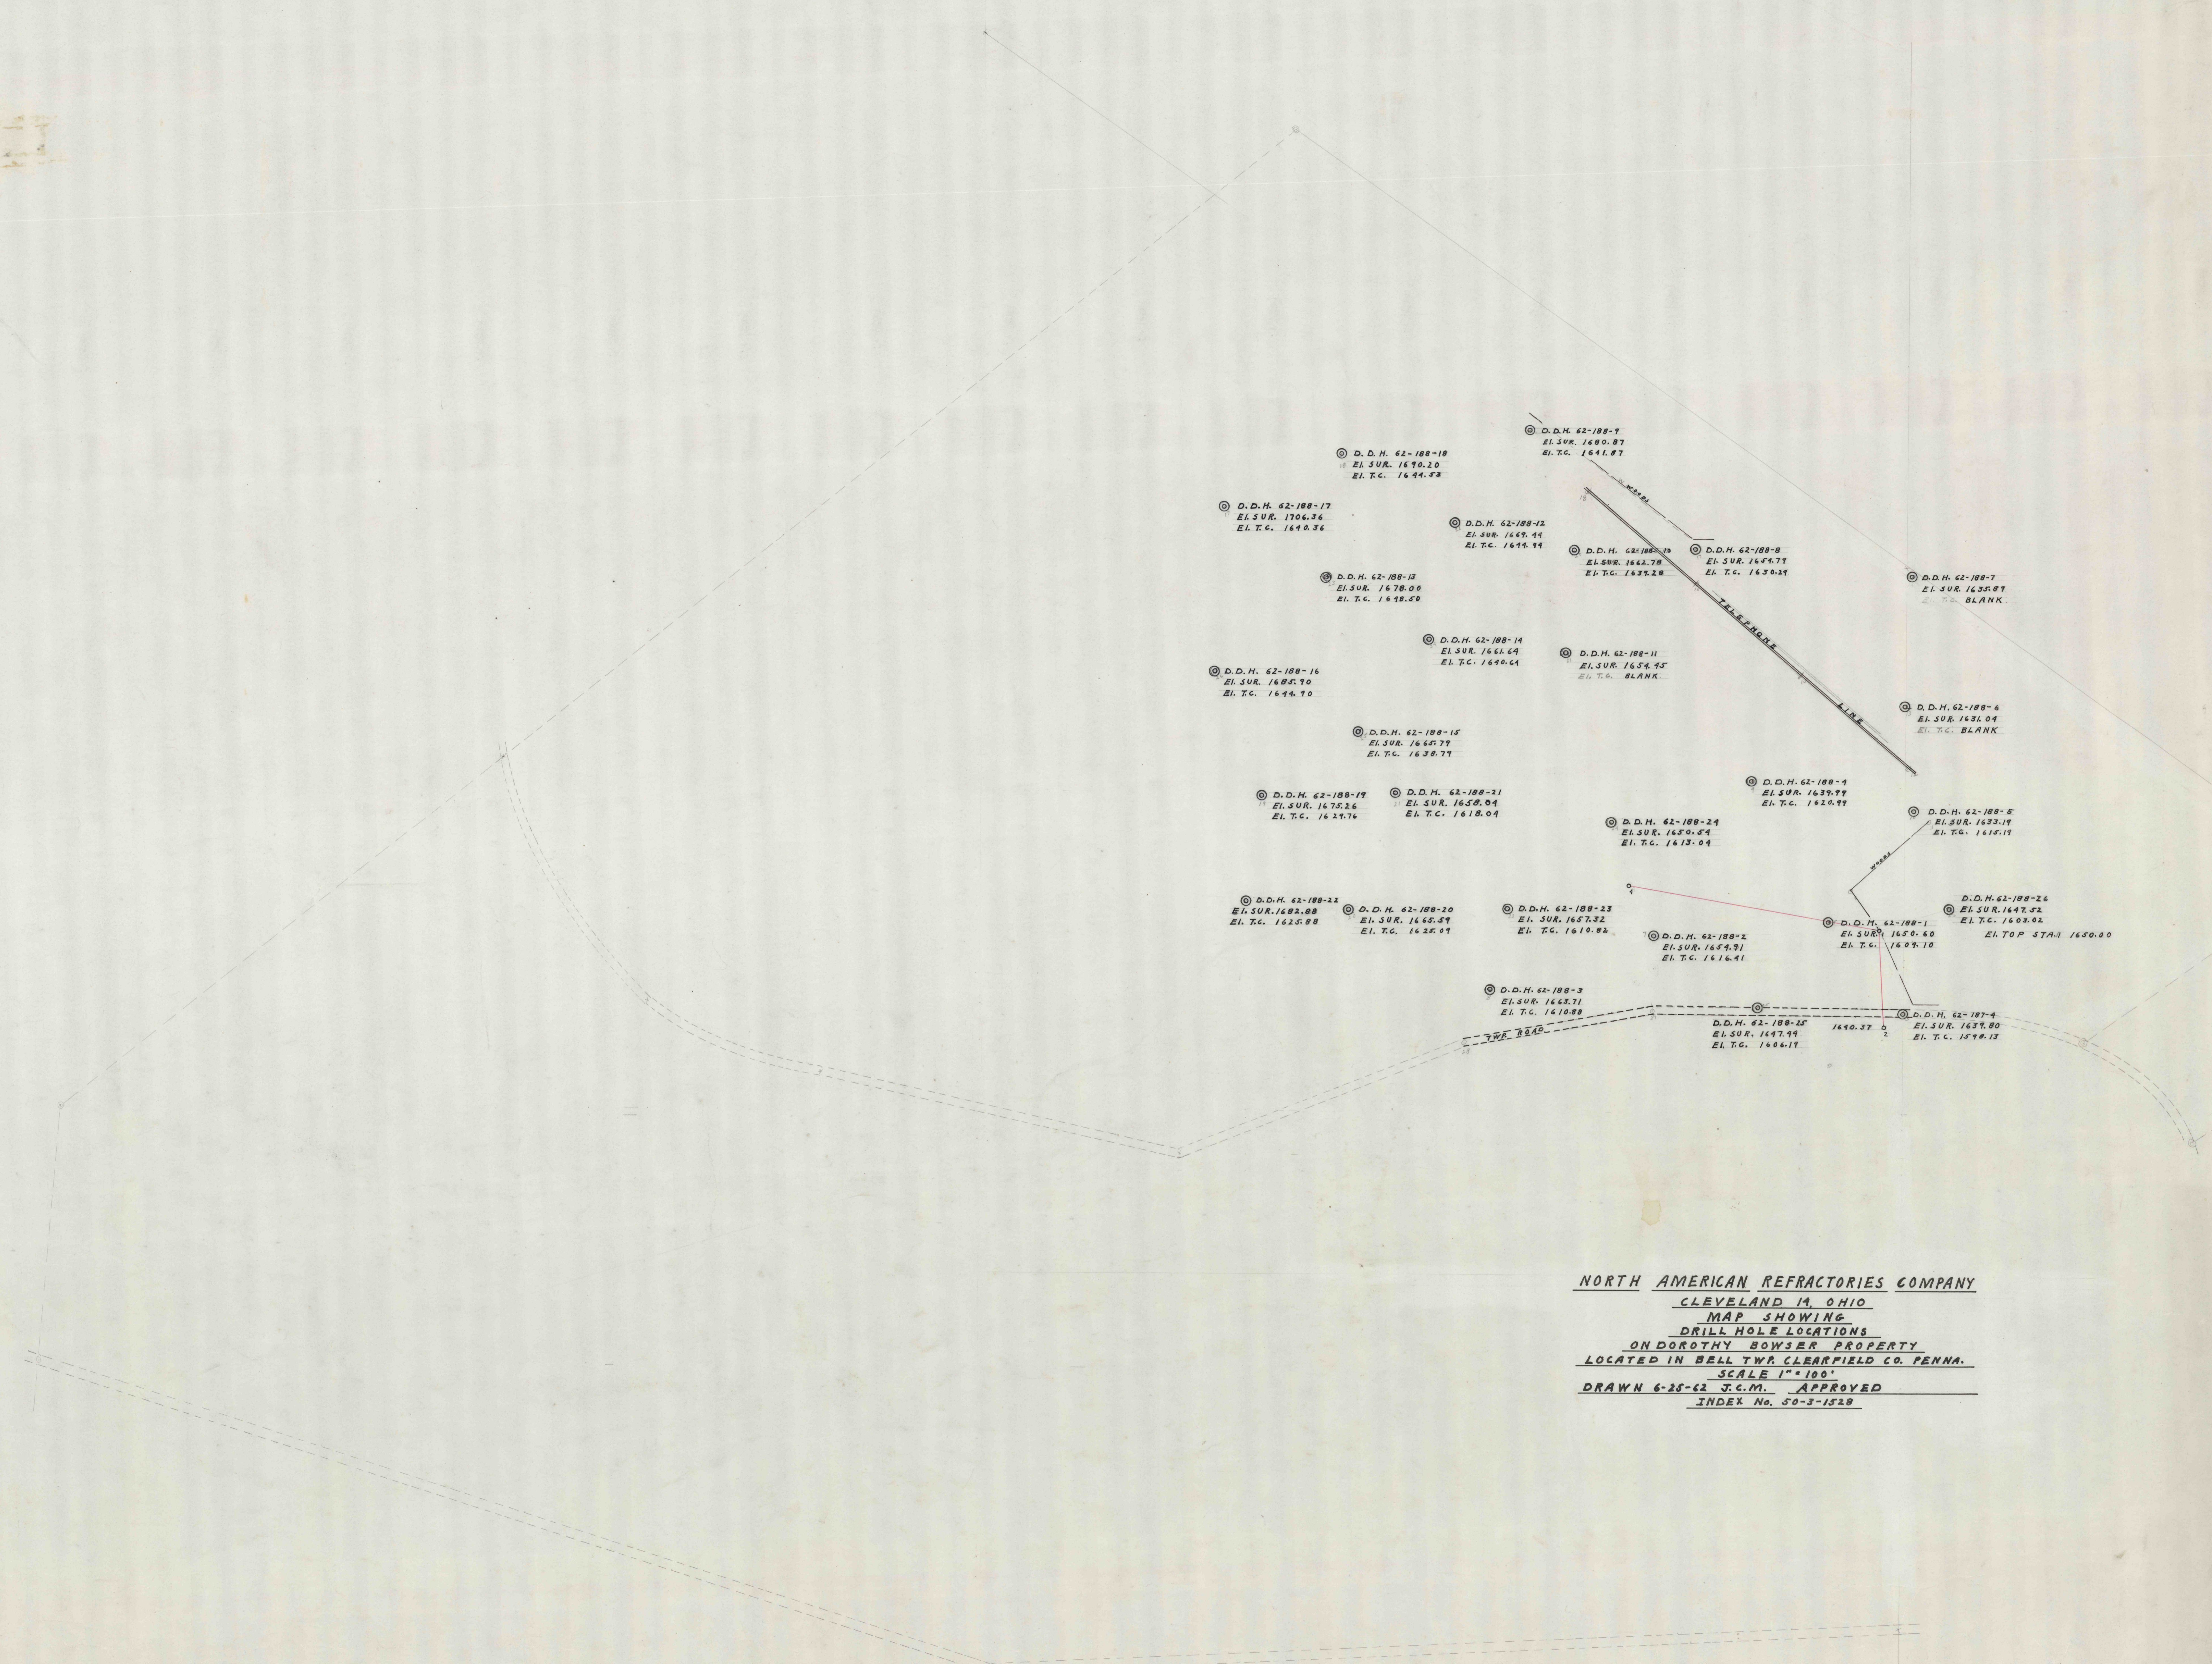

NORTH AMERICAN REFRACTORIES COMPANY
CLEVELAND 14, OHIO
MAP SHOWING
DRILL HOLE LOCATIONS
ON DOROTHY BOWSER PROPERTY
LOCATED IN BELL TWP CLEARFIELD CO. PENNA.
SCALE 1" = 100'
DRAWN 6-25-62 J.C.M. APPROVED
INDEX No. 50-3-1528

PROJ. - 11/23/62