



HARBISON-WALKER REFRACTORIES COMPANY

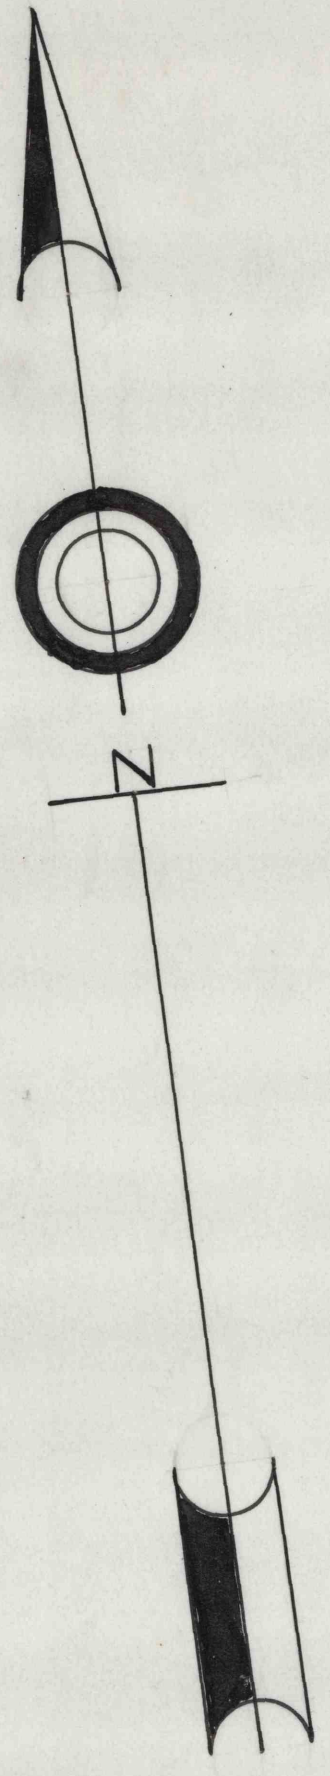

HARBISON-WALKER REFRACTORIES COMPANY

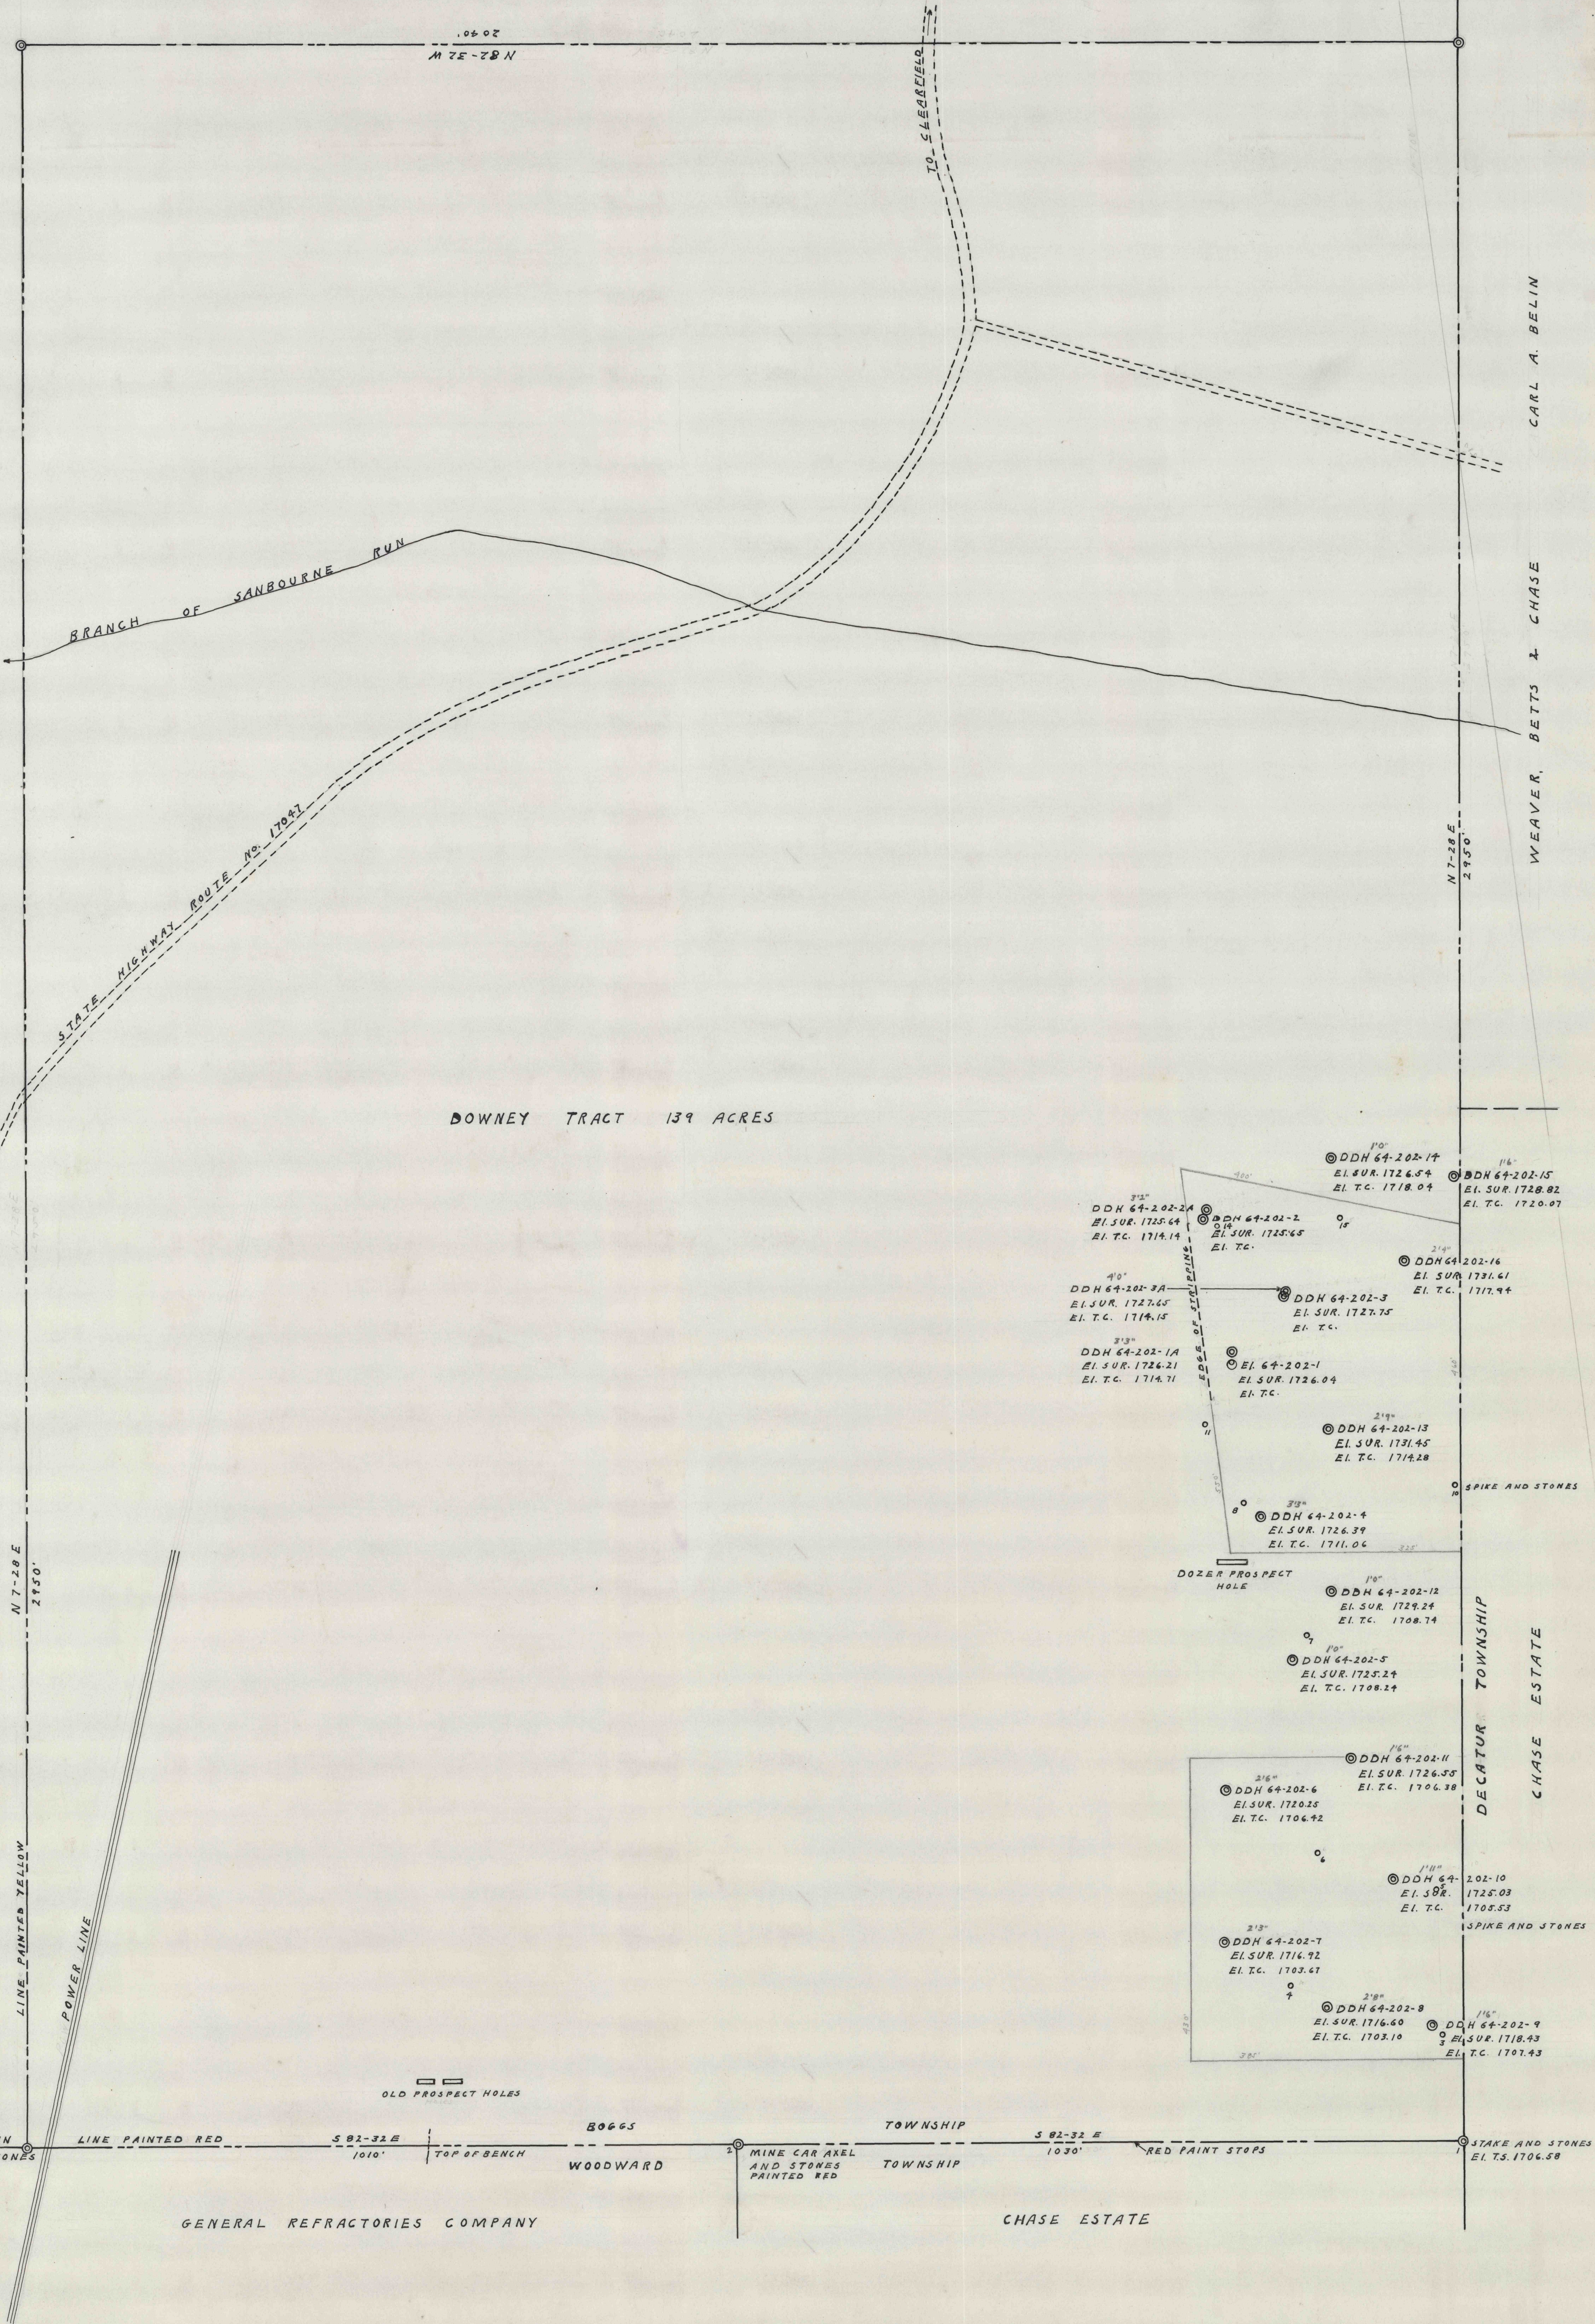

DOWNEY TRACT 139 ACRES

- DDH 64-202-14
EL. SUR. 1726.54
EL. T.C. 1718.04
- DDH 64-202-15
EL. SUR. 1728.82
EL. T.C. 1720.07
- DDH 64-202-16
EL. SUR. 1731.61
EL. T.C. 1717.94
- DDH 64-202-17
EL. SUR. 1727.75
EL. T.C.
- DDH 64-202-18
EL. SUR. 1731.45
EL. T.C. 1714.28
- DDH 64-202-19
EL. SUR. 1726.39
EL. T.C. 1711.06
- DDH 64-202-20
EL. SUR. 1729.24
EL. T.C. 1708.14
- DDH 64-202-21
EL. SUR. 1725.24
EL. T.C. 1708.24
- DDH 64-202-22
EL. SUR. 1726.35
EL. T.C. 1706.38
- DDH 64-202-23
EL. SUR. 1720.25
EL. T.C. 1706.42
- DDH 64-202-24
EL. SUR. 1725.64
EL. T.C. 1714.14
- DDH 64-202-25
EL. SUR. 1725.65
EL. T.C.
- DDH 64-202-26
EL. SUR. 1727.65
EL. T.C.
- DDH 64-202-27
EL. SUR. 1726.21
EL. T.C. 1714.15
- DDH 64-202-28
EL. SUR. 1726.21
EL. T.C. 1714.15
NORTH AMERICAN REFRACTORIES COMPANY
CLEVELAND 14, OHIO

MAP SHOWING
DOWNEY TRACT OF THOMPSON AND PHILLIPS CLAY CO. INC.
3066S TOWNSHIP CLEARFIELD COUNTY PENNA.

SCALE 1" = 100'

DRAWN J.C.M. 10-17-64 APPROVED

INDEX No. 50-3-1558