


LEASER (NARCO)

LAB (NARCO)

ALLESHOUSE (NARCO)

NICK NIGRO

RACHEL KREITER

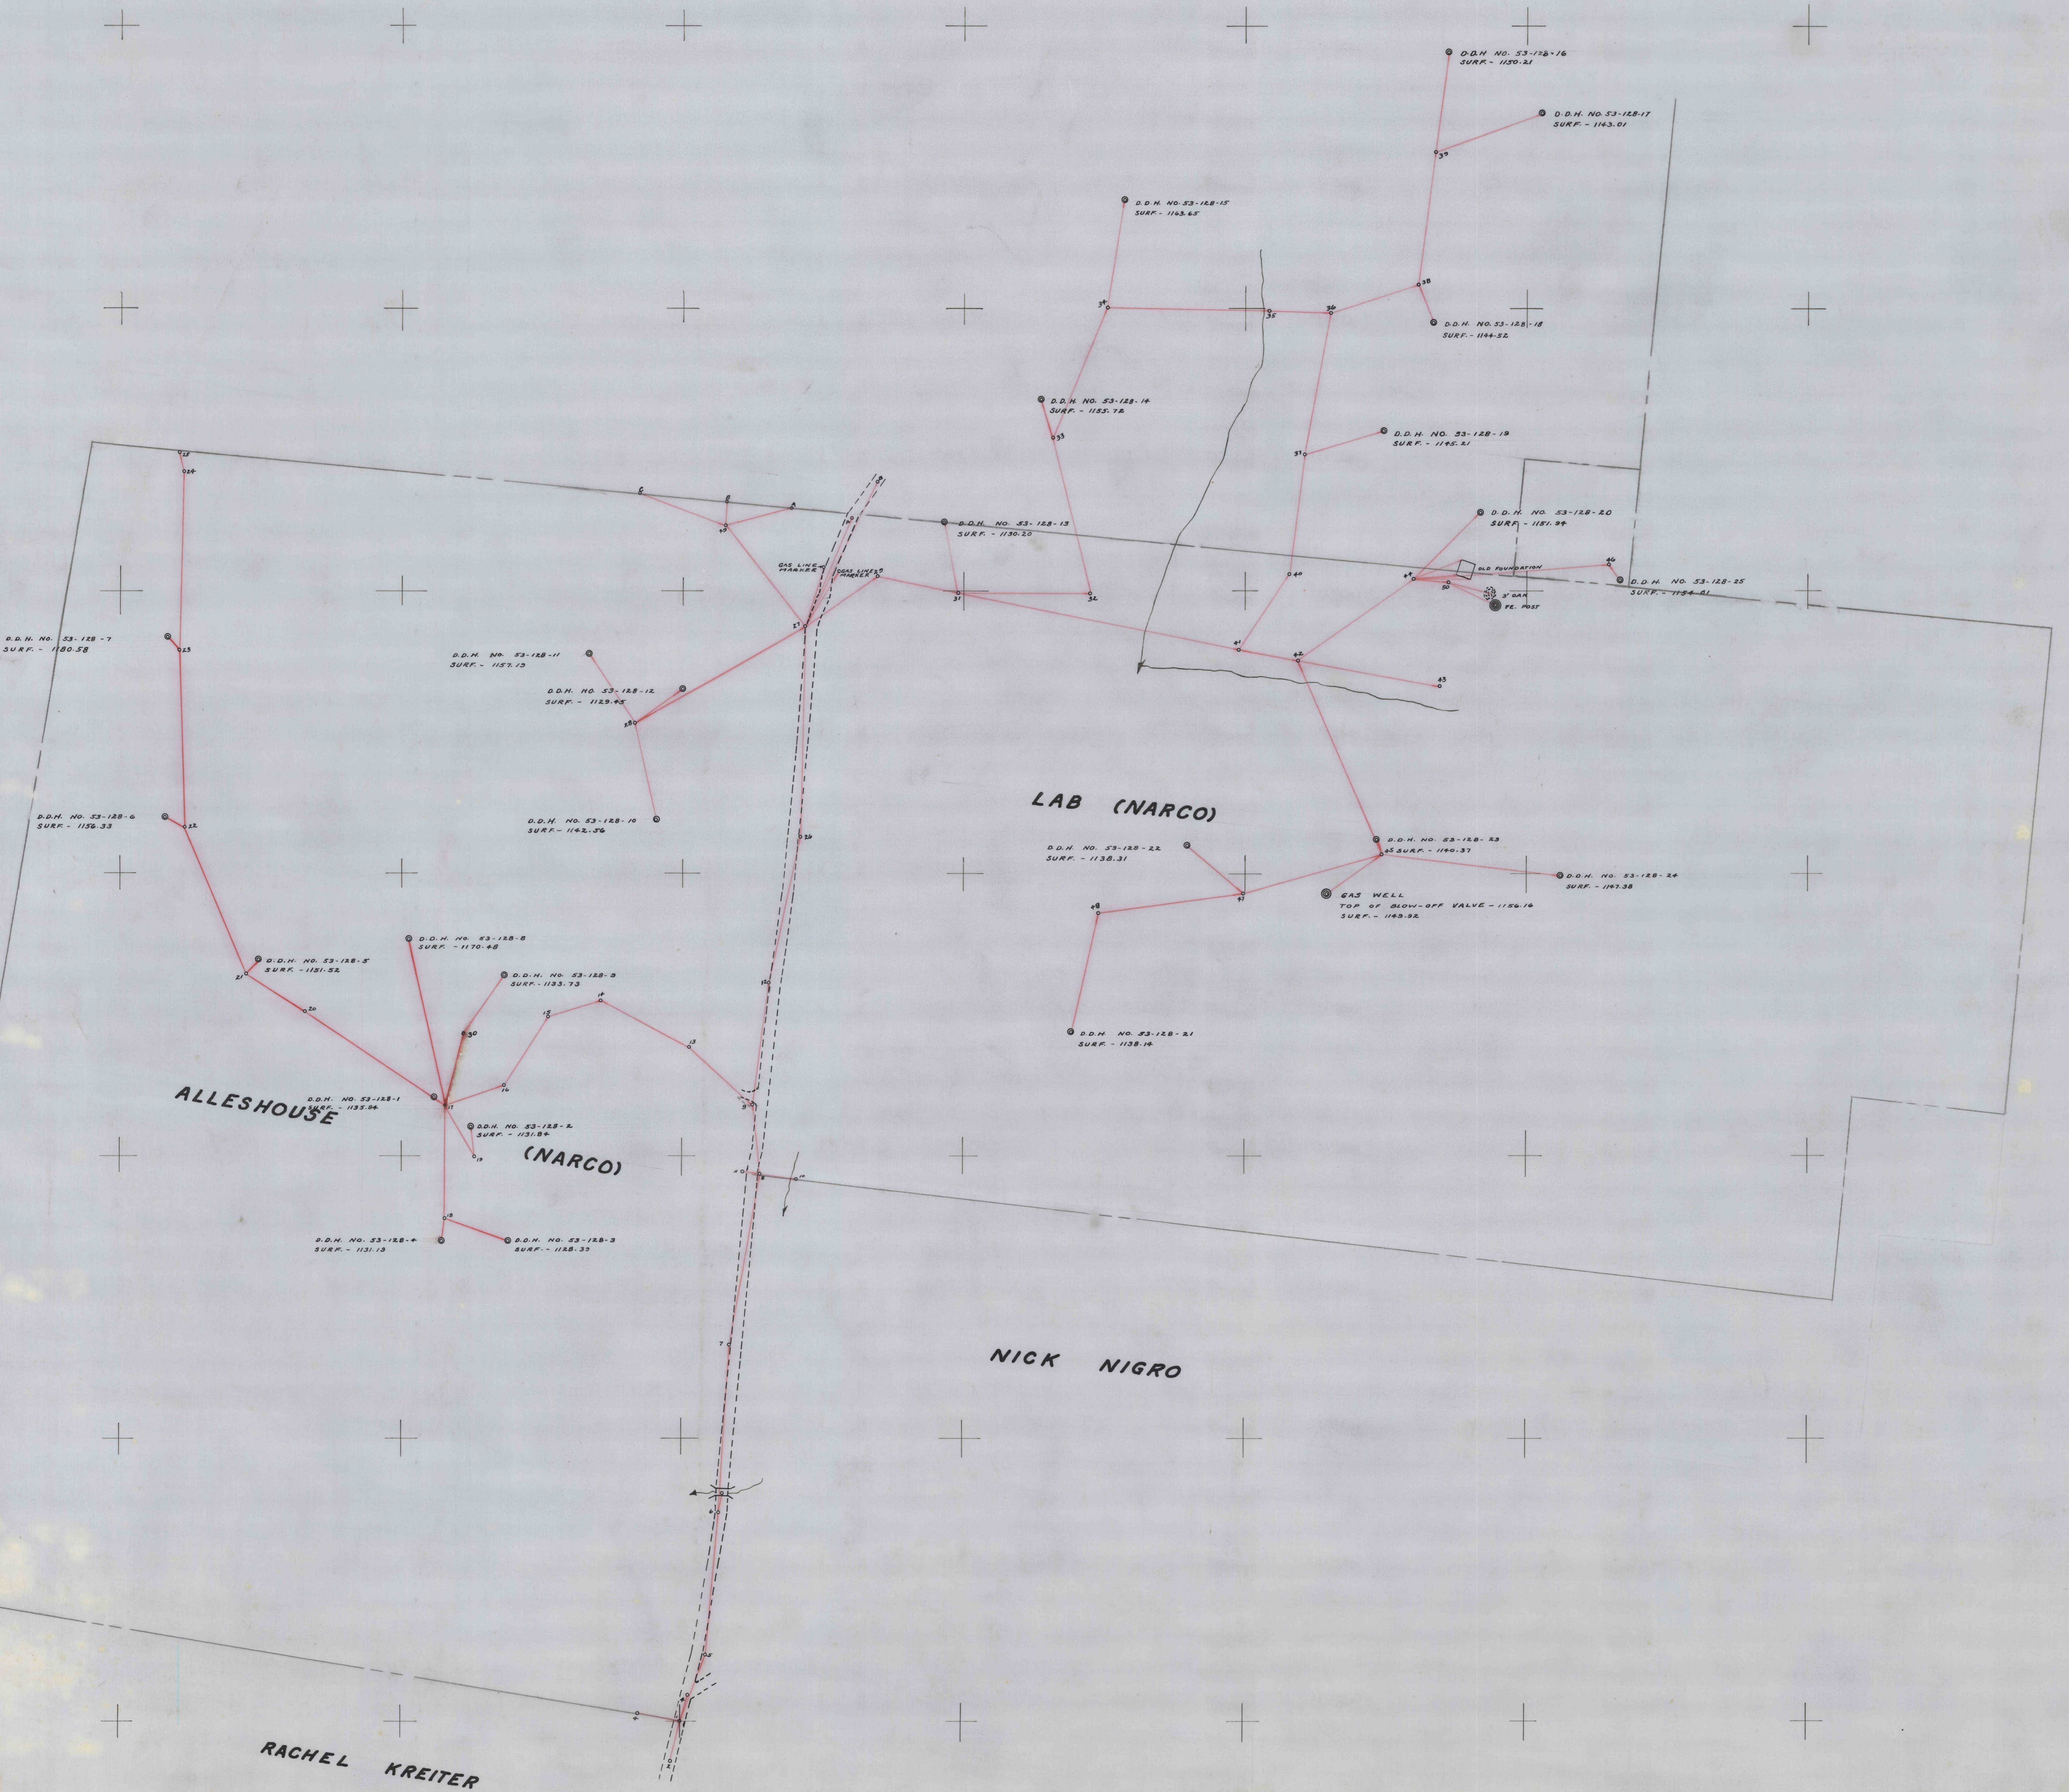

NORTH AMERICAN REFRACTORIES CO.
100 NATIONAL CITY-BANK BUILDING
CLEVELAND 14, OHIO

MAP OF NARCO CLAY LAND
LAWRENCE & DOVER TOWNSHIPS
TUSCARAWAS CO., OHIO

DRAWN J.E.H., JR. SCALE 1"=100'
CHECKED DATE 1-20-54
REFERENCE TRACED BY J.E.H., JR.