


SCALE 1" = 150'

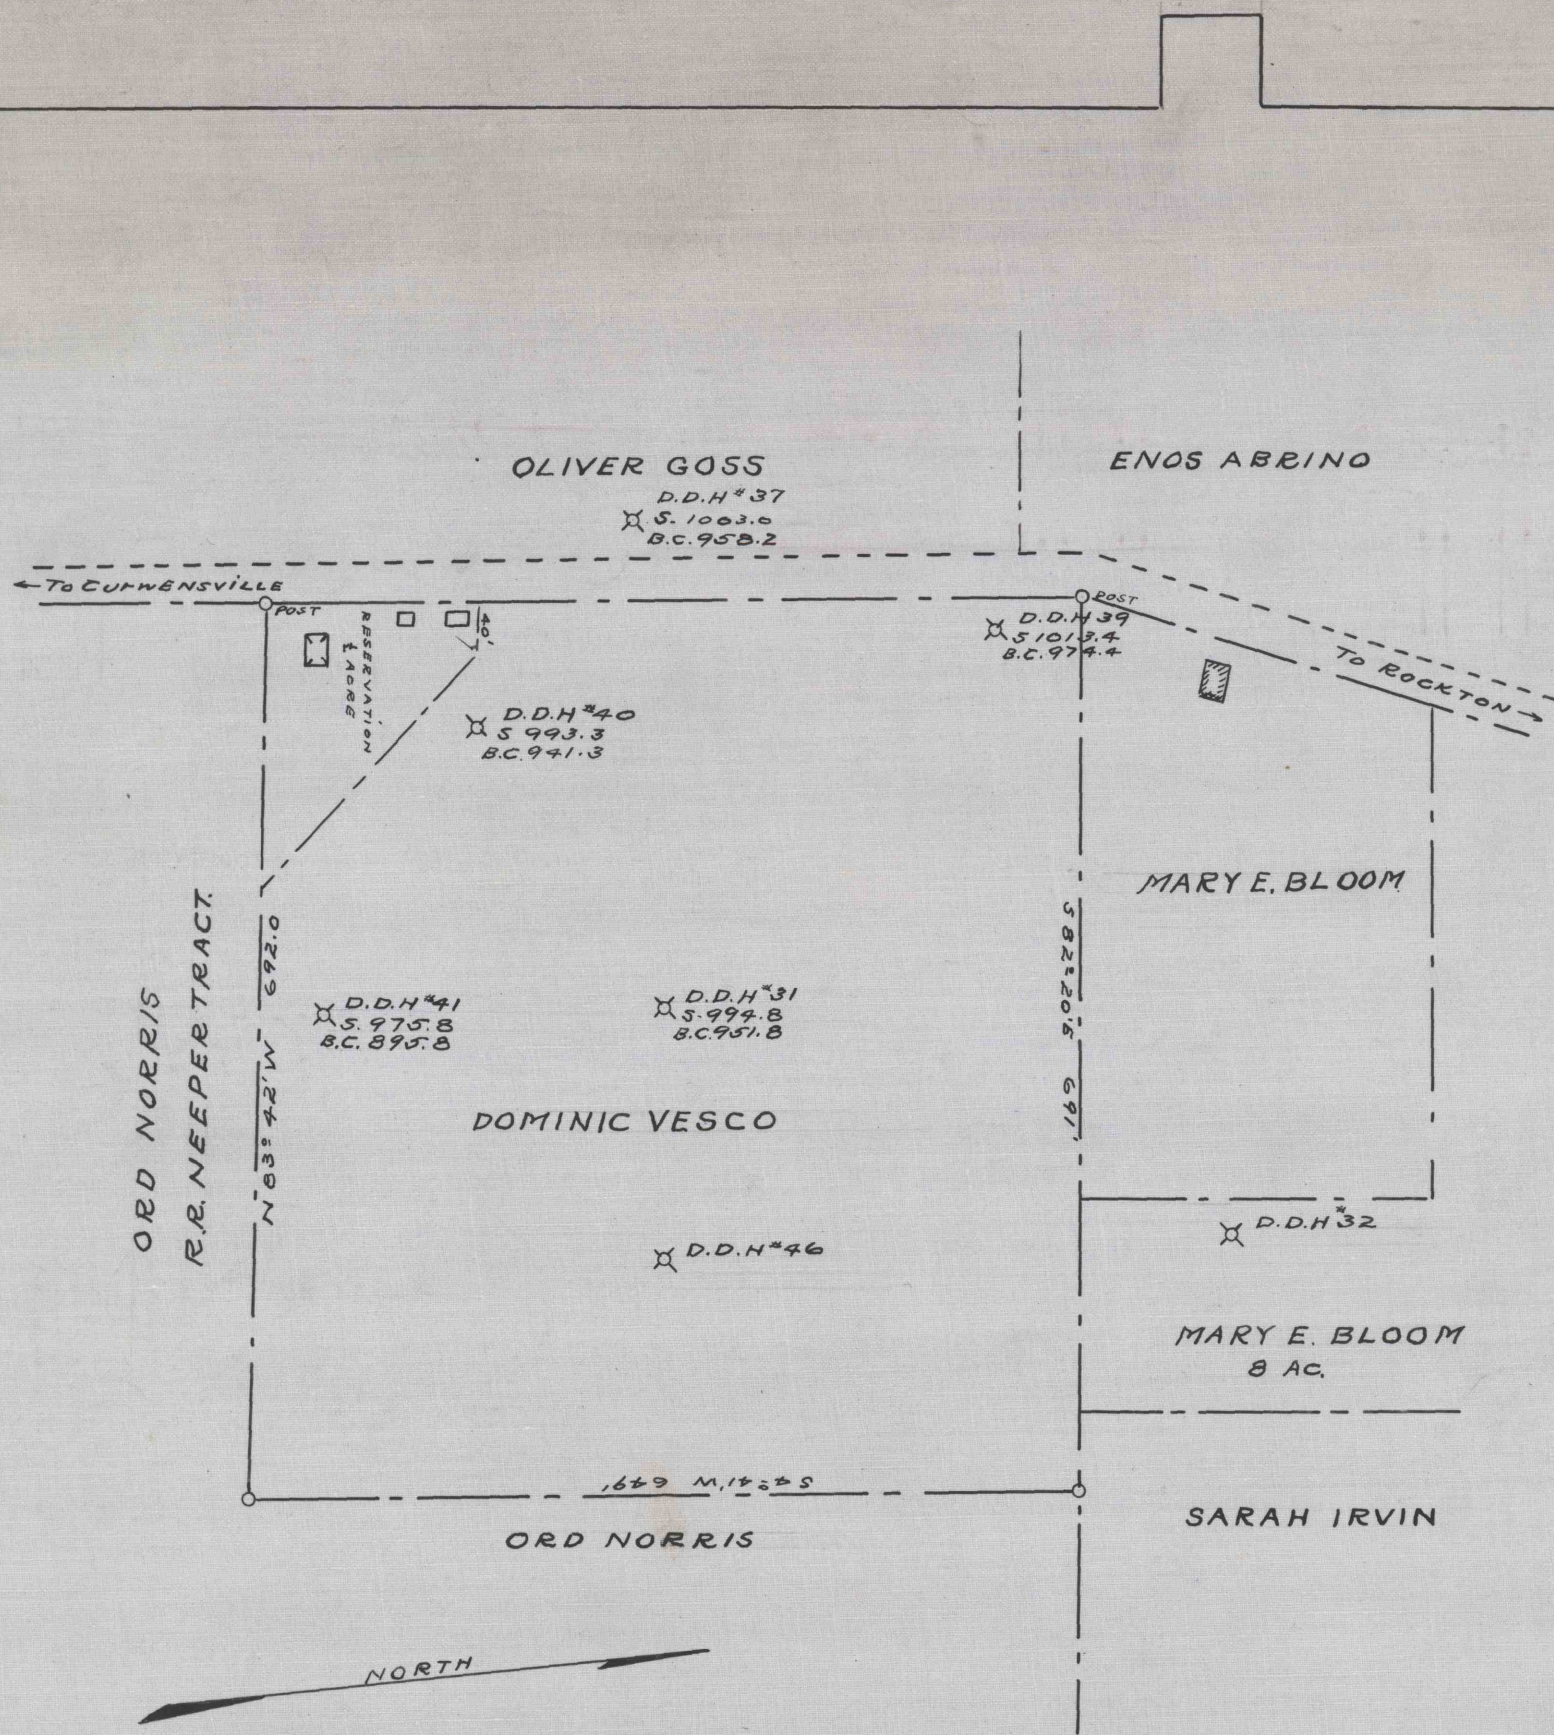

50-3-690

50-3-690