

REFERENCE DATA

CRESCENT REFRACTORIES CO.

CURWENSVILLE, CLEARFIELD COUNTY, PA.
ENGINEERING DEPARTMENT

ENV. No.


SHEET No.
50-3-1006

DIAMOND DRILL HOLES MOSES NORRIS (STAGE PROP)

5

SCALE 1" = 15'

DATE 11-29-19
12-11-19
5 SURFACE

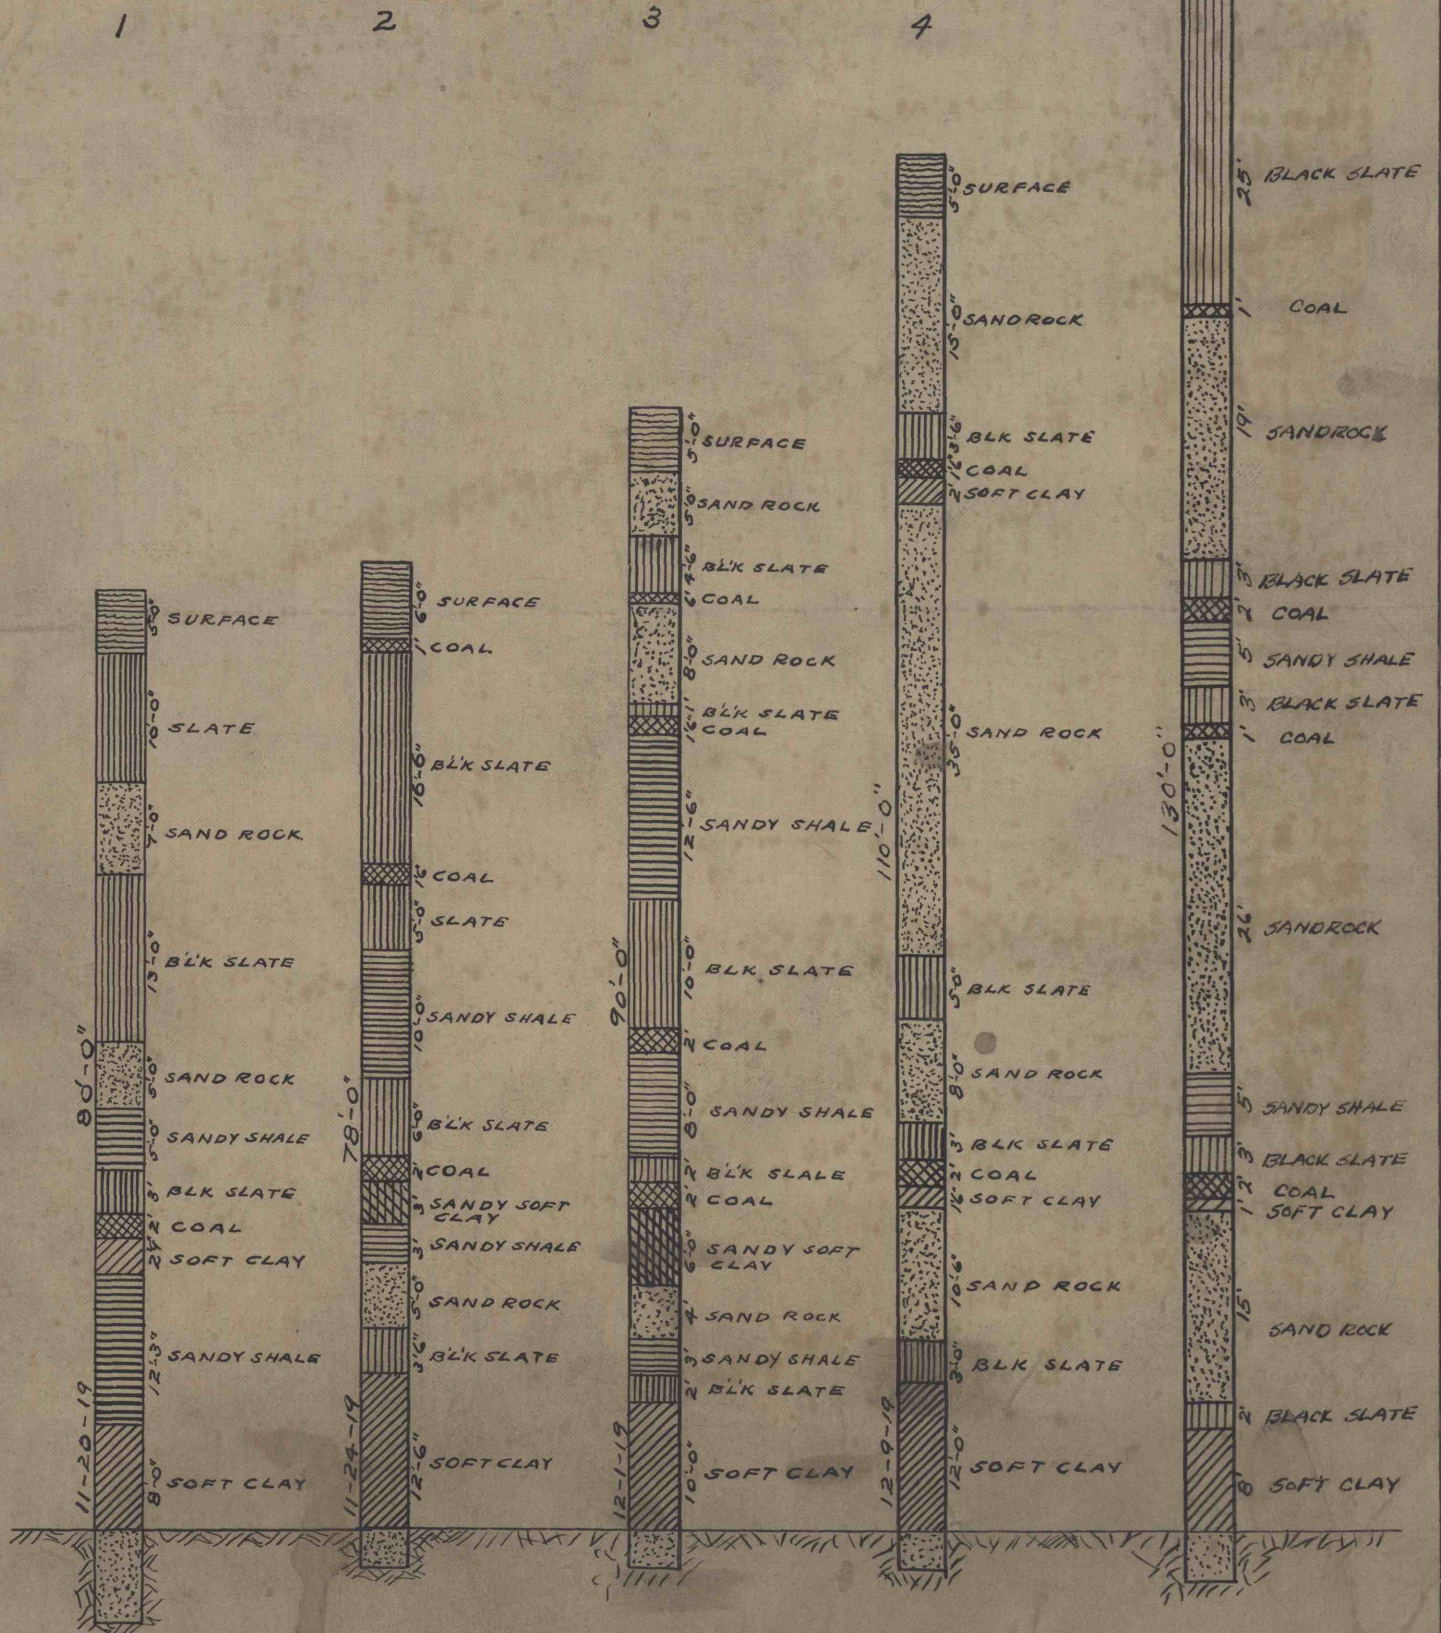

WORKED FROM DRILLERS REPORT

DRAWN BY C.F.S.

CHECKED BY