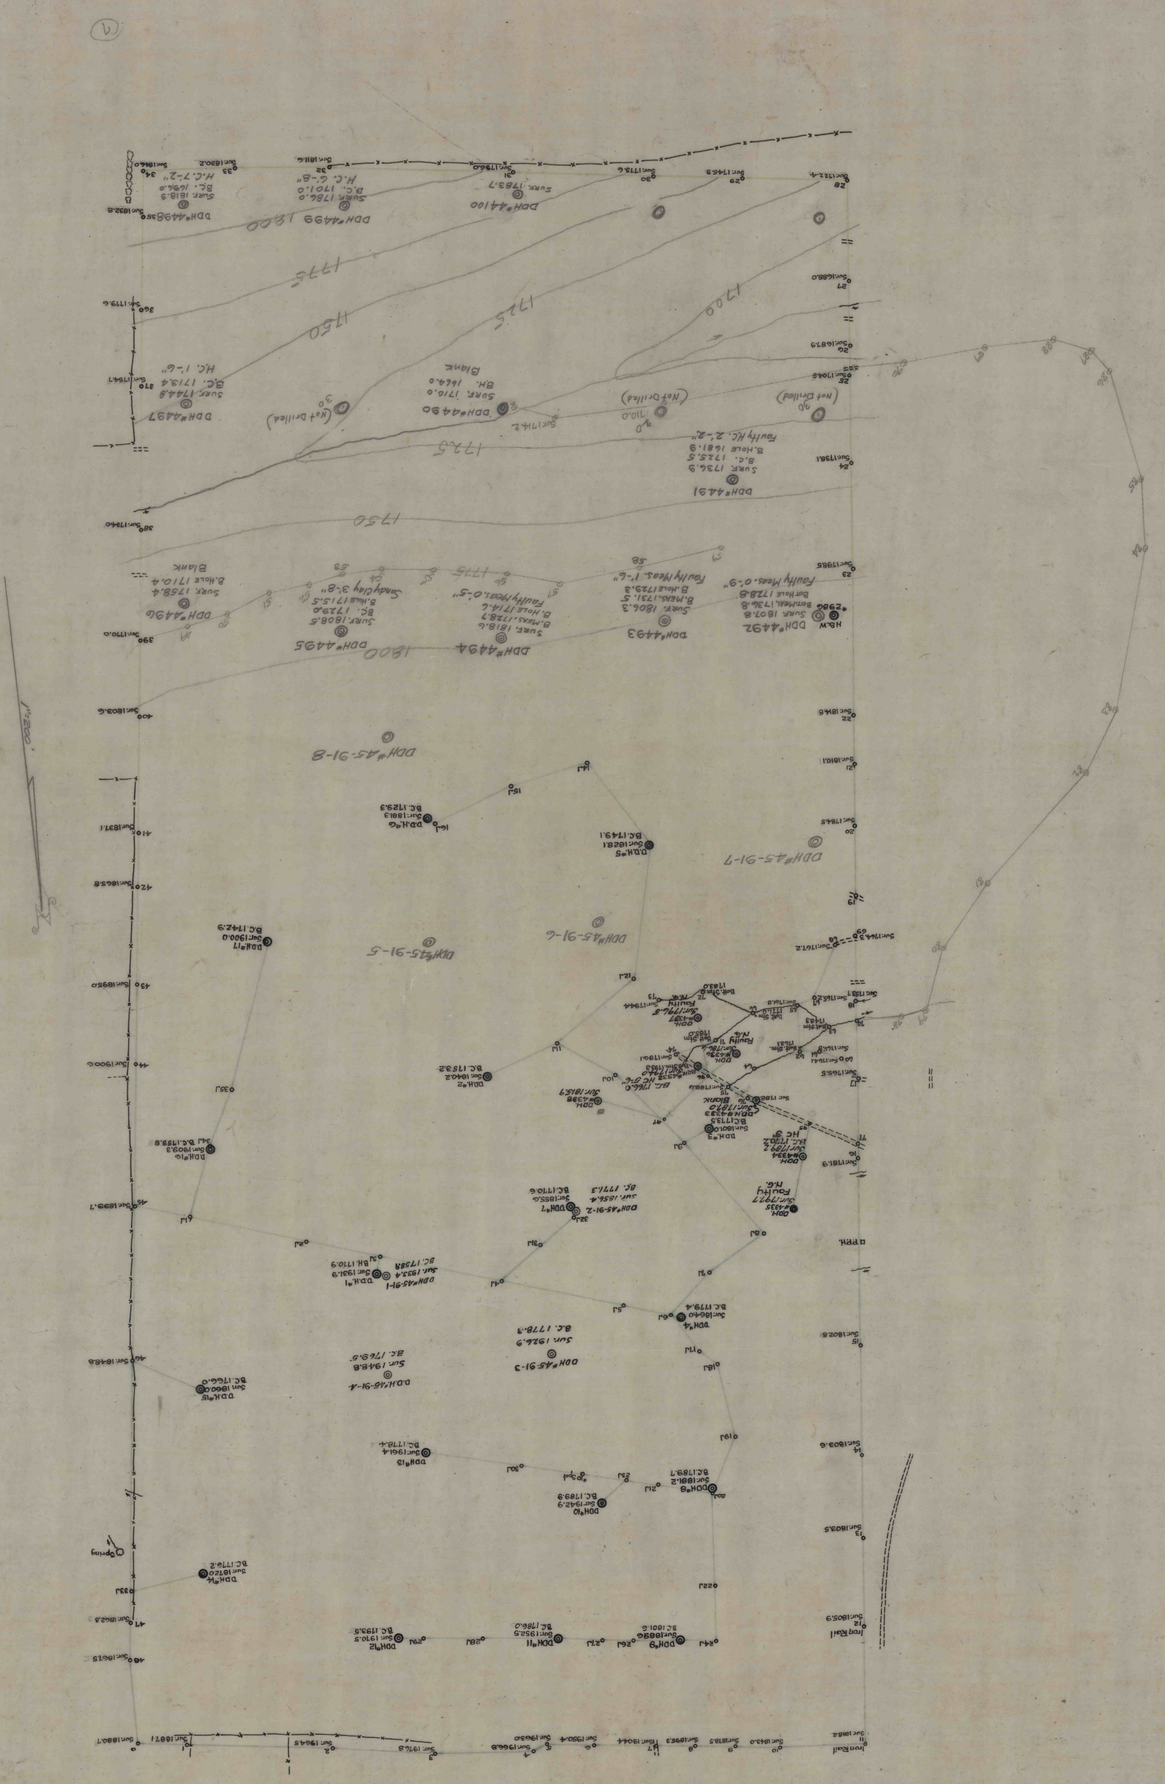
DDH#45-91-7
DDH#45-91-6
DDH#45-91-5
DDH#45-91-3
DDH#45-91-2
DDH#45-91-1
DDH#4491
DDH#4492
DDH#4493
DDH#4494
DDH#4495
DDH#4496
DDH#4497
DDH#4498
DDH#4499
DDH#44100
Not Drilled
Fault Meas. 0-9"
Fault Meas. 1"-6"
Fault Meas. 0-5"
Blank
1800
1750
1700
