

HEIRS OF JAMES HERBURN - CLAY



PENN TWP COAL CO. - CLAY

PAUL SMITH
18A ±

JOSEPH KORB
92A ±
NARCO - CLAY LEASE

HARRISON SHAFFER
NARCO - CLAY LEASE

IRA DUNWORTH

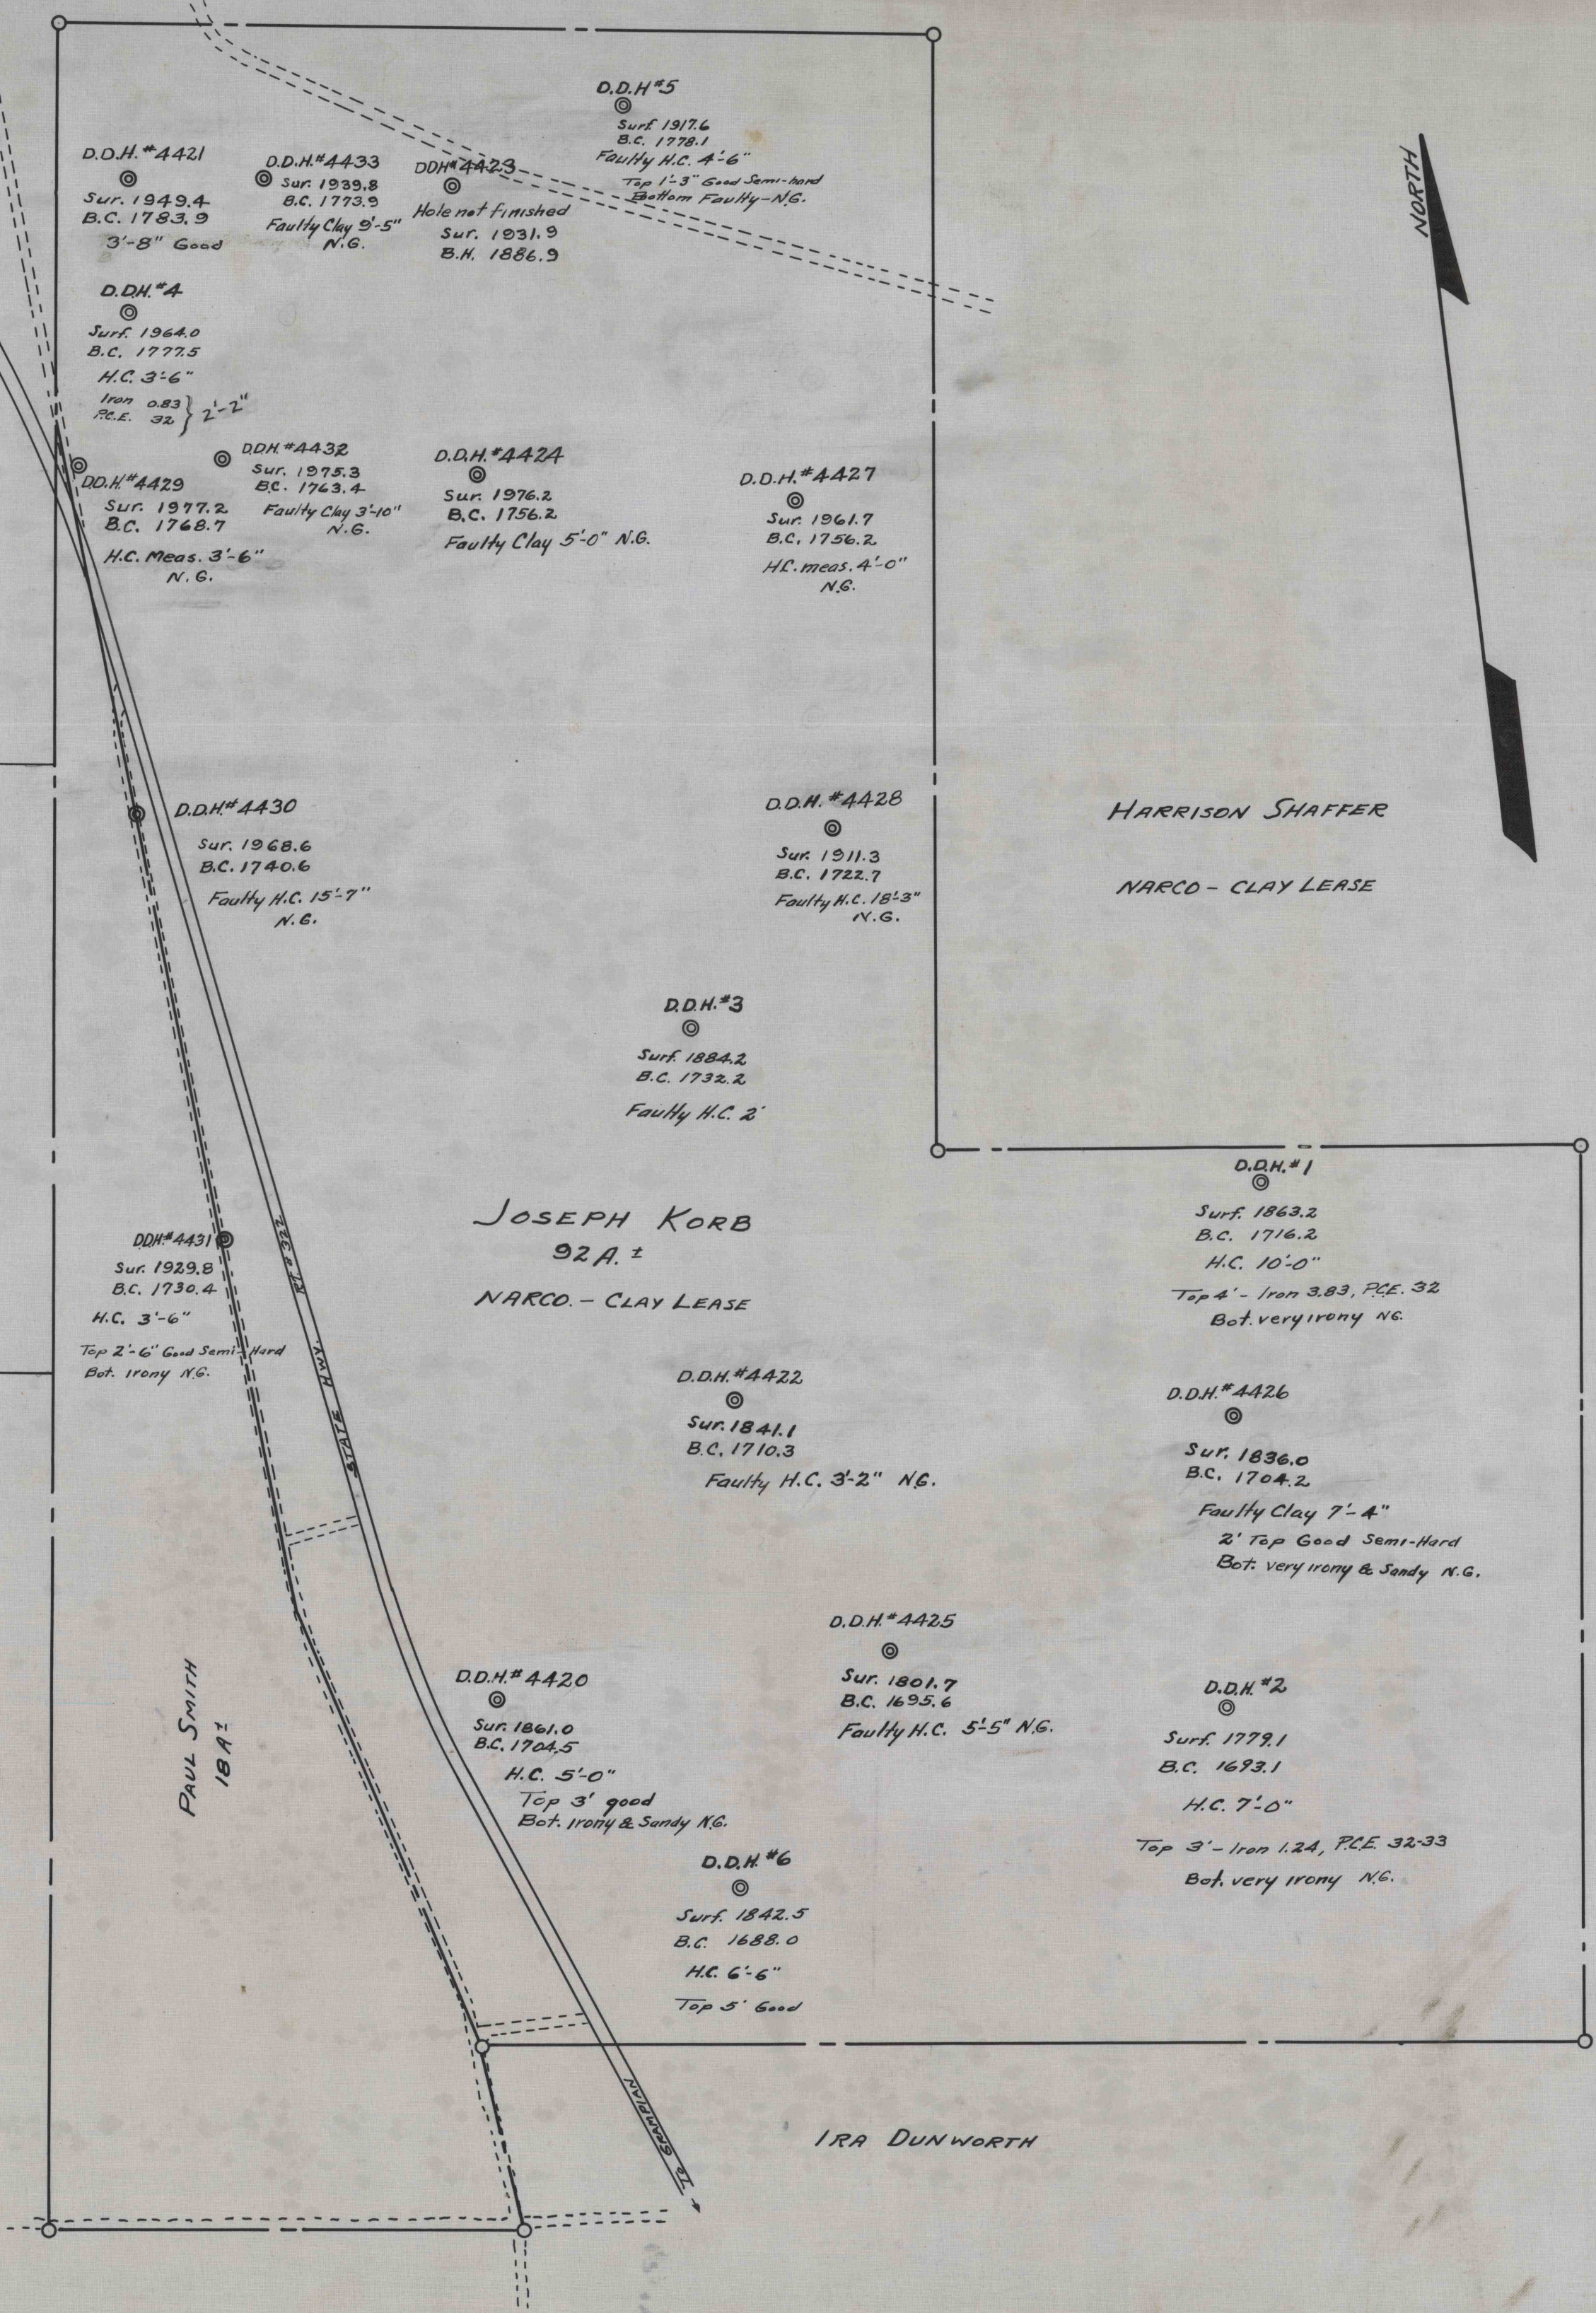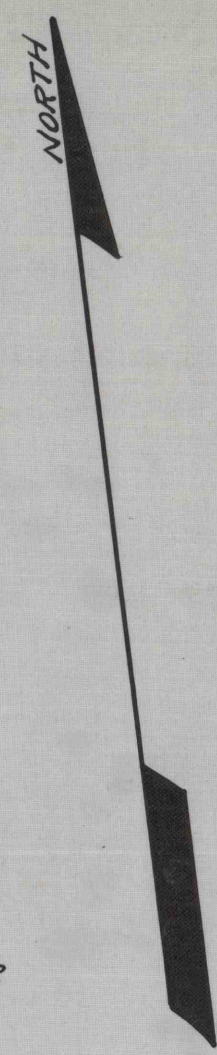

NORTH AMERICAN REFRACTORIES COMPANY CLEVELAND, OHIO.	
DIAMOND DRILLING ON THE JOSEPH KORB TRACT BLOOM TWP - CLEARFIELD COUNTY - PA.	
DRAWN BY- <i>gsh</i> JUNE 27, 1944	
SCALE - 1" = 200 FT.	50-3-1072