

NORTH AMERICAN REFRACTORIES CO.

1012 NATIONAL CITY—EAST 6TH BUILDING
CLEVELAND 14, OHIO

MAP SHOWING DIAMOND DRILLING

RALSTON—CORIO PROPERTY

LOCATED IN
WOODWARD TWP., CLEARFIELD CO., PA.

ENV. No.


SHEET No.

50-3-1374

DATE 9-13-57

SCALE : 1" = 200'

AUSTIN KLINE

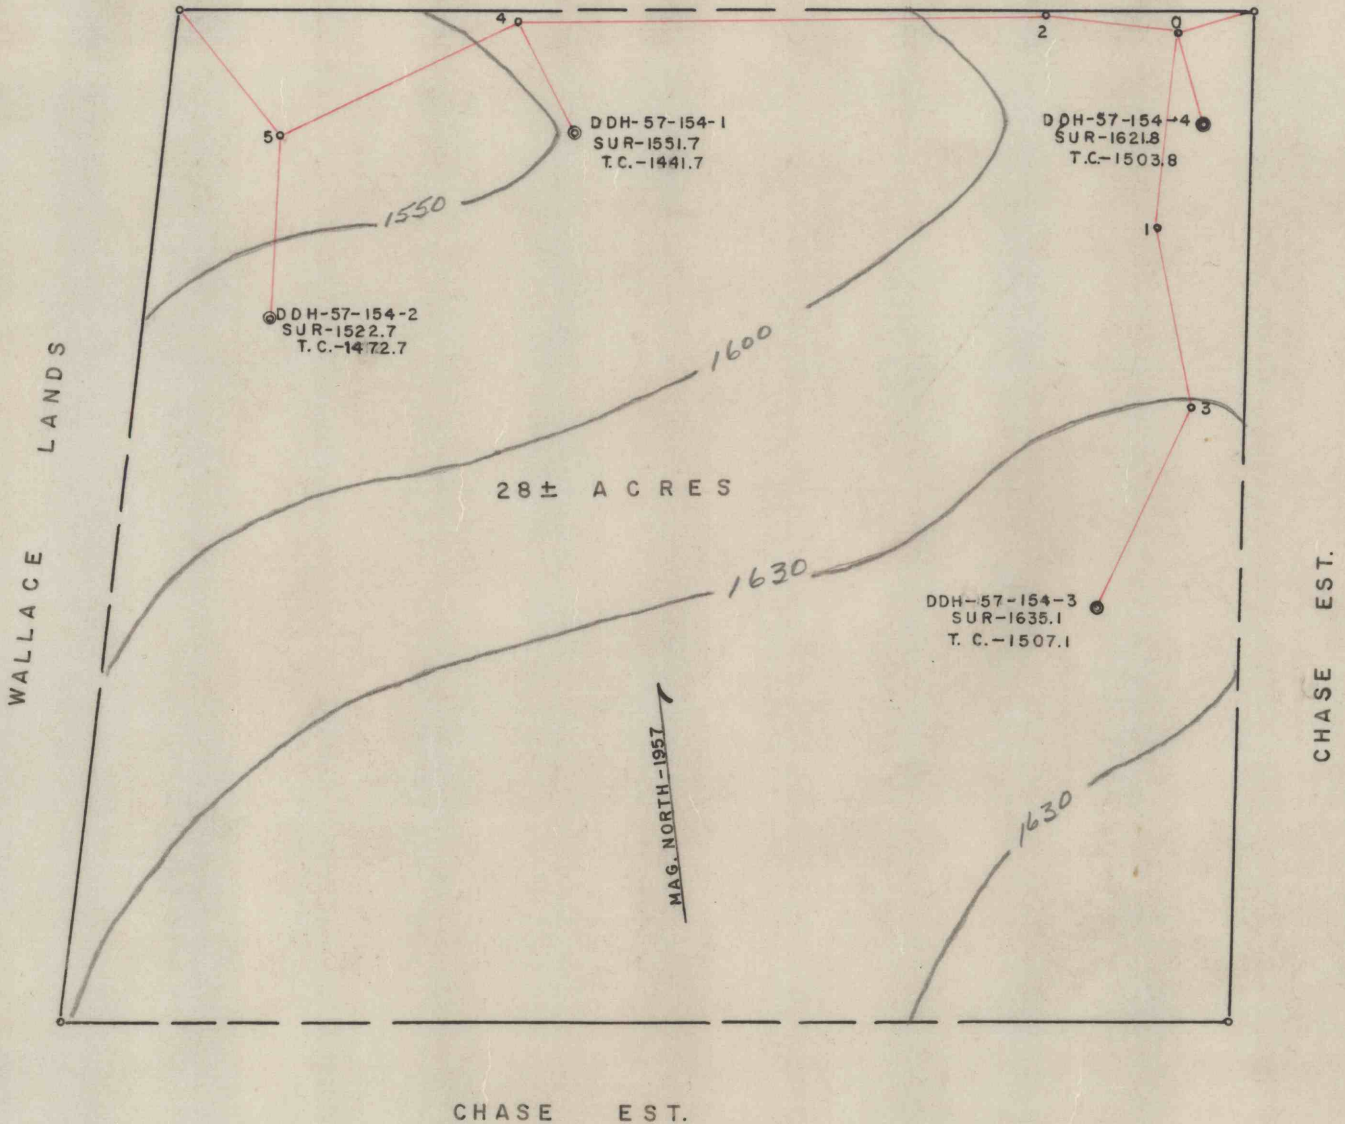

REVISION

DRAWN M. W. D.

CHECKED *[Signature]*

REFERENCE: SURVEY-BOOK 268 PAGE 6.

PENN-01421