


SCALE 1 in = 200 ft.

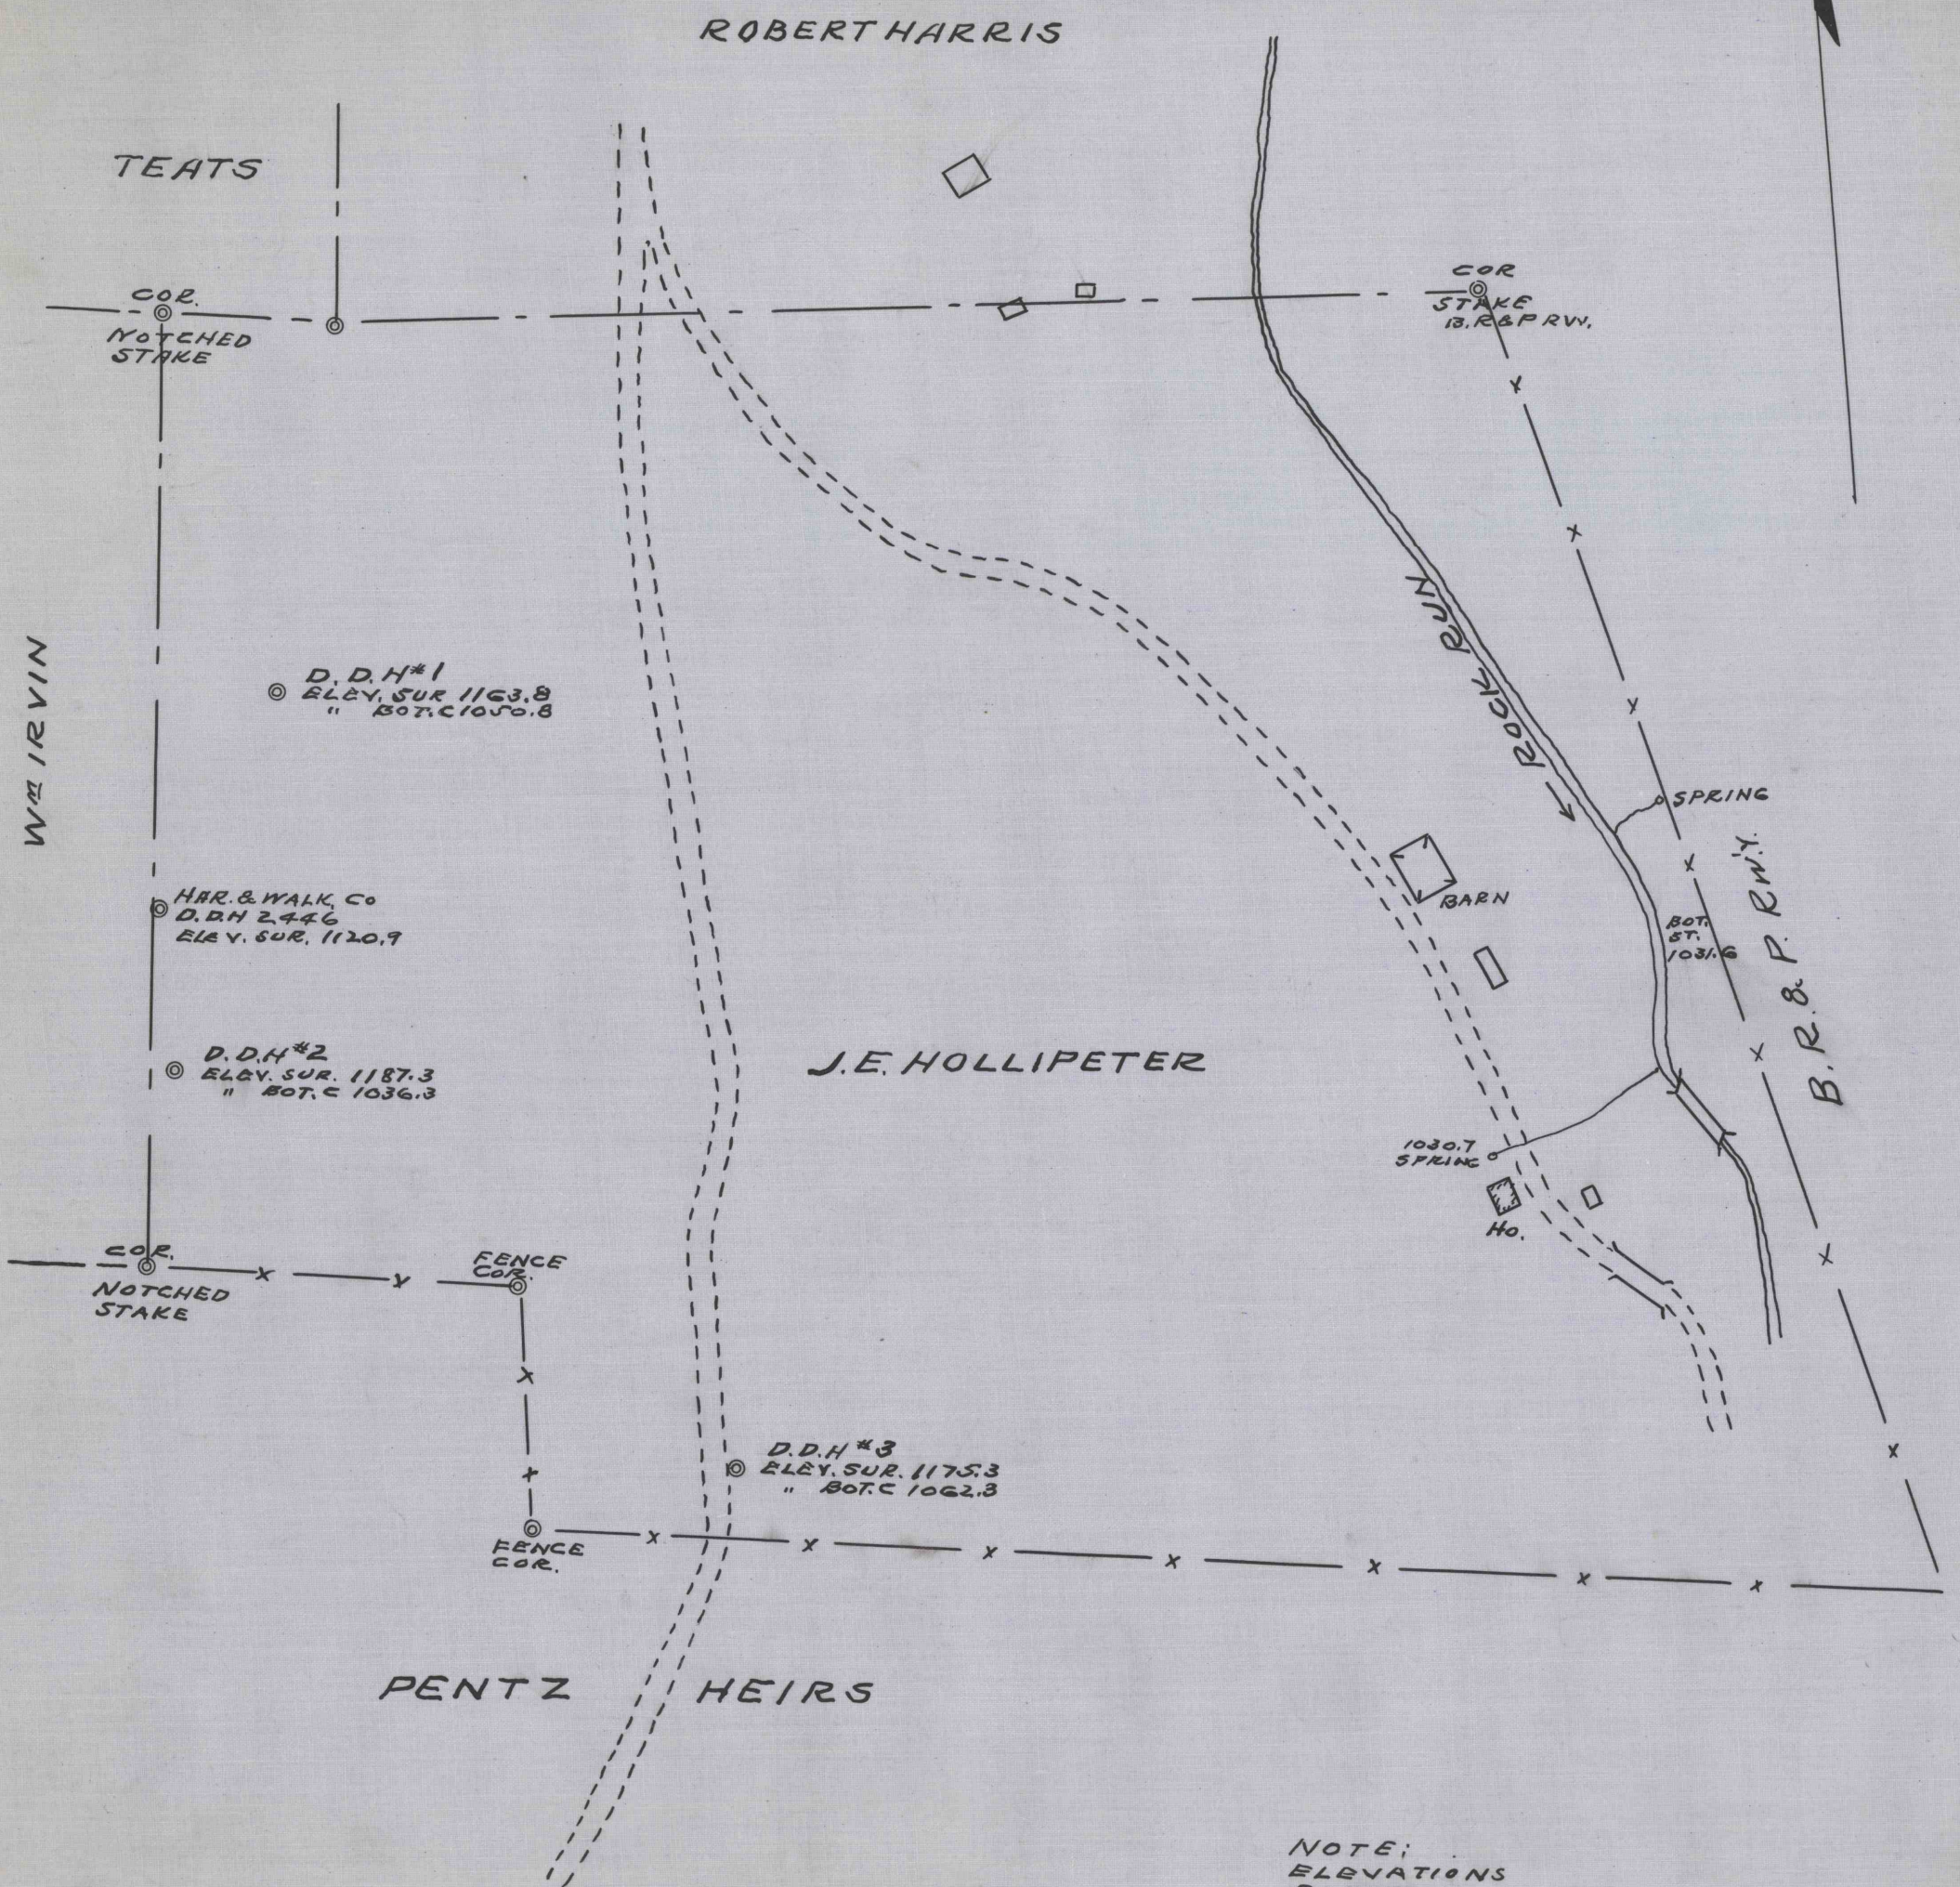

ROBERT HARRIS

TEATS

COR.
NOTCHED
STAKE

COR
STAKE
B.R. & P. R.W.Y.

W. IRVIN

D.D.H.#1
ELEV. SUR 1163.8
" BOT. C 1050.8

H.R. & WALK, CO
D.D.H. 2446
ELEV. SUR. 1120.9

D.D.H.#2
ELEV. SUR. 1187.3
" BOT. C 1036.3

J.E. HOLLIPETER

ROCK RIVER
BARN
SPRING
BOT. ST. 1031.6

B.R. & P. R.W.Y.

1030.7
SPRING

Ho.

COR.
NOTCHED
STAKE

FENCE
COR.

D.D.H.#3
ELEV. SUR. 1175.3
" BOT. C 1062.3

FENCE
COR.

PENTZ HEIRS

NOTE:
ELEVATIONS
DATUM
DRAUCKER MINE