


SCALE 1 inch = 200 FT.

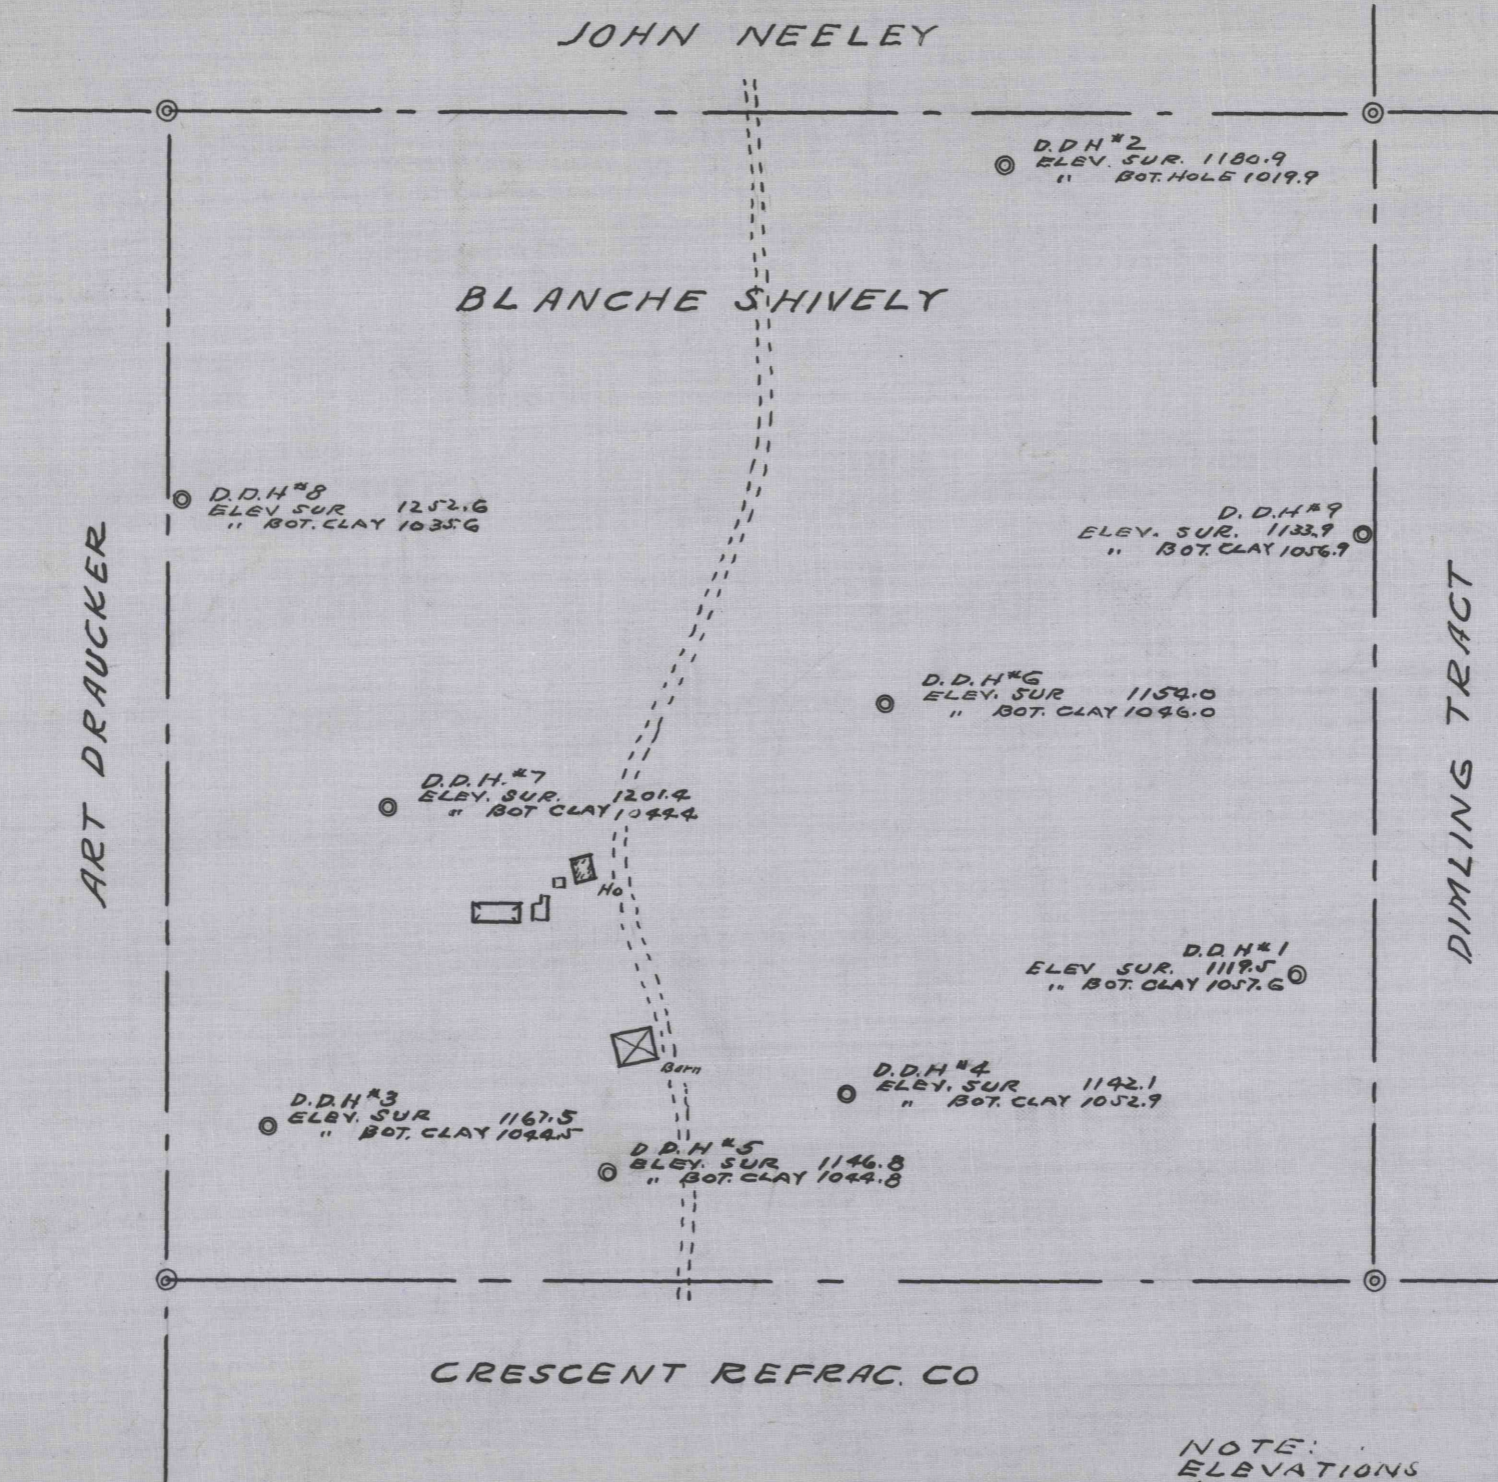

NOTE:
ELEVATIONS
DATUM
DRAUCKER MINE