


Scale 1 in. = 200 Ft.

50-3-702

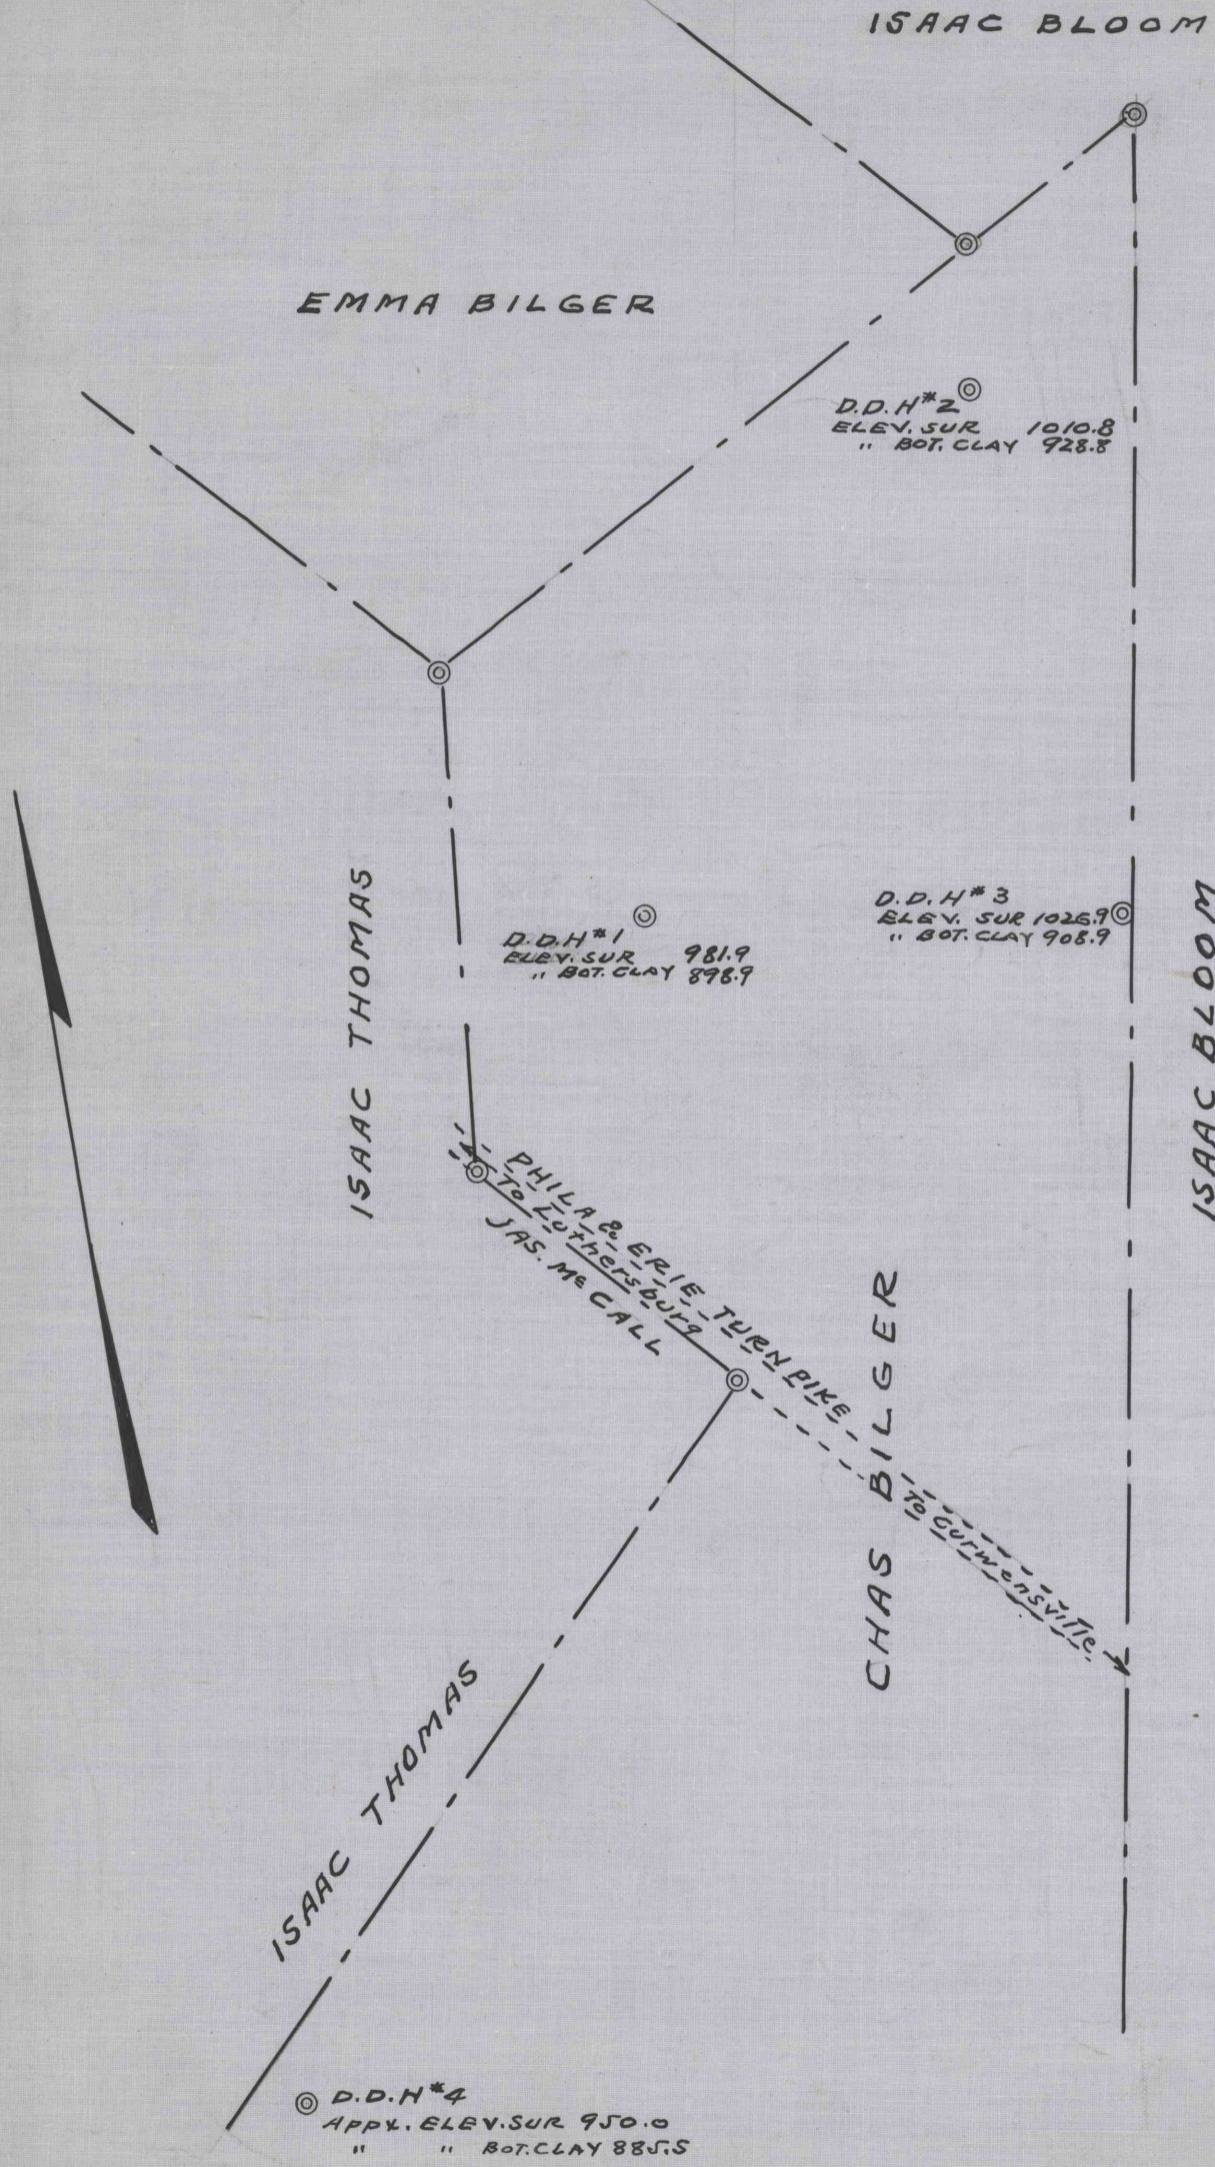

*Revised*

50-3-702

50-3-702