


scale 1" = 200ft.

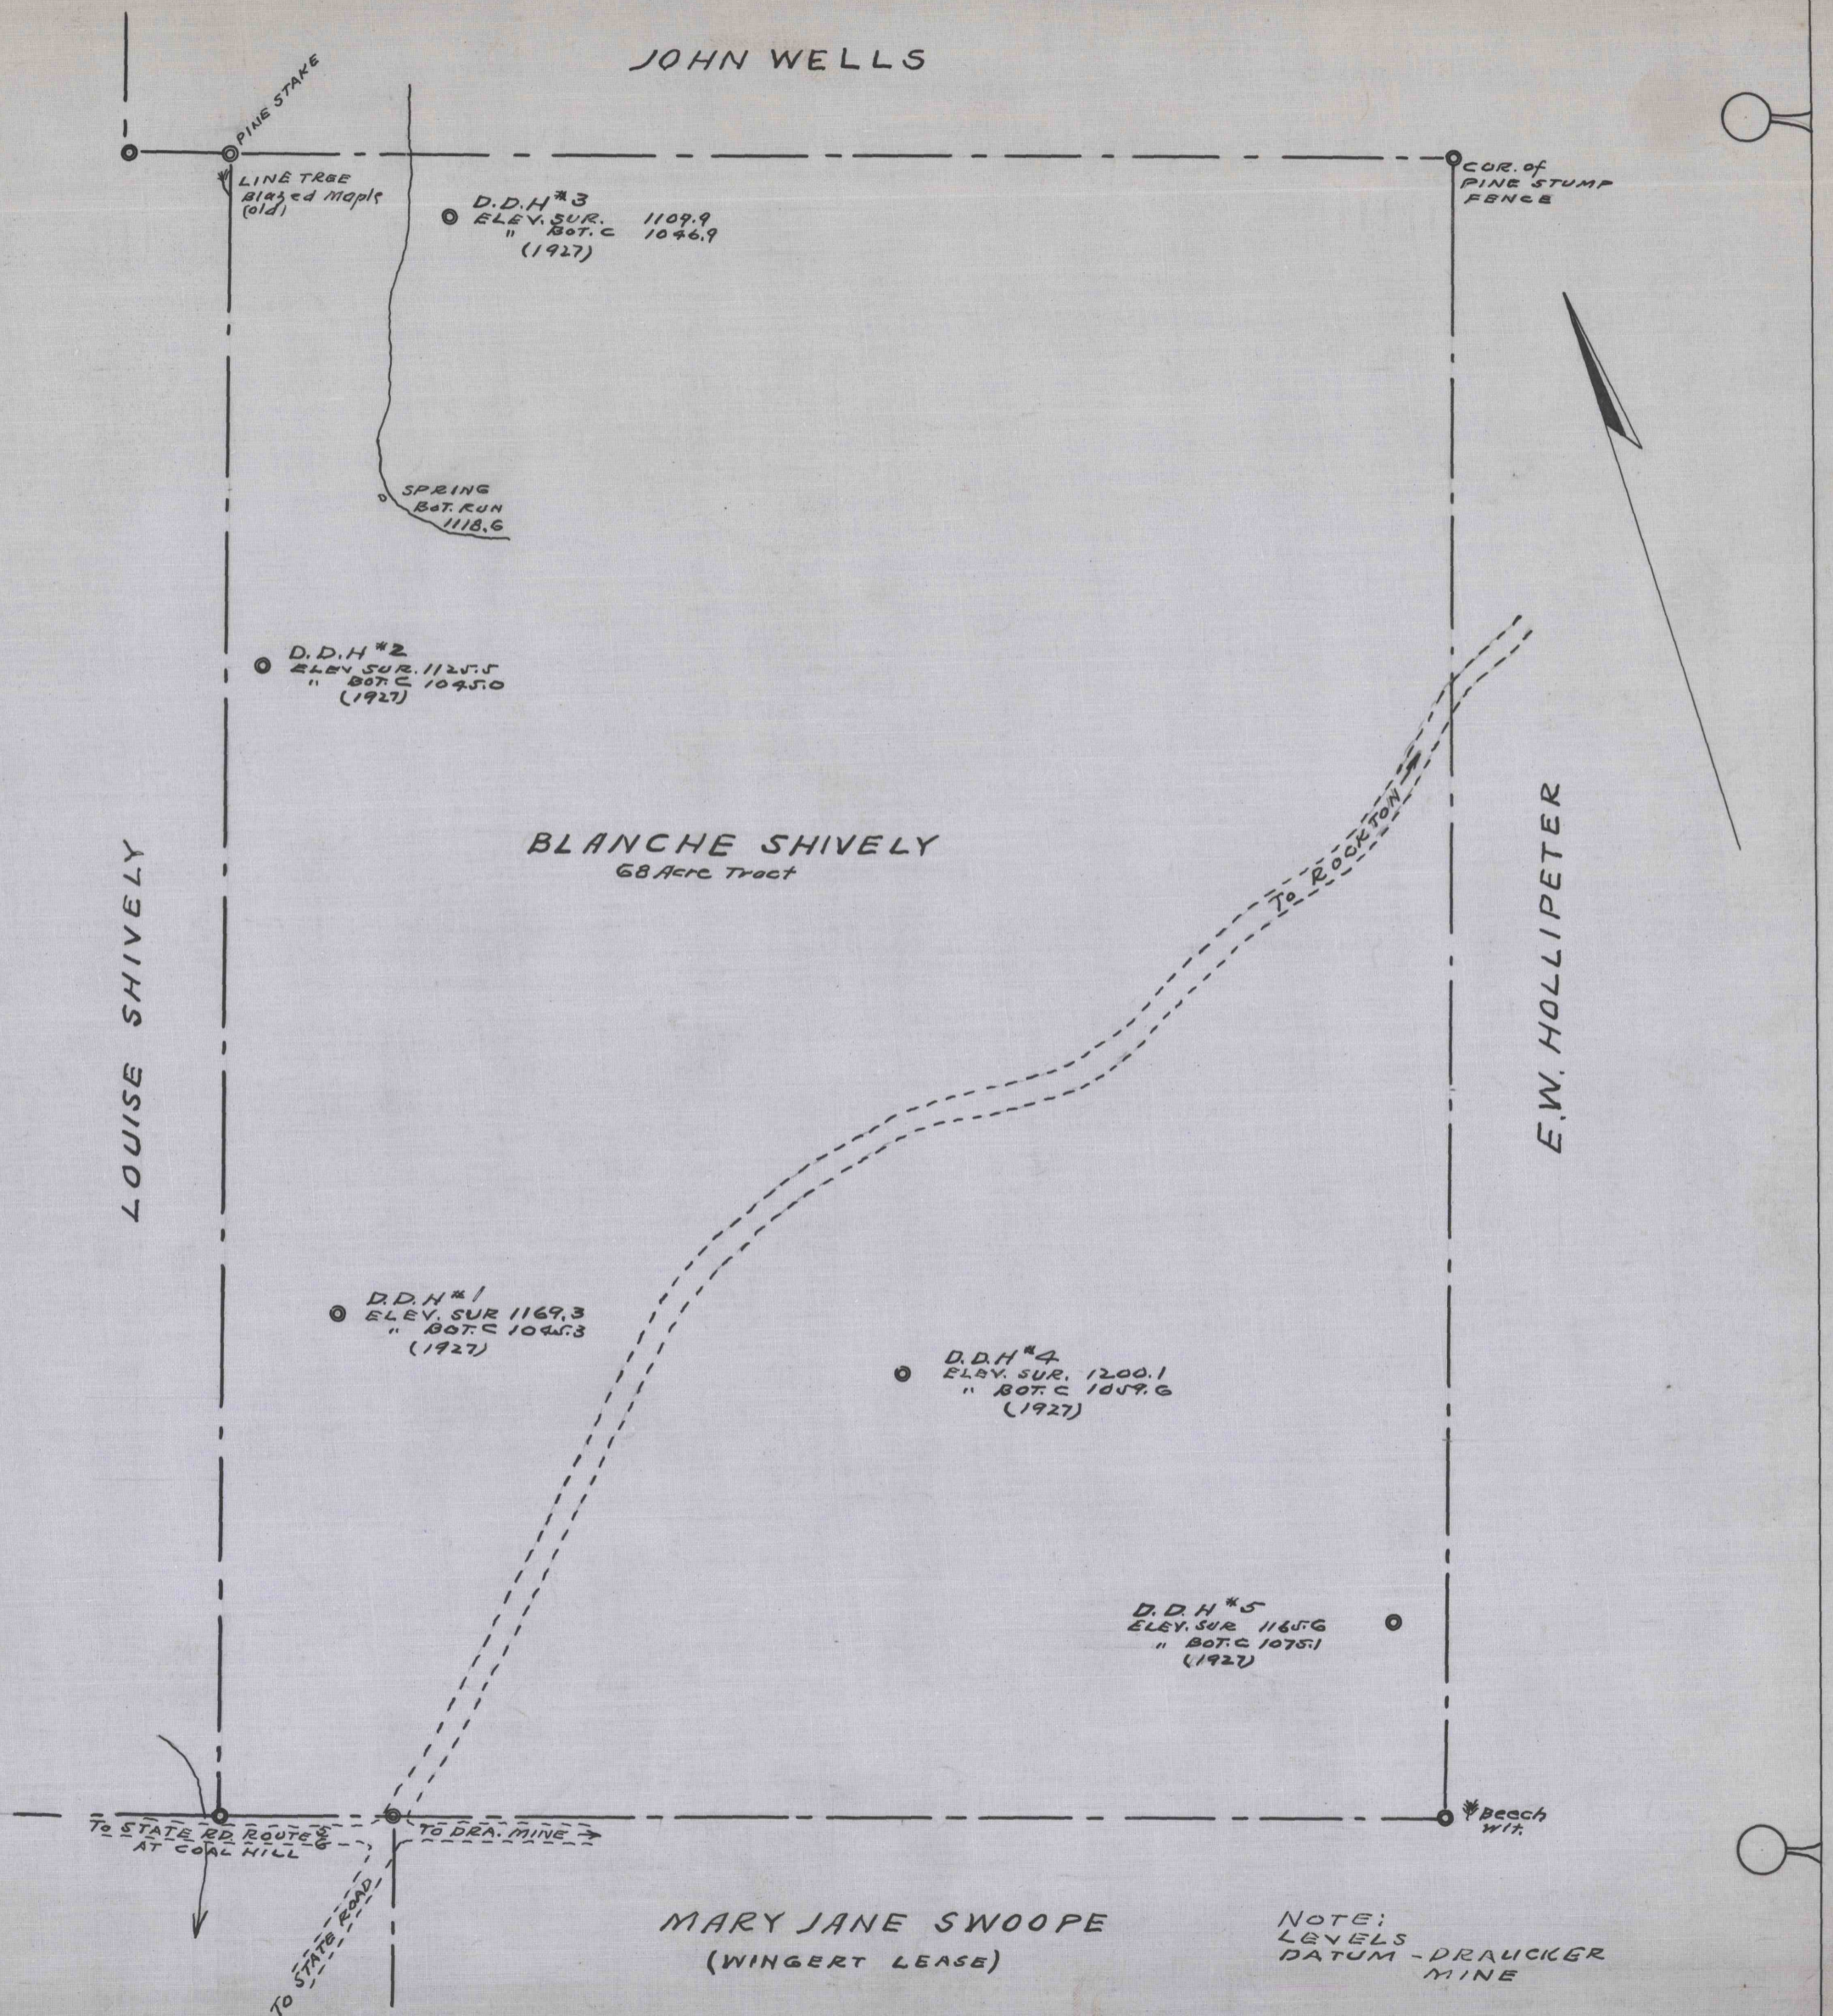

JOHN WELLS

BLANCHE SHIVELY
68 Acre Tract

LOUISE SHIVELY

MARY JANE SWOOPE
(WINGERT LEASE)

E.W. HOLLIPETER

NOTE:
LEVELS - DRAUCKER
DATUM - MINE

PINE STAKE

LINE TREE
Blazed Maple
(old)

COR. of
PINE STUMP
FENCE

D.D.H #3
ELEV. SUR. 1109.9
" B.O.T.C 1046.9
(1927)

SPRING
BOT. RUN
1118.6

D.D.H #2
ELEV. SUR. 1125.5
" B.O.T.C 1045.0
(1927)

D.D.H #1
ELEV. SUR. 1169.3
" B.O.T.C 1045.3
(1927)

D.D.H #4
ELEV. SUR. 1200.1
" B.O.T.C 1049.6
(1927)

D.D.H #5
ELEV. SUR. 1165.6
" B.O.T.C 1075.1
(1927)

To STATE RD ROUTE 6
AT COAL HILL

To DEA. MINE

To STATE ROAD

To ROCKY MOUNTAIN

Beech
wit.

50-3-706

50-3-706