


Scale 1 in. = 200 Ft.

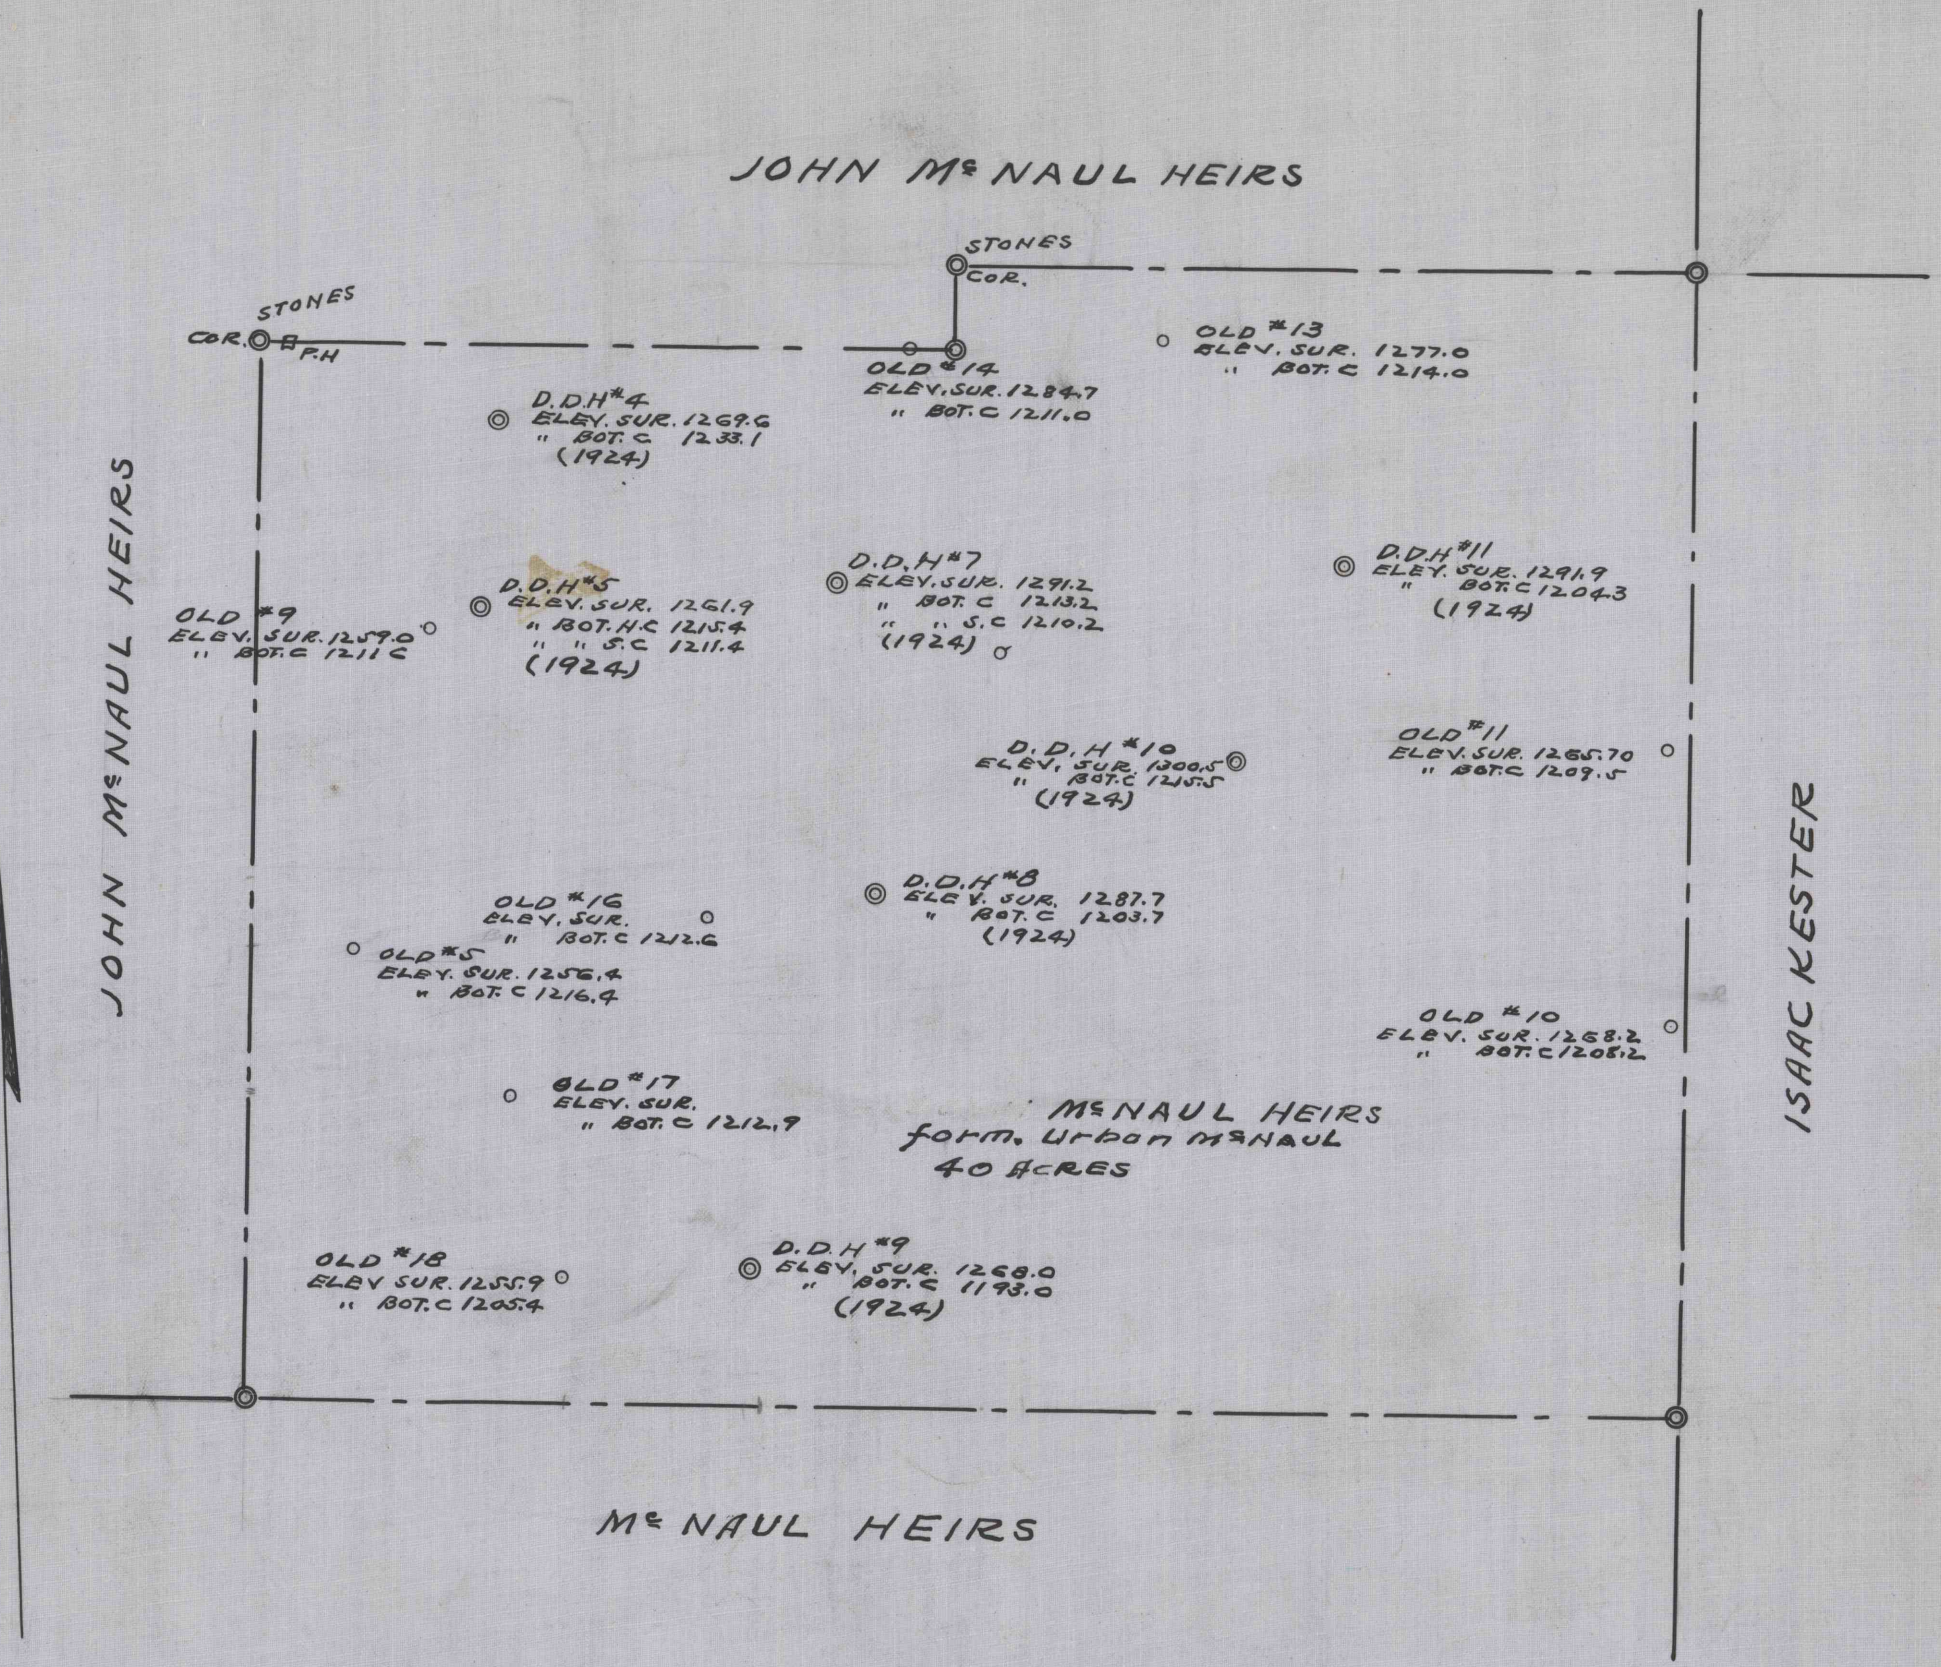

JOHN McNAUL HEIRS

JOHN McNAUL HEIRS

ISAAC KESTER

McNAUL HEIRS  
form. Urban McNAUL  
40 ACRES

McNAUL HEIRS

STONES  
COR. B.F.H.

STONES  
COR.

OLD #13  
ELEV. SUR. 1277.0  
" BOT. C 1214.0

D.D.H.#4  
ELEV. SUR. 1269.6  
" BOT. C 1233.1  
(1924)

OLD #14  
ELEV. SUR. 1284.7  
" BOT. C 1211.0

D.D.H.#11  
ELEV. SUR. 1291.9  
" BOT. C 1204.3  
(1924)

OLD #9  
ELEV. SUR. 1259.0  
" BOT. C 1211.0

D.D.H.#5  
ELEV. SUR. 1261.9  
" BOT. H.C 1215.4  
" " S.C 1211.4  
(1924)

D.D.H.#7  
ELEV. SUR. 1291.2  
" BOT. C 1213.2  
" " S.C 1210.2  
(1924)

D.D.H.#10  
ELEV. SUR. 1300.5  
(1924)

OLD #11  
ELEV. SUR. 1265.70  
" BOT. C 1209.5

OLD #16  
ELEV. SUR.  
" BOT. C 1212.6

D.D.H.#8  
ELEV. SUR. 1287.7  
" BOT. C 1203.7  
(1924)

OLD #5  
ELEV. SUR. 1256.4  
" BOT. C 1216.4

OLD #10  

OLD #17  
ELEV. SUR.  
" BOT. C 1212.9

OLD #18  
ELEV. SUR. 1255.9  
" BOT. C 1205.4

D.D.H.#9  
ELEV. SUR. 1268.0  
" BOT. C 1193.0  
(1924)