

SI-E-07

SI-E-07

# NORTH AMERICAN REFRACTORIES CO.


1012 NATIONAL CITY—EAST 6TH BUILDING  
CLEVELAND 14, OHIO

ENV. No. 70-3-12  
SHEET No.

## MAP SHOWING 1953 DRILLING ON LAB TRACT - STRASBURG, OHIO

SCALE 1" = 200'

DATE 5-12-54

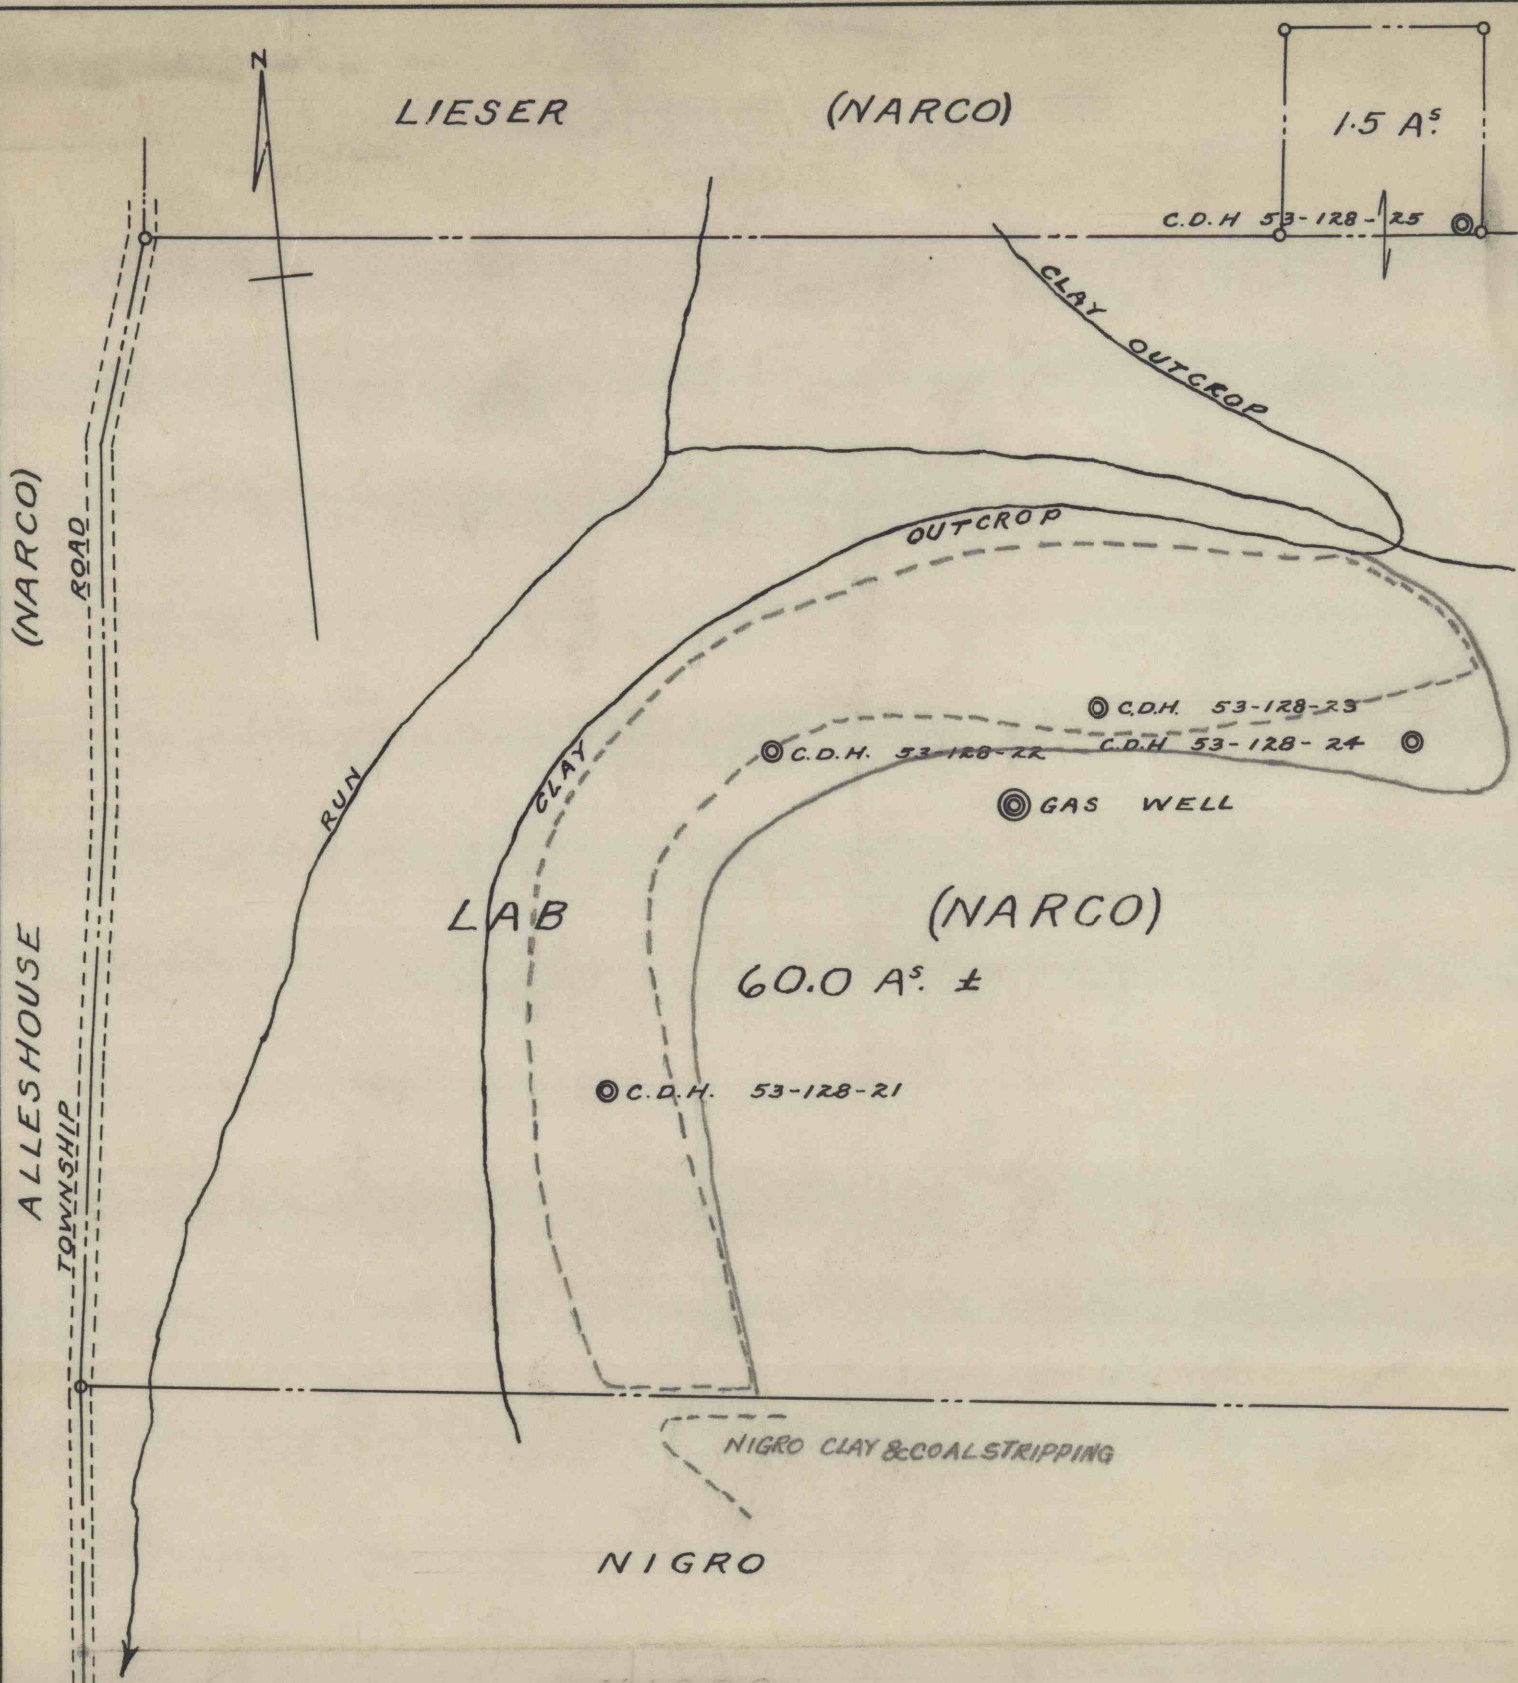

REVISION

DRAWN J.R.H., Jr.

CHECKED *J.R.H.*

REFERENCE: