90-2-10

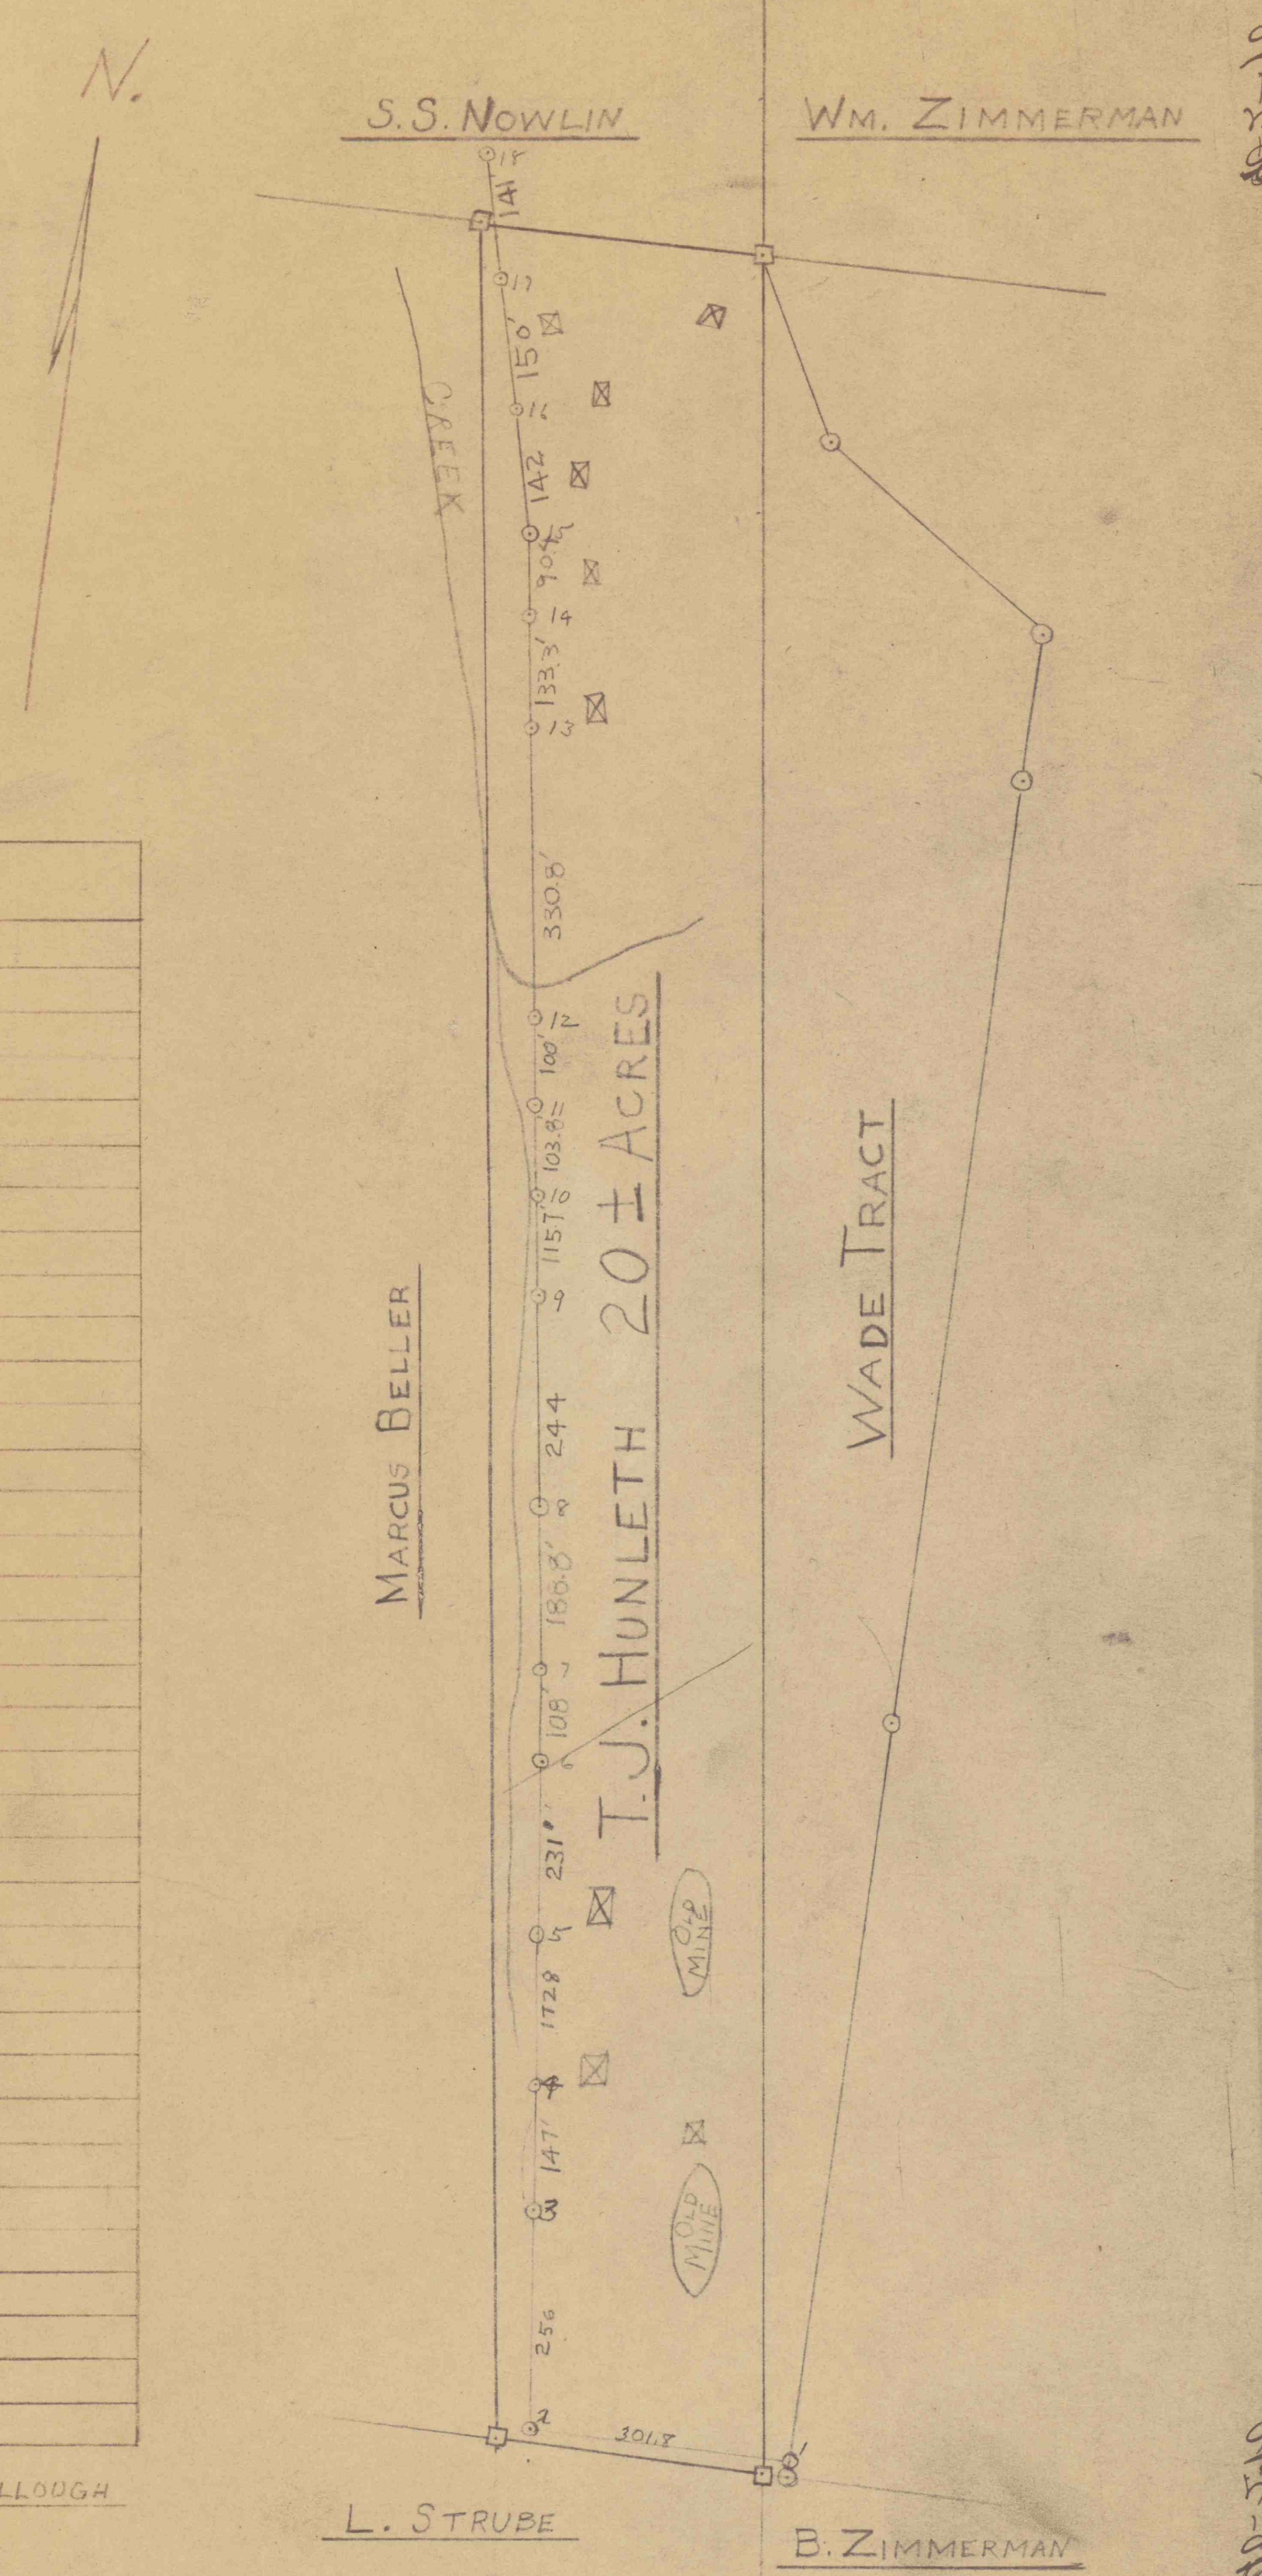

* LEGEND OF TEST HOLES		
No.	Overburden	Results
		NO CLAY

* AS REPORTED BY GORDON McCULLOUGH

⊠ PROSPECT TEST HOLE, NO CLAY

\+ PROSPECT TEST HOLE WITH CLAY

REV. 7/8/37, R.C.H.

NORTH AMERICAN REFRACTORIES CO.
CLEVELAND, OHIO

SERBIE & McCULLOUGH TRACT # 5
T. J. HUNLETH 20 ACRES

SURVEY R.C. HUTCHINSON	DATE 5/30/37	90-2-10
TRACED R.C.H.	SCALE 1" = 200	
CHECKED	REF.	