

**\* LEGEND OF TEST HOLES**


TEST No.	OVERBURDEN	RESULTS	BOTTOM
1	1'	10 1/2' FLINT CLAY	SAND ROCK
2	2'	7 1/2' FLINT CLAY	SAND ROCK
3	MINE	6 1/2' " " 3' PINK FLINT	SAND ROCK

\* As REPORTED BY GORDON McCULLOUGH

**NORTH AMERICAN REFRACTORIES CO.**  
 CLEVELAND, OHIO.  
 JAMES STEM TRACT  
 149 ACRES

SURVEY R.C. HUTCHINSON DATE 7/1/37  
 TRACED BY R.C.H. SCALE 1" = 200'  
 CHECKED WM3 REF. REF.  
**90-2-18**

☒ PROSPECT TEST HOLE NO CLAY  
 + PROSPECT TEST HOLE WITH CLAY  
 REV. 7/8/37 R.C.H.  
 REV. 8/4/37 R.C.H.

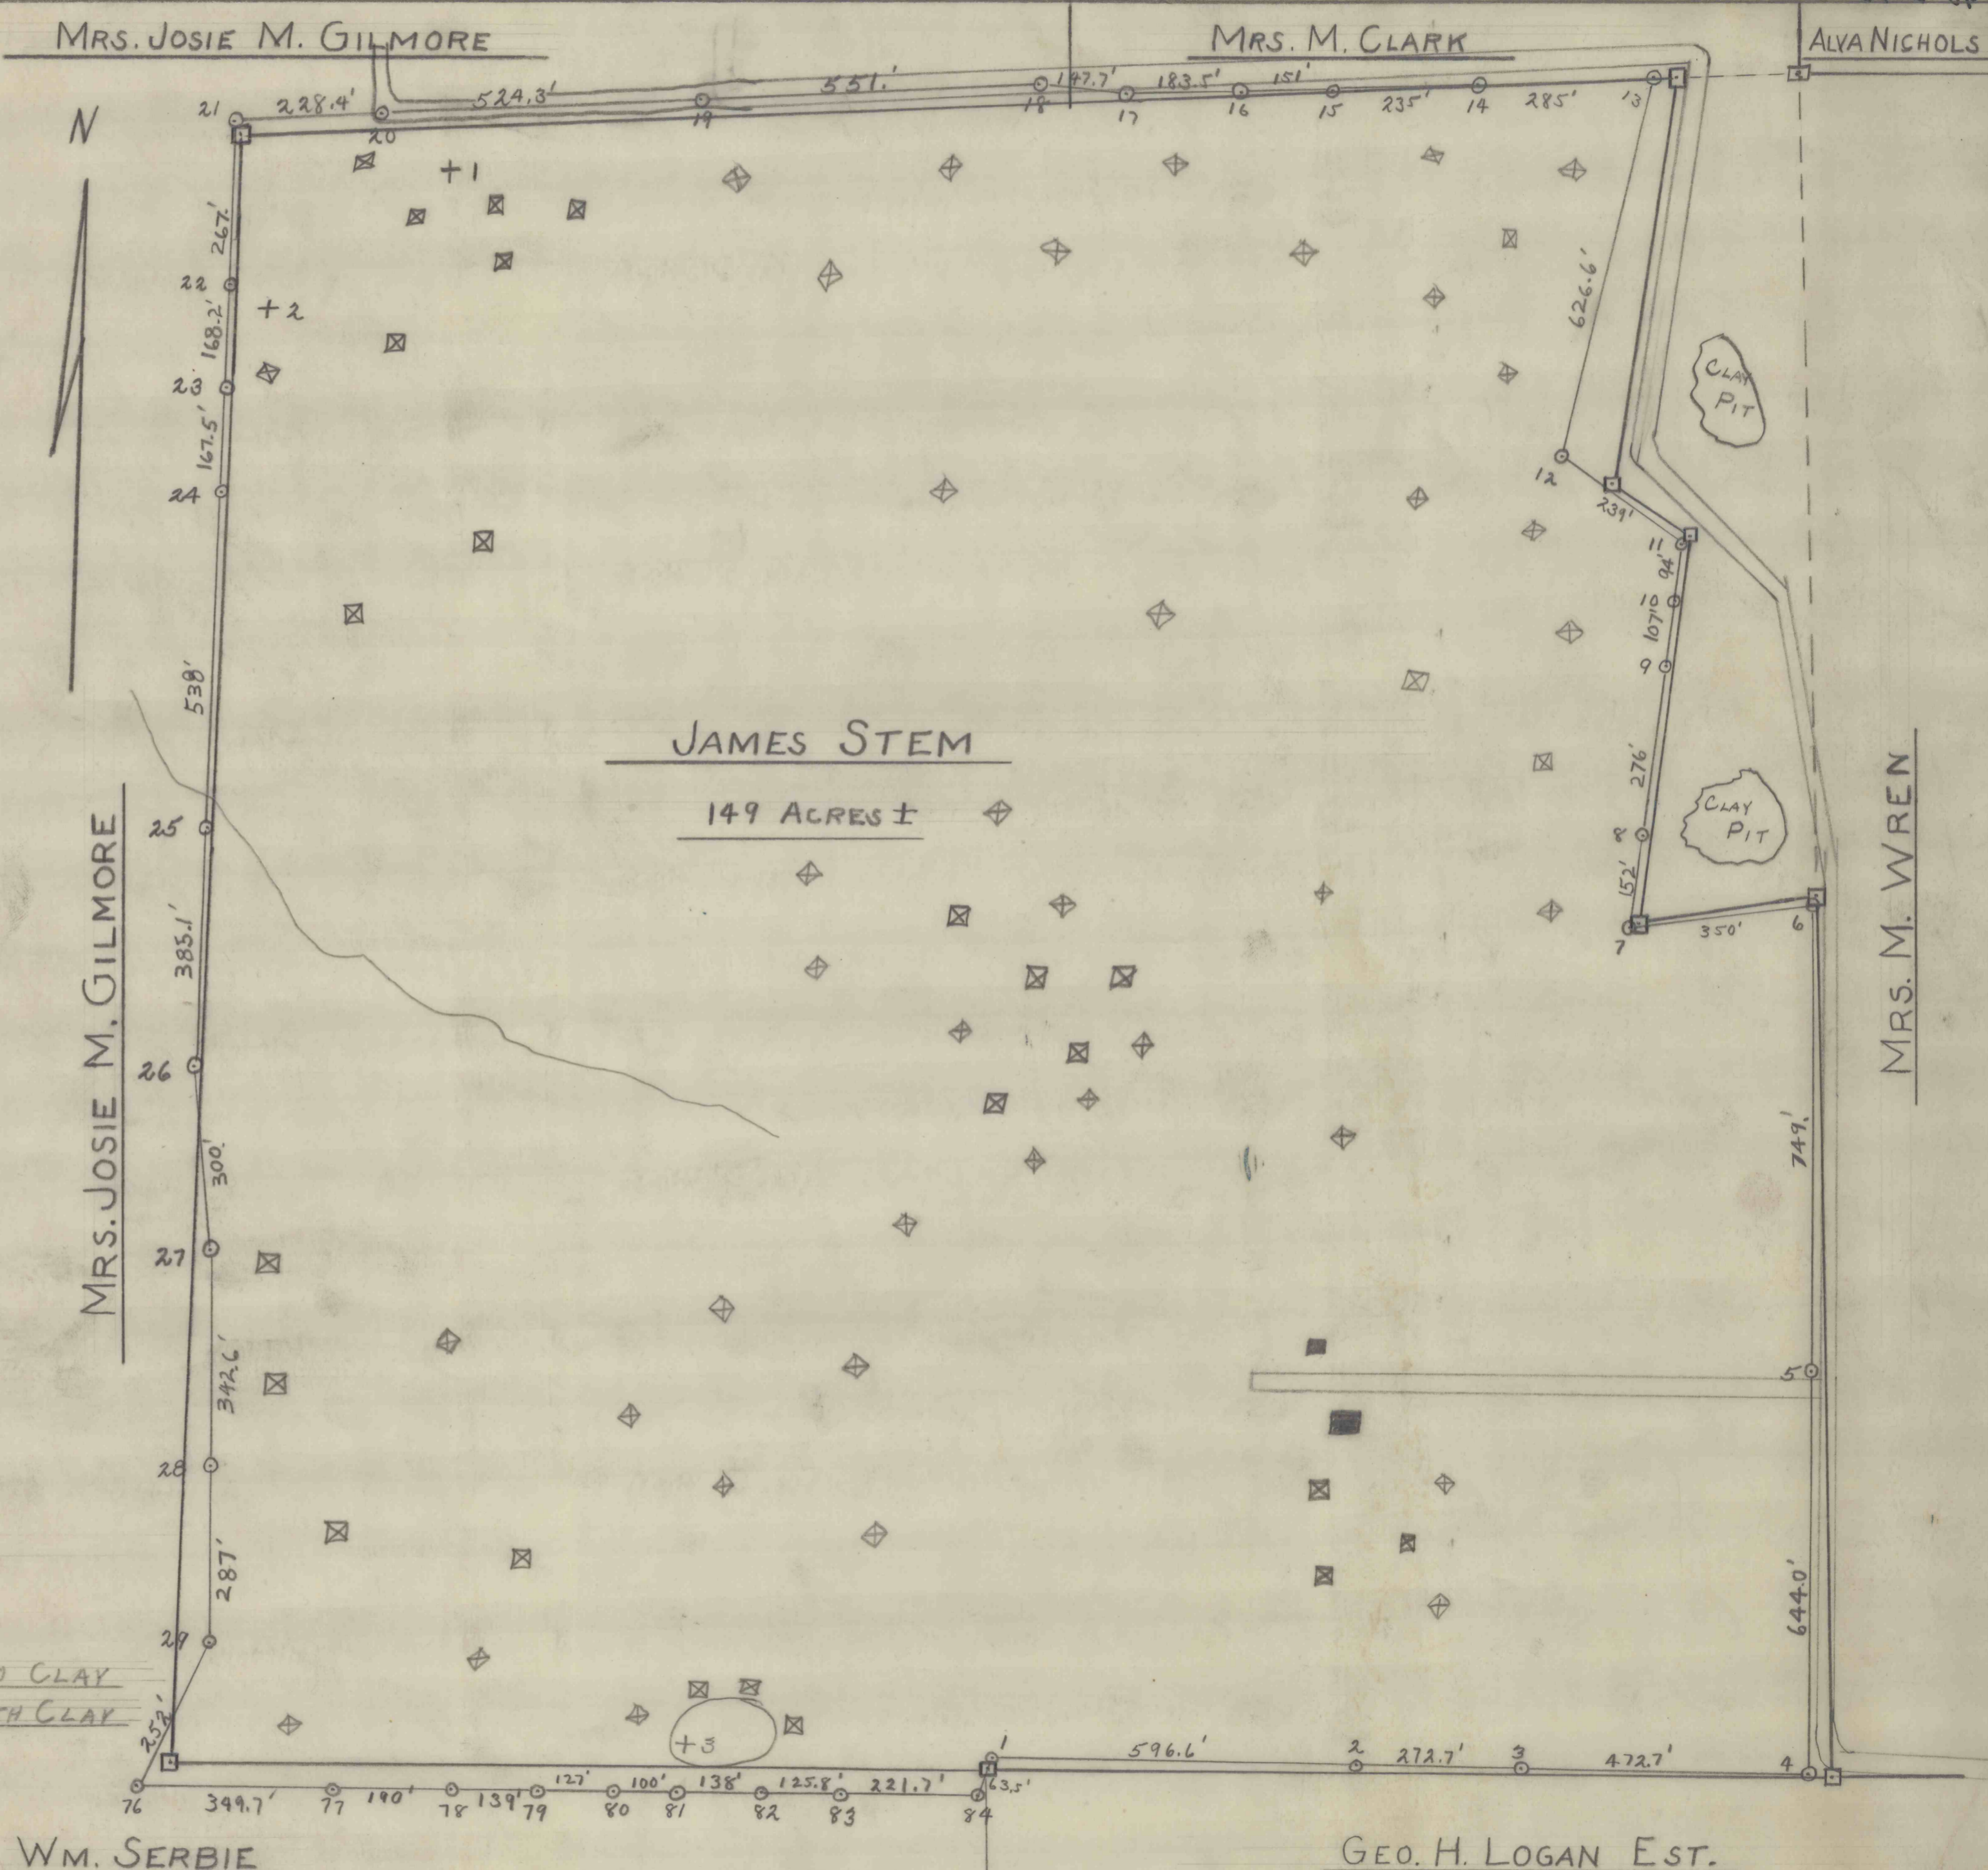

Wm. Serbie

GEO. H. LOGAN EST.