

REFERENCE DATA


**BICKFORD FIRE BRICK COMPANY**  
CURWENSVILLE, CLEARFIELD COUNTY, PA.  
ENGINEERING DEPARTMENT

ENV. No. I-1  
SHEET No. 57  
50-3-190

Approximate Clay Area and Location Drill Holes  
Vesco-Bloom et al.

SCALE 300' = 1"

DATE Aug. 18, 1915.

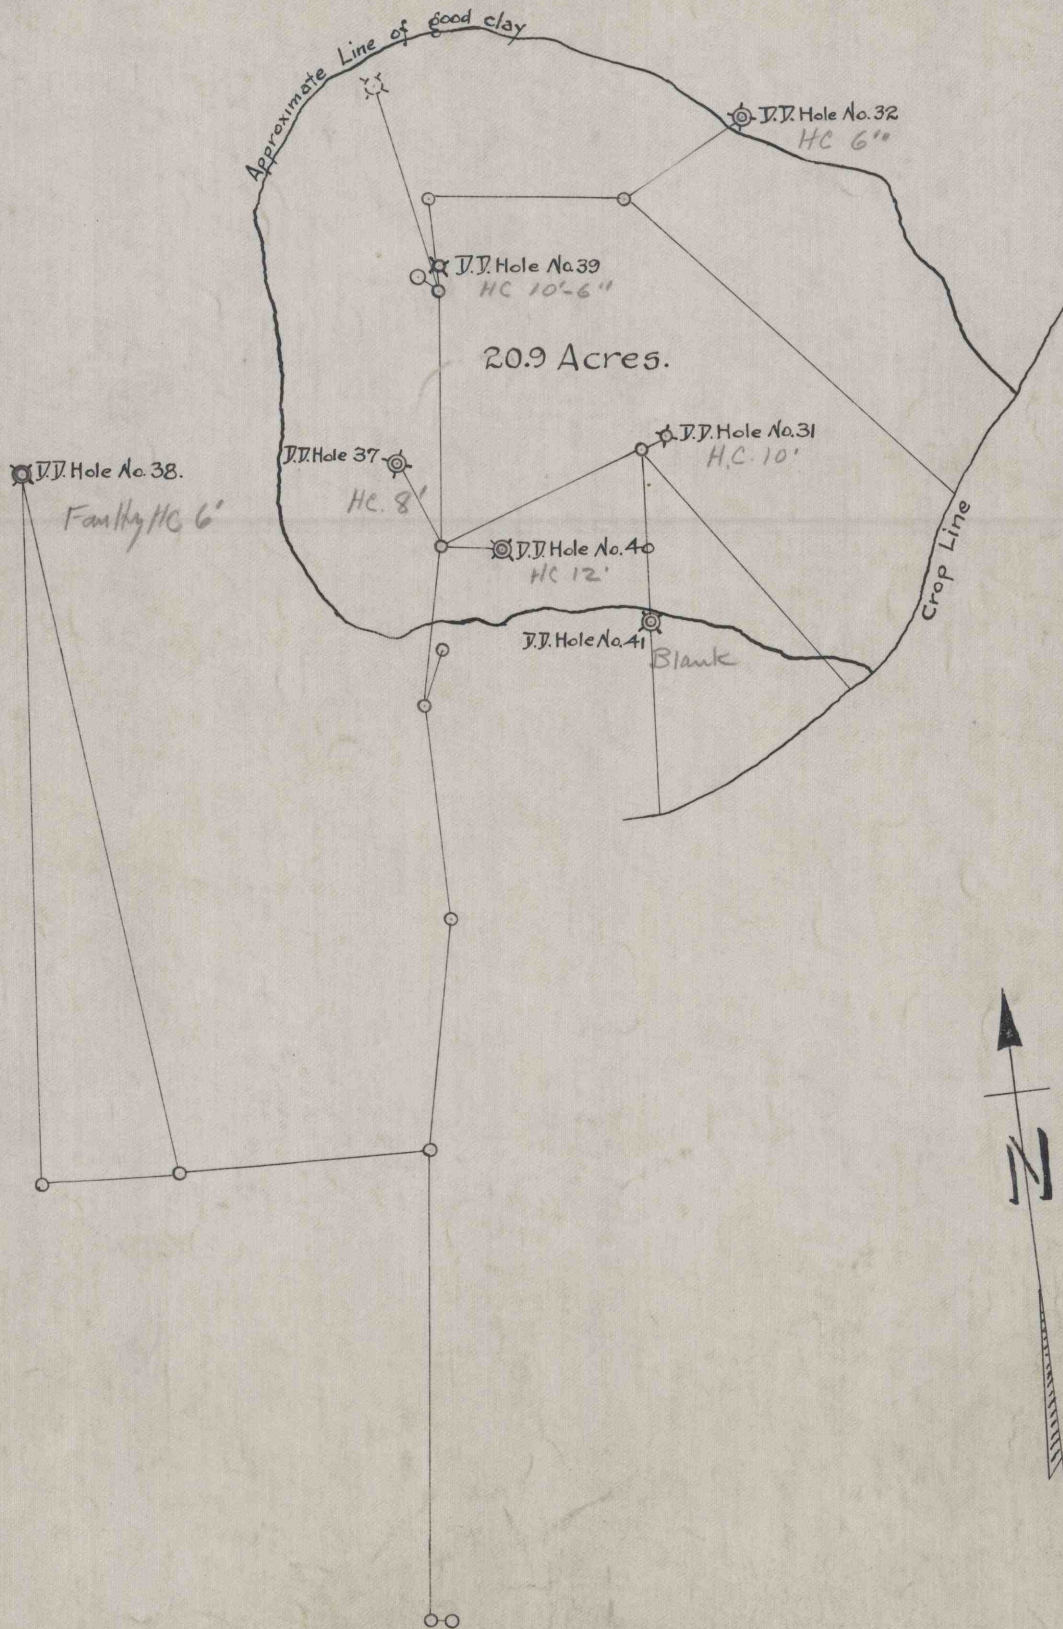

WORKED FROM

DRAWN BY ERT.

CHECKED BY 