REFERENCE DATA

BICKFORD FIRE BRICK COMPANY

CURWENSVILLE, CLEARFIELD COUNTY, PA.

ENGINEERING DEPARTMENT

ENV. NO. M2

SHEET NO. ~~45~~

50-3-428

Isaac Kester Tract

SCALE 300' = 1 Inch

DATE 3-25-1916.

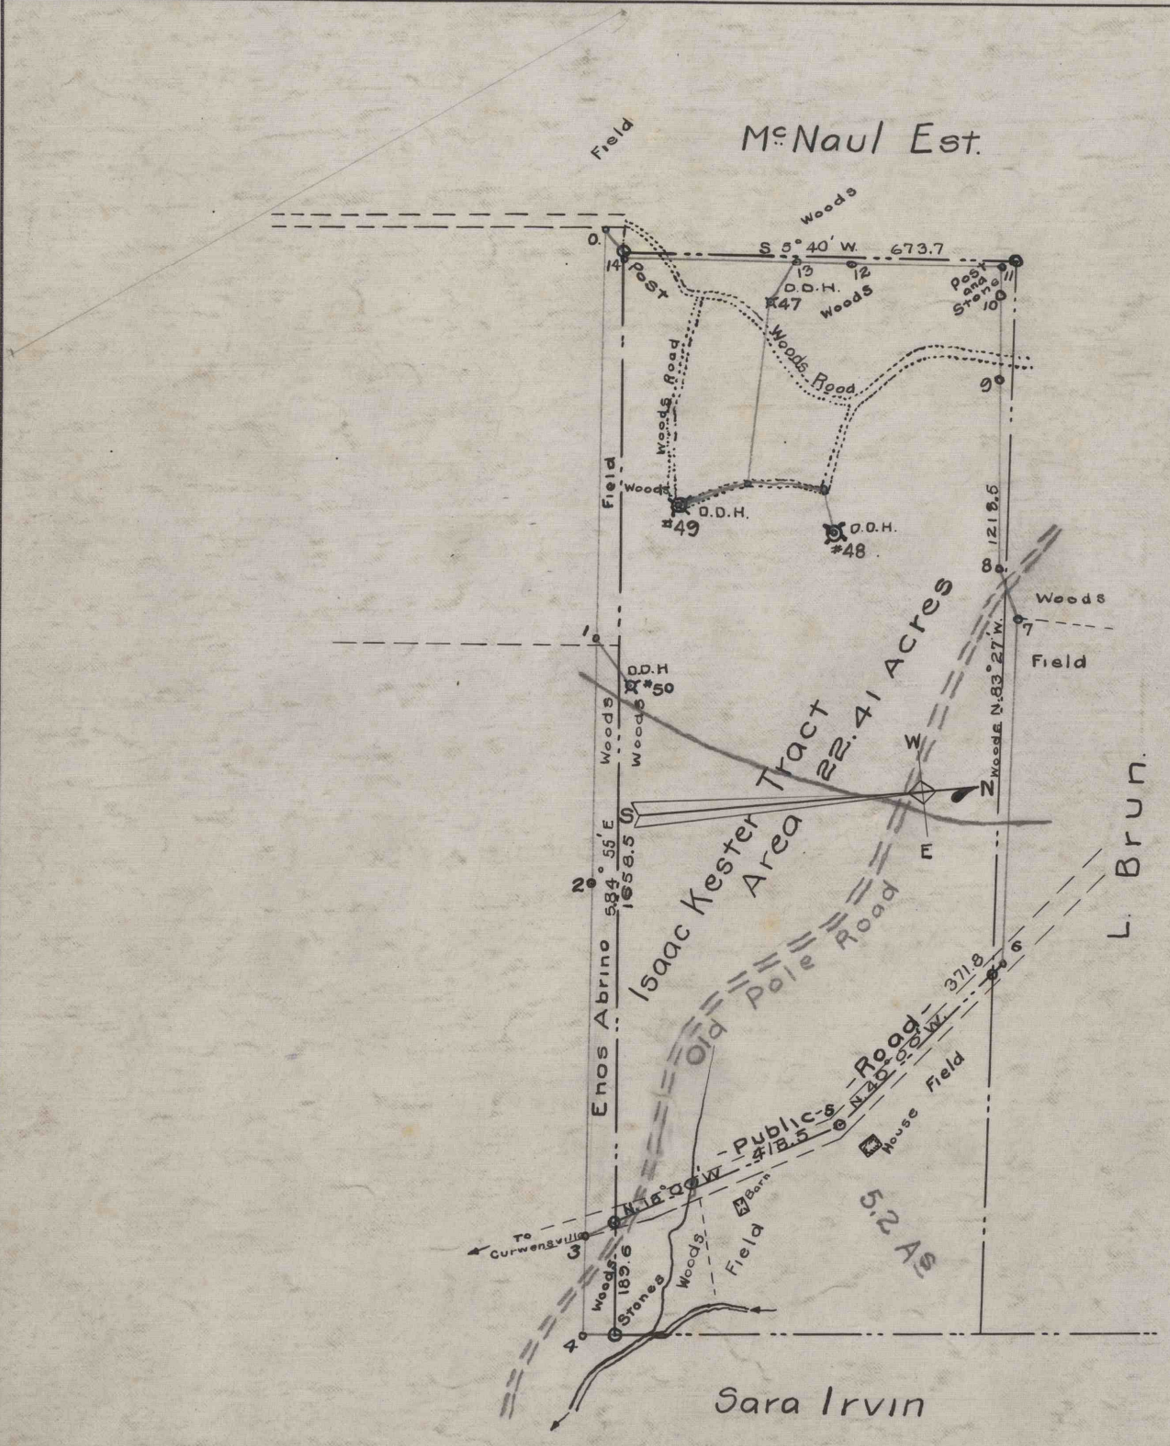

WORKED FROM -Hese- 12-20-1915.

DRAWN BY HF

CHECKED BY