


SCALE 1 in = 300 ft.

HENRY PENTZ HEIRS

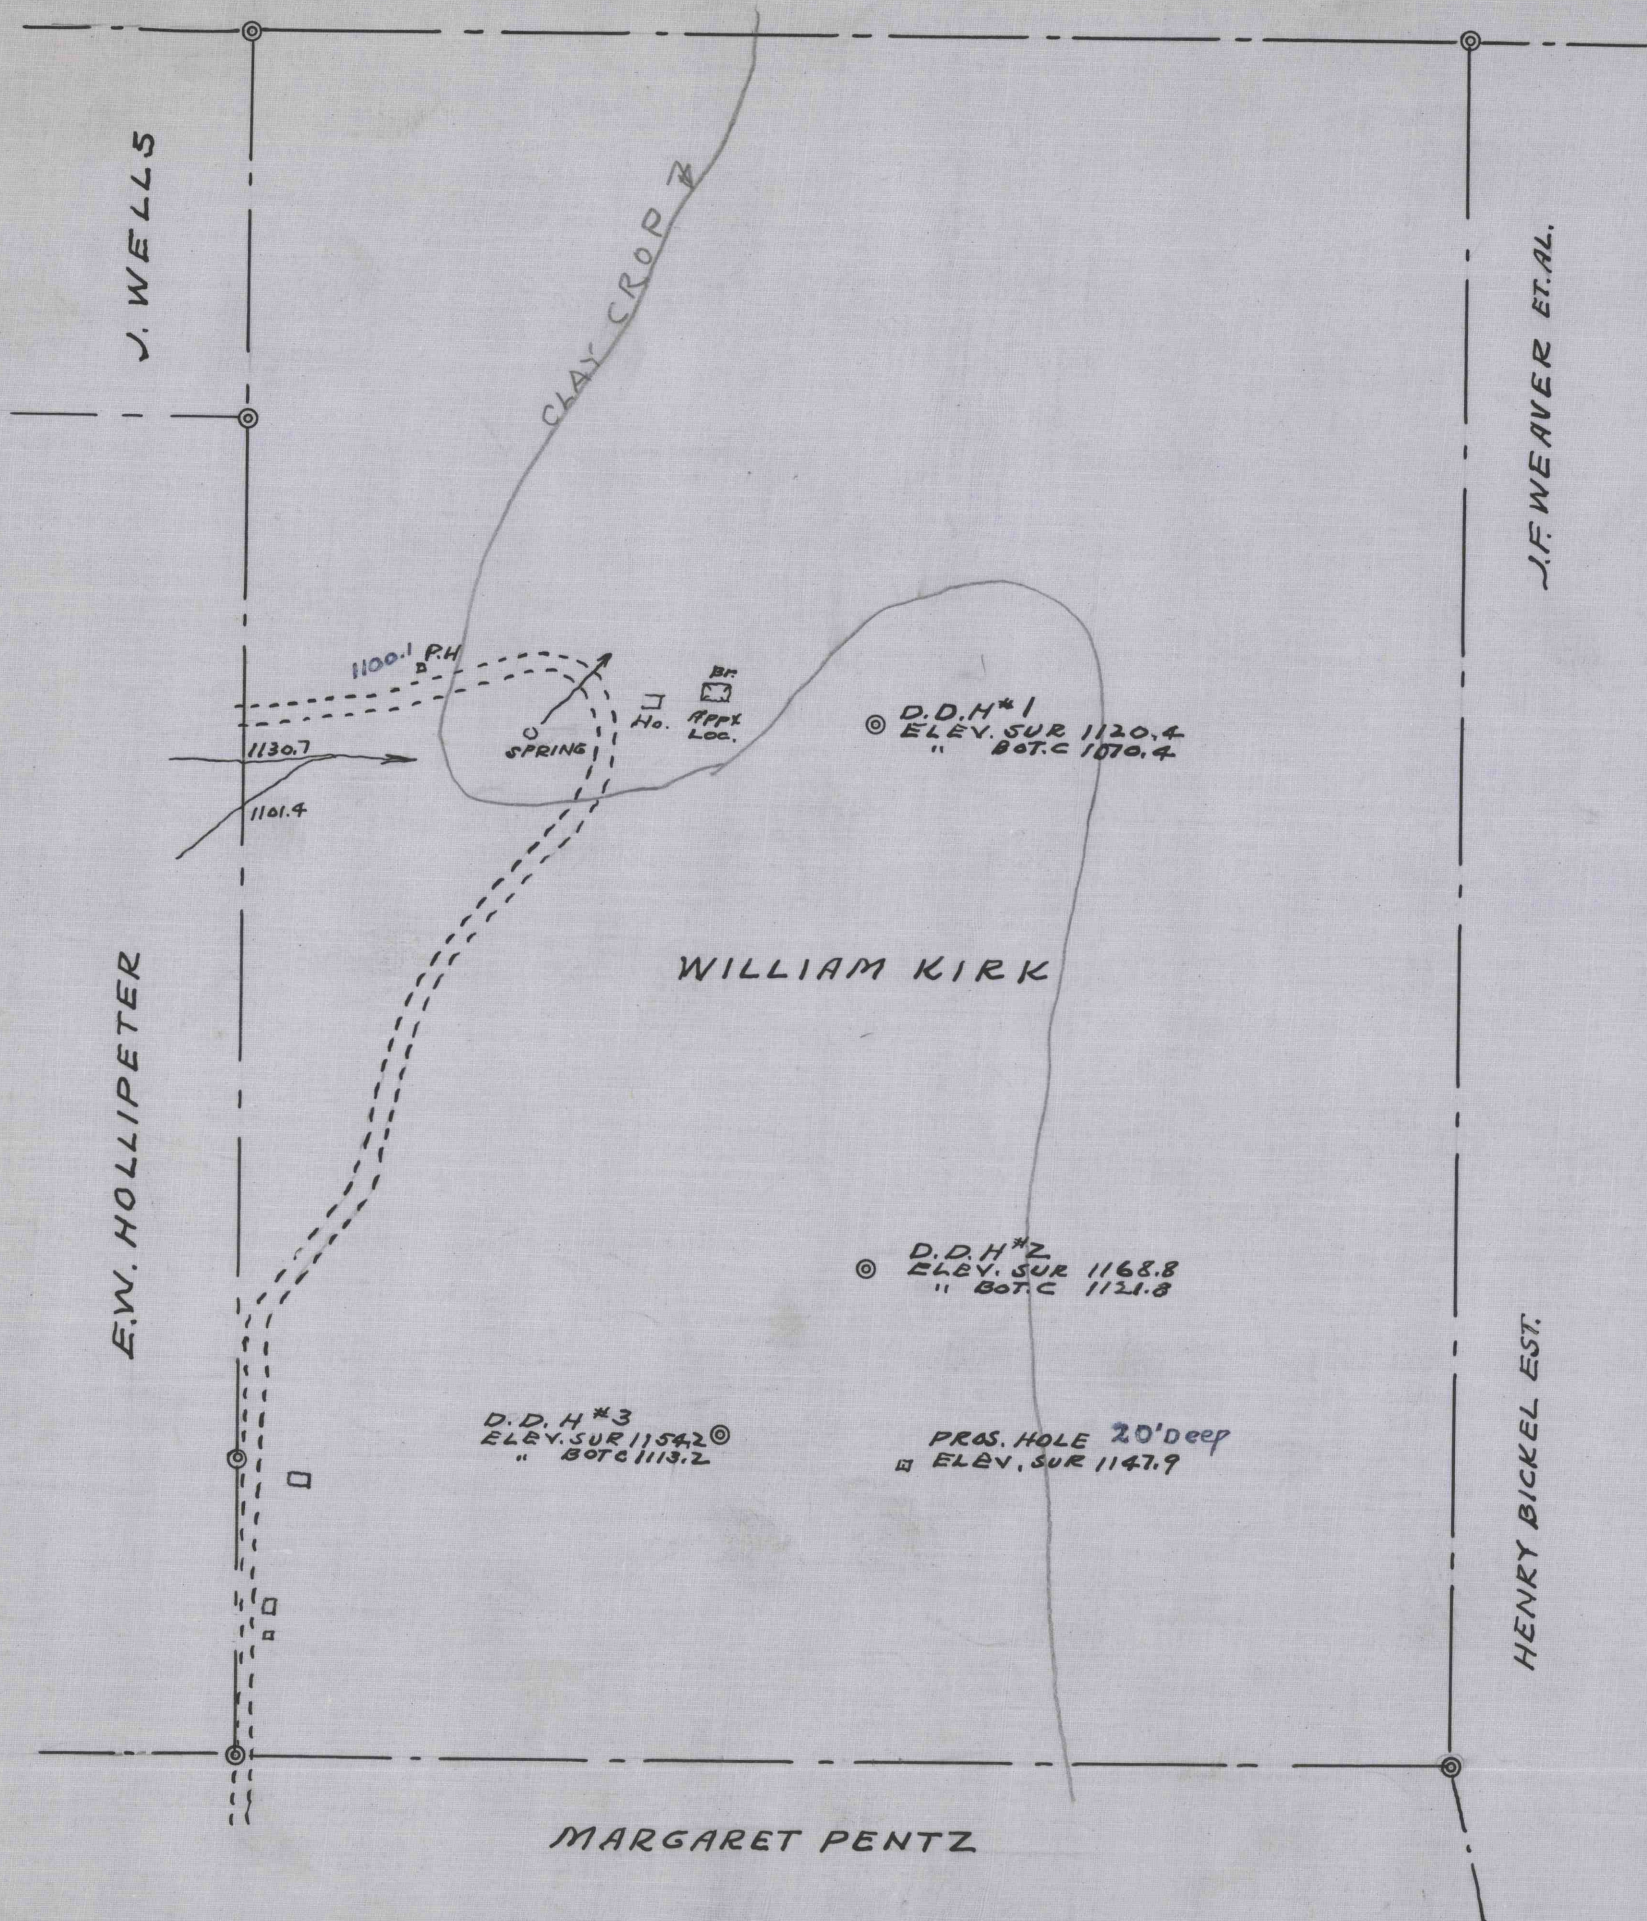

J. WELLS

J.F. WEAVER ET. AL.

E.W. HOLLIPETER

WILLIAM KIRK

HENRY BICKEL EST.

MARGARET PENTZ

D.D.H #1
ELEV. SUR 1120.4
" BOT. C 1070.4

D.D.H #2
ELEV. SUR 1168.8
" BOT. C 1121.8

D.D.H #3
ELEV. SUR 1154.2
" BOT. C 1113.2

PROS. HOLE 20' deep
ELEV. SUR 1147.9

100-1 PH

1130.7

1101.4

SPRING

BR.
Ho.
APPX.
Loc.