


SCALE 1" = 300'

MOORE OWENS

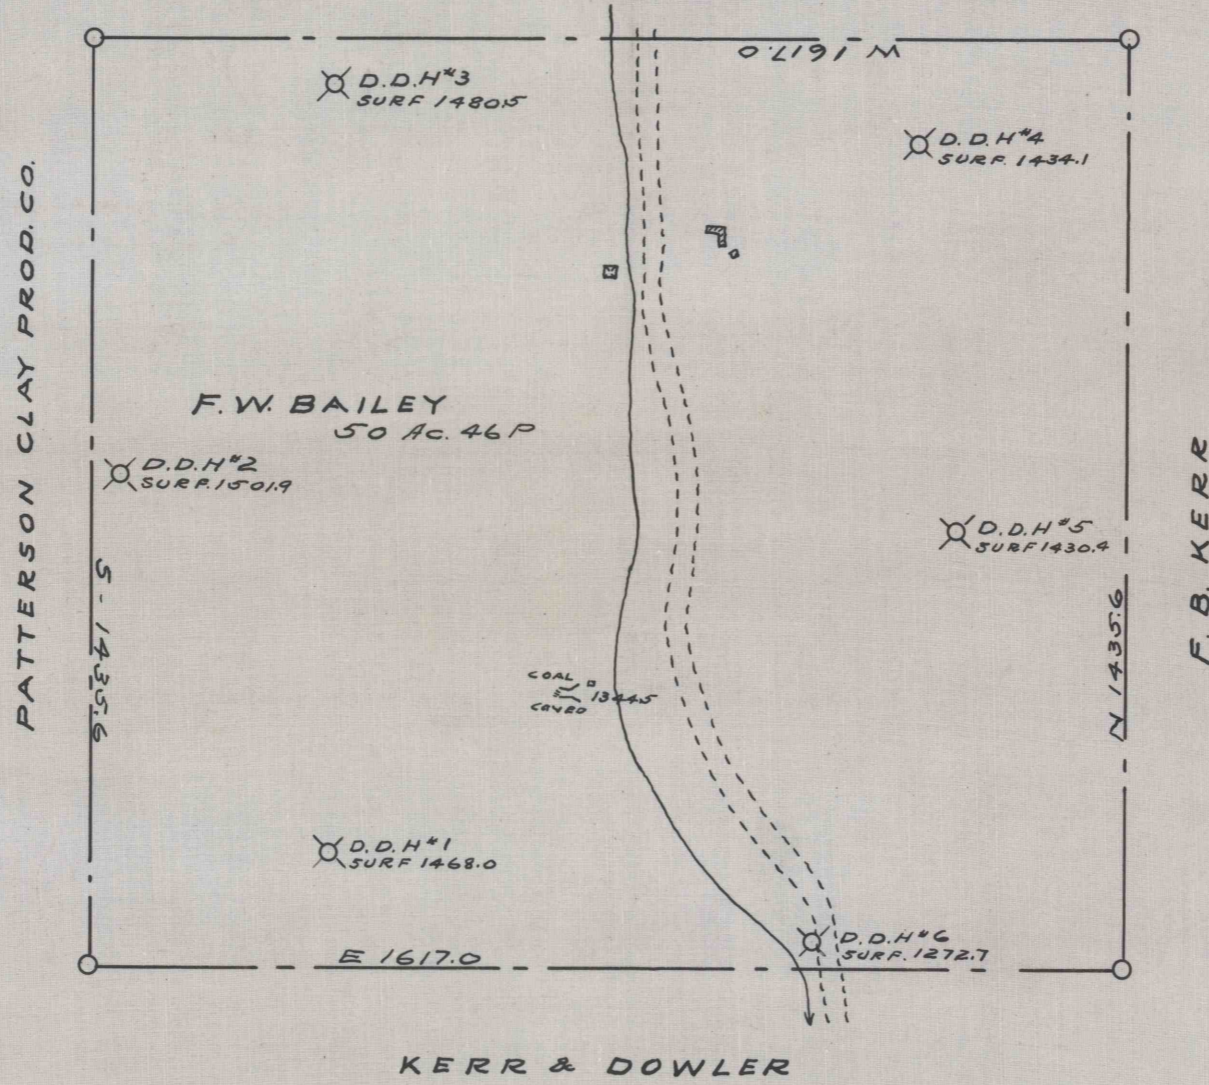

50-3-688