


Scale 1 in. = 300 Ft.

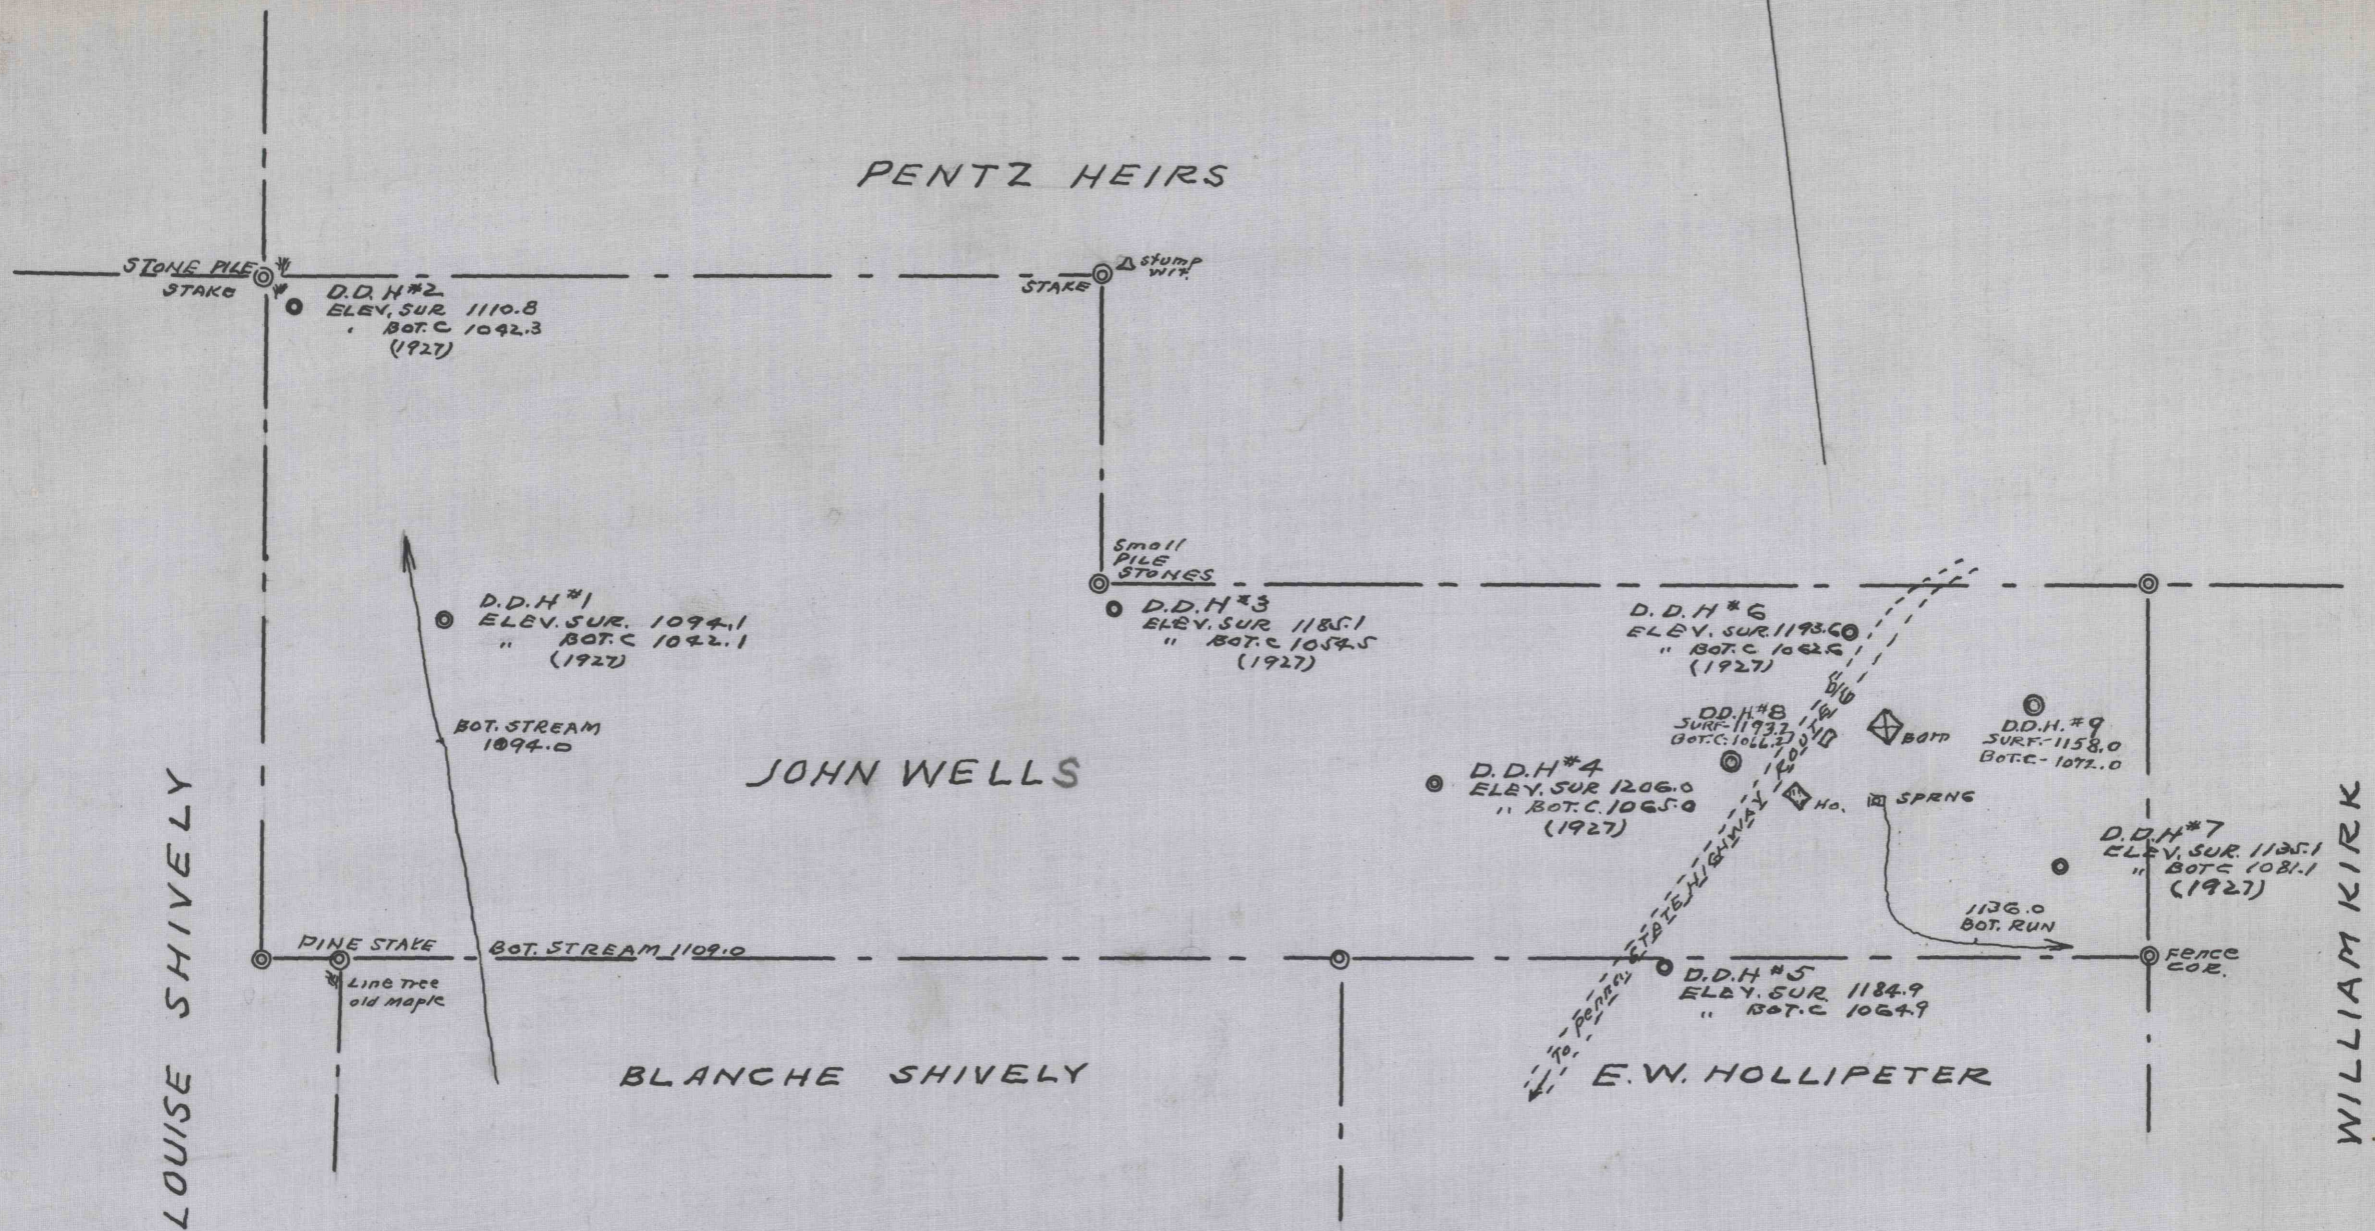

NOTE:
Levels
Draucker Mine Datum