


20-3-766

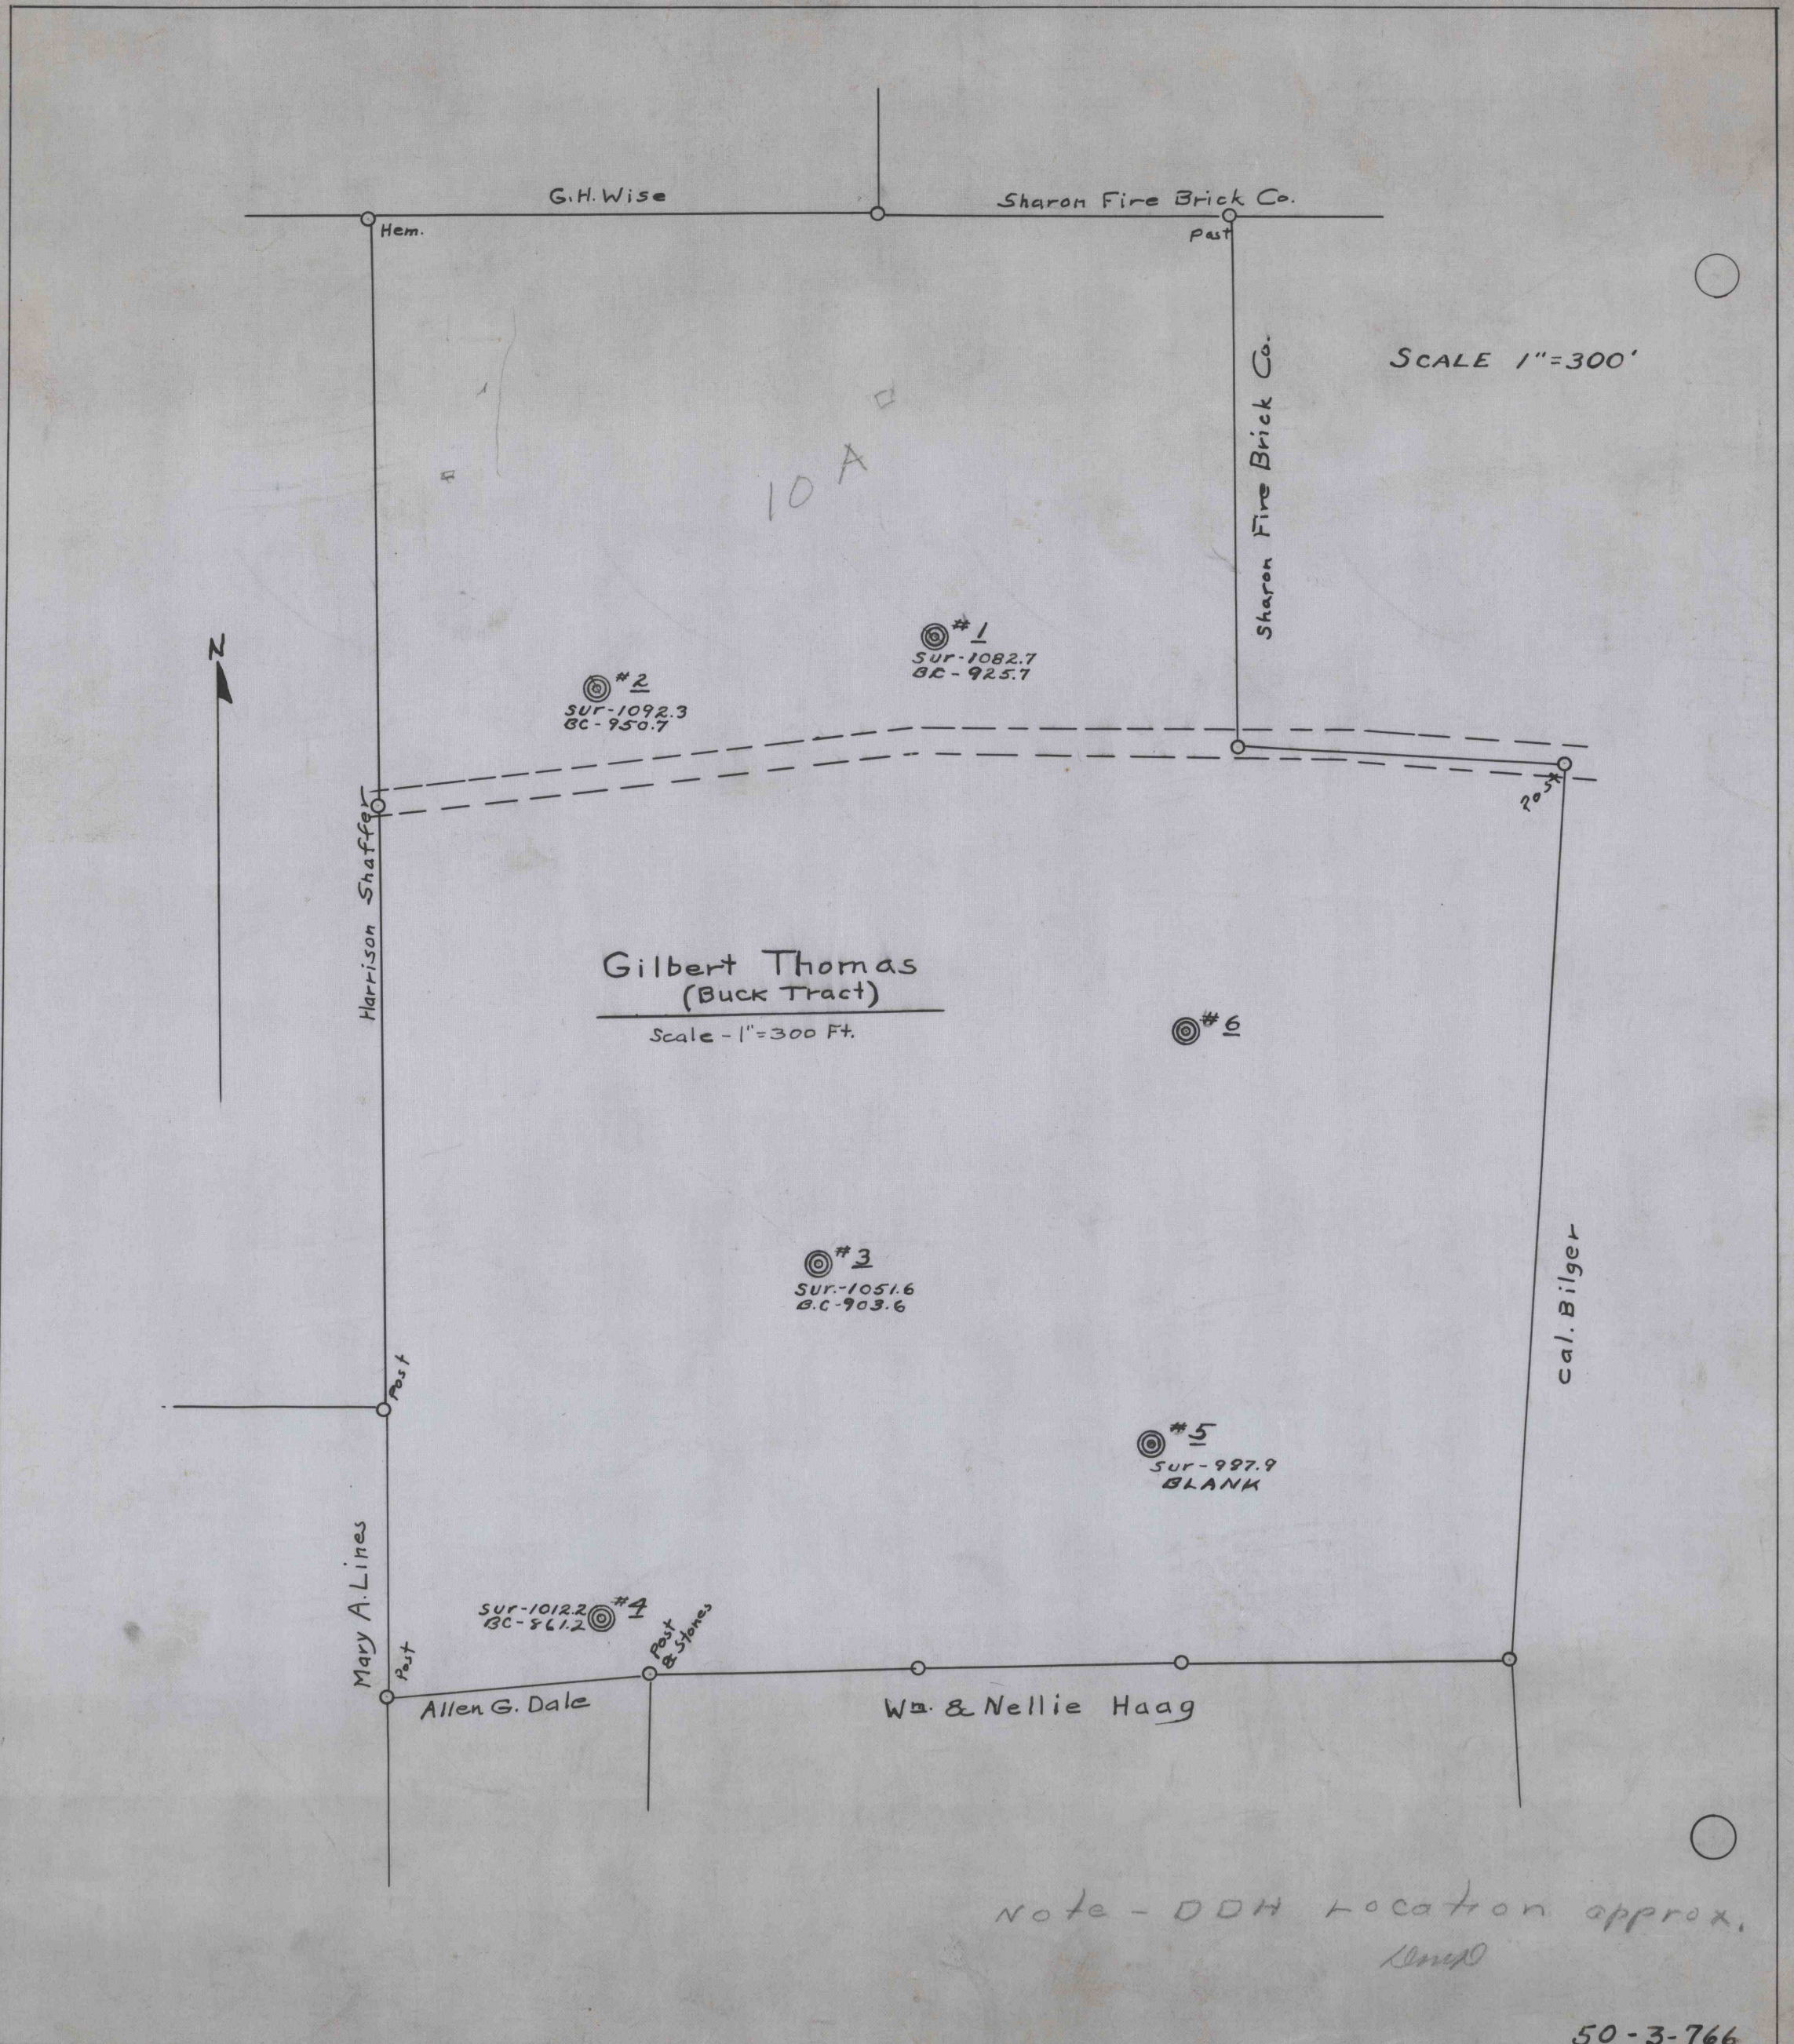

Note - DDH location approx. 10mp

50-3-766

to be cross indexed to the best

20-3-766