

20-3-152

SCHOLONAKER

N 64° 56' E 3775.1'

D.D.H. 52-124-13
El. Sur. 1192.93
El. B.C. 1125.93

D.D.H. 52-124-10
El. Sur. 1205.21
El. B.C. 1130.71

D.D.H. 52-124-1
El. Sur. 1228.60
El. B.C. 1132.52

D.D.H. 52-124-11
El. Sur. 1224.84
El. B.C. 1134.84

D.D.H. 52-124-9
El. Sur. 1224.71
El. B.C. 1139.21

D.D.H. 52-124-2
El. Sur. 1221.75
El. B.C. 1140.92

D.D.H. 52-124-12
El. Sur. 1225.51
El. B.C. 1133.51

D.D.H. 52-124-8
El. Sur. 1226.46
El. B.C. 1140.46

D.D.H. 52-124-3
El. Sur. 1217.92
El. B.C. 1149.92

D.D.H. 52-124-7
El. Sur. 1212.81
El. B.H. 1180.81

D.D.H. 52-124-4
El. Sur. 1207.24
El. B.C. 1136.24

D.D.H. 52-124-6
El. Sur. 1201.61
El. B.C. 1141.61

D.D.H. 52-124-5
El. Sur. 1195.32
El. B.C. 1130.49

OLD IRON POST
STONES
W/IT. CORNER

ABRAM LAWSHE

N 66° 52' E 4530.0'

THOMAS GALVERT

D.D.H. 52-124-14
El. Sur. 1214.21
El. B.C. 1167.21


D.D.H. 52-124-15
El. Sur. 1215.11
El. B.C. 1162.28

D.D.H. 52-124-16
El. Sur. 1214.26
El. B.C. 1153.93

D.D.H. 52-124-11
El. Sur. 1205.29
El. B.C. 1138.29

OLD STONES
CORNER

OLD STONES
CORNER

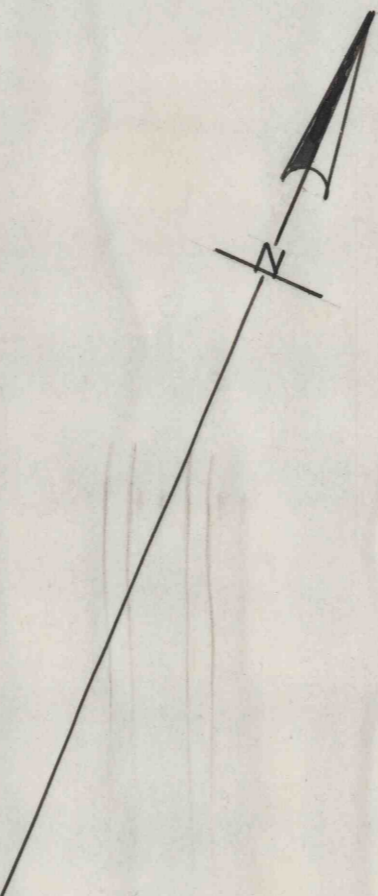

NOTE

FOR PREVIOUS DRILLING SEE MAP No. 20-3-152

NORTH AMERICAN REFRACTORIES COMPANY

CLEVELAND 14, OHIO

MAP SHOWING

1952 DRILL HOLE LOCATIONS

ON ROCK CABIN LANDS

LOCATED IN BALD EAGLE TOWNSHIP CLINTON COUNTY

SCALE 1" = 400'

DRAWN 2-16-62 J.C.M.

APPROVED

INDEX No. 20-3-218

6500
BEM 00519