


9/21  
1681

H.A. MOORE

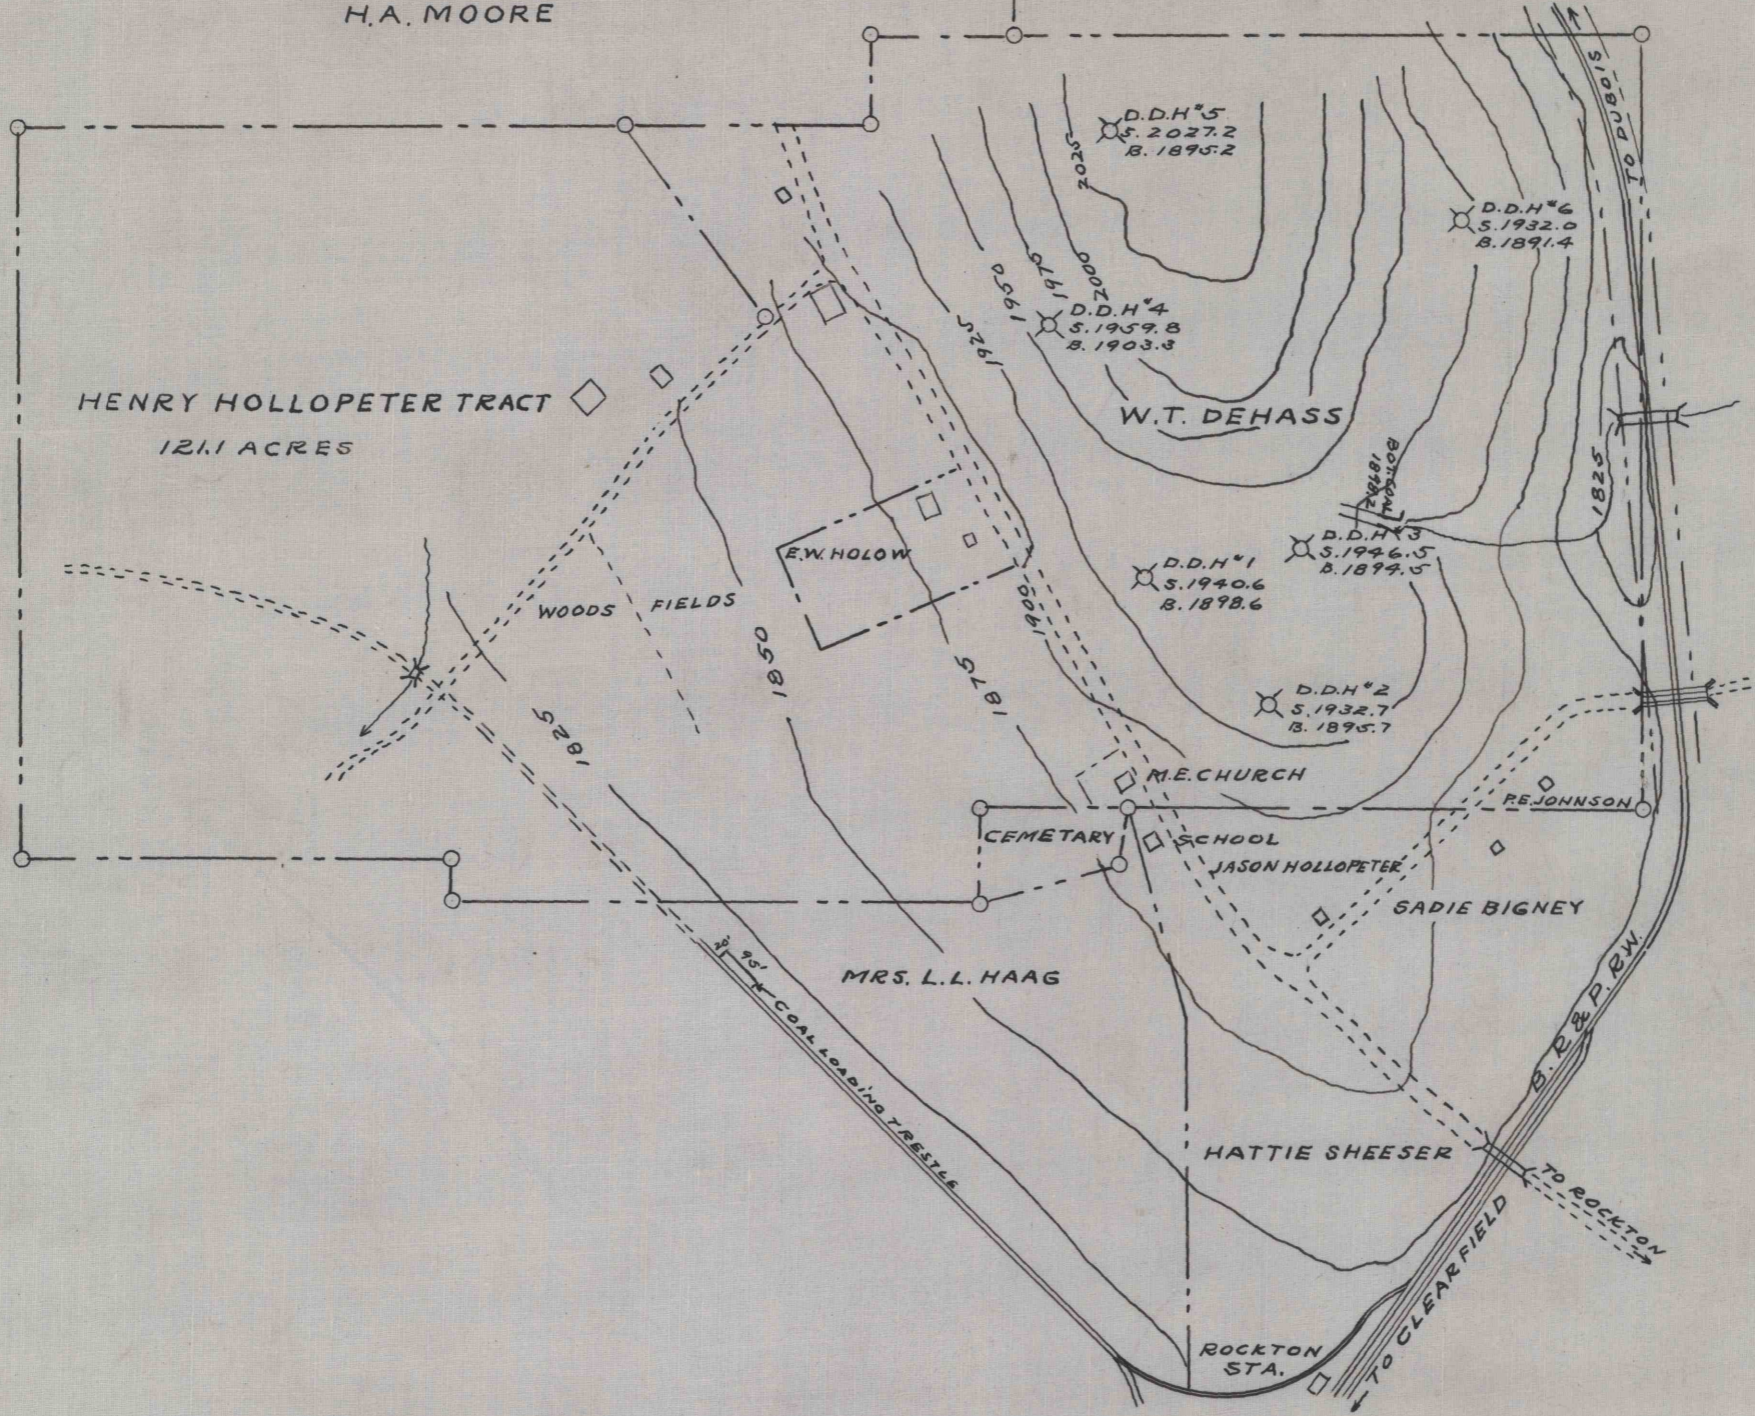

2921  
5  
0131  
2  
7681

1" = 400'