


Scale - 1" = 400ft.

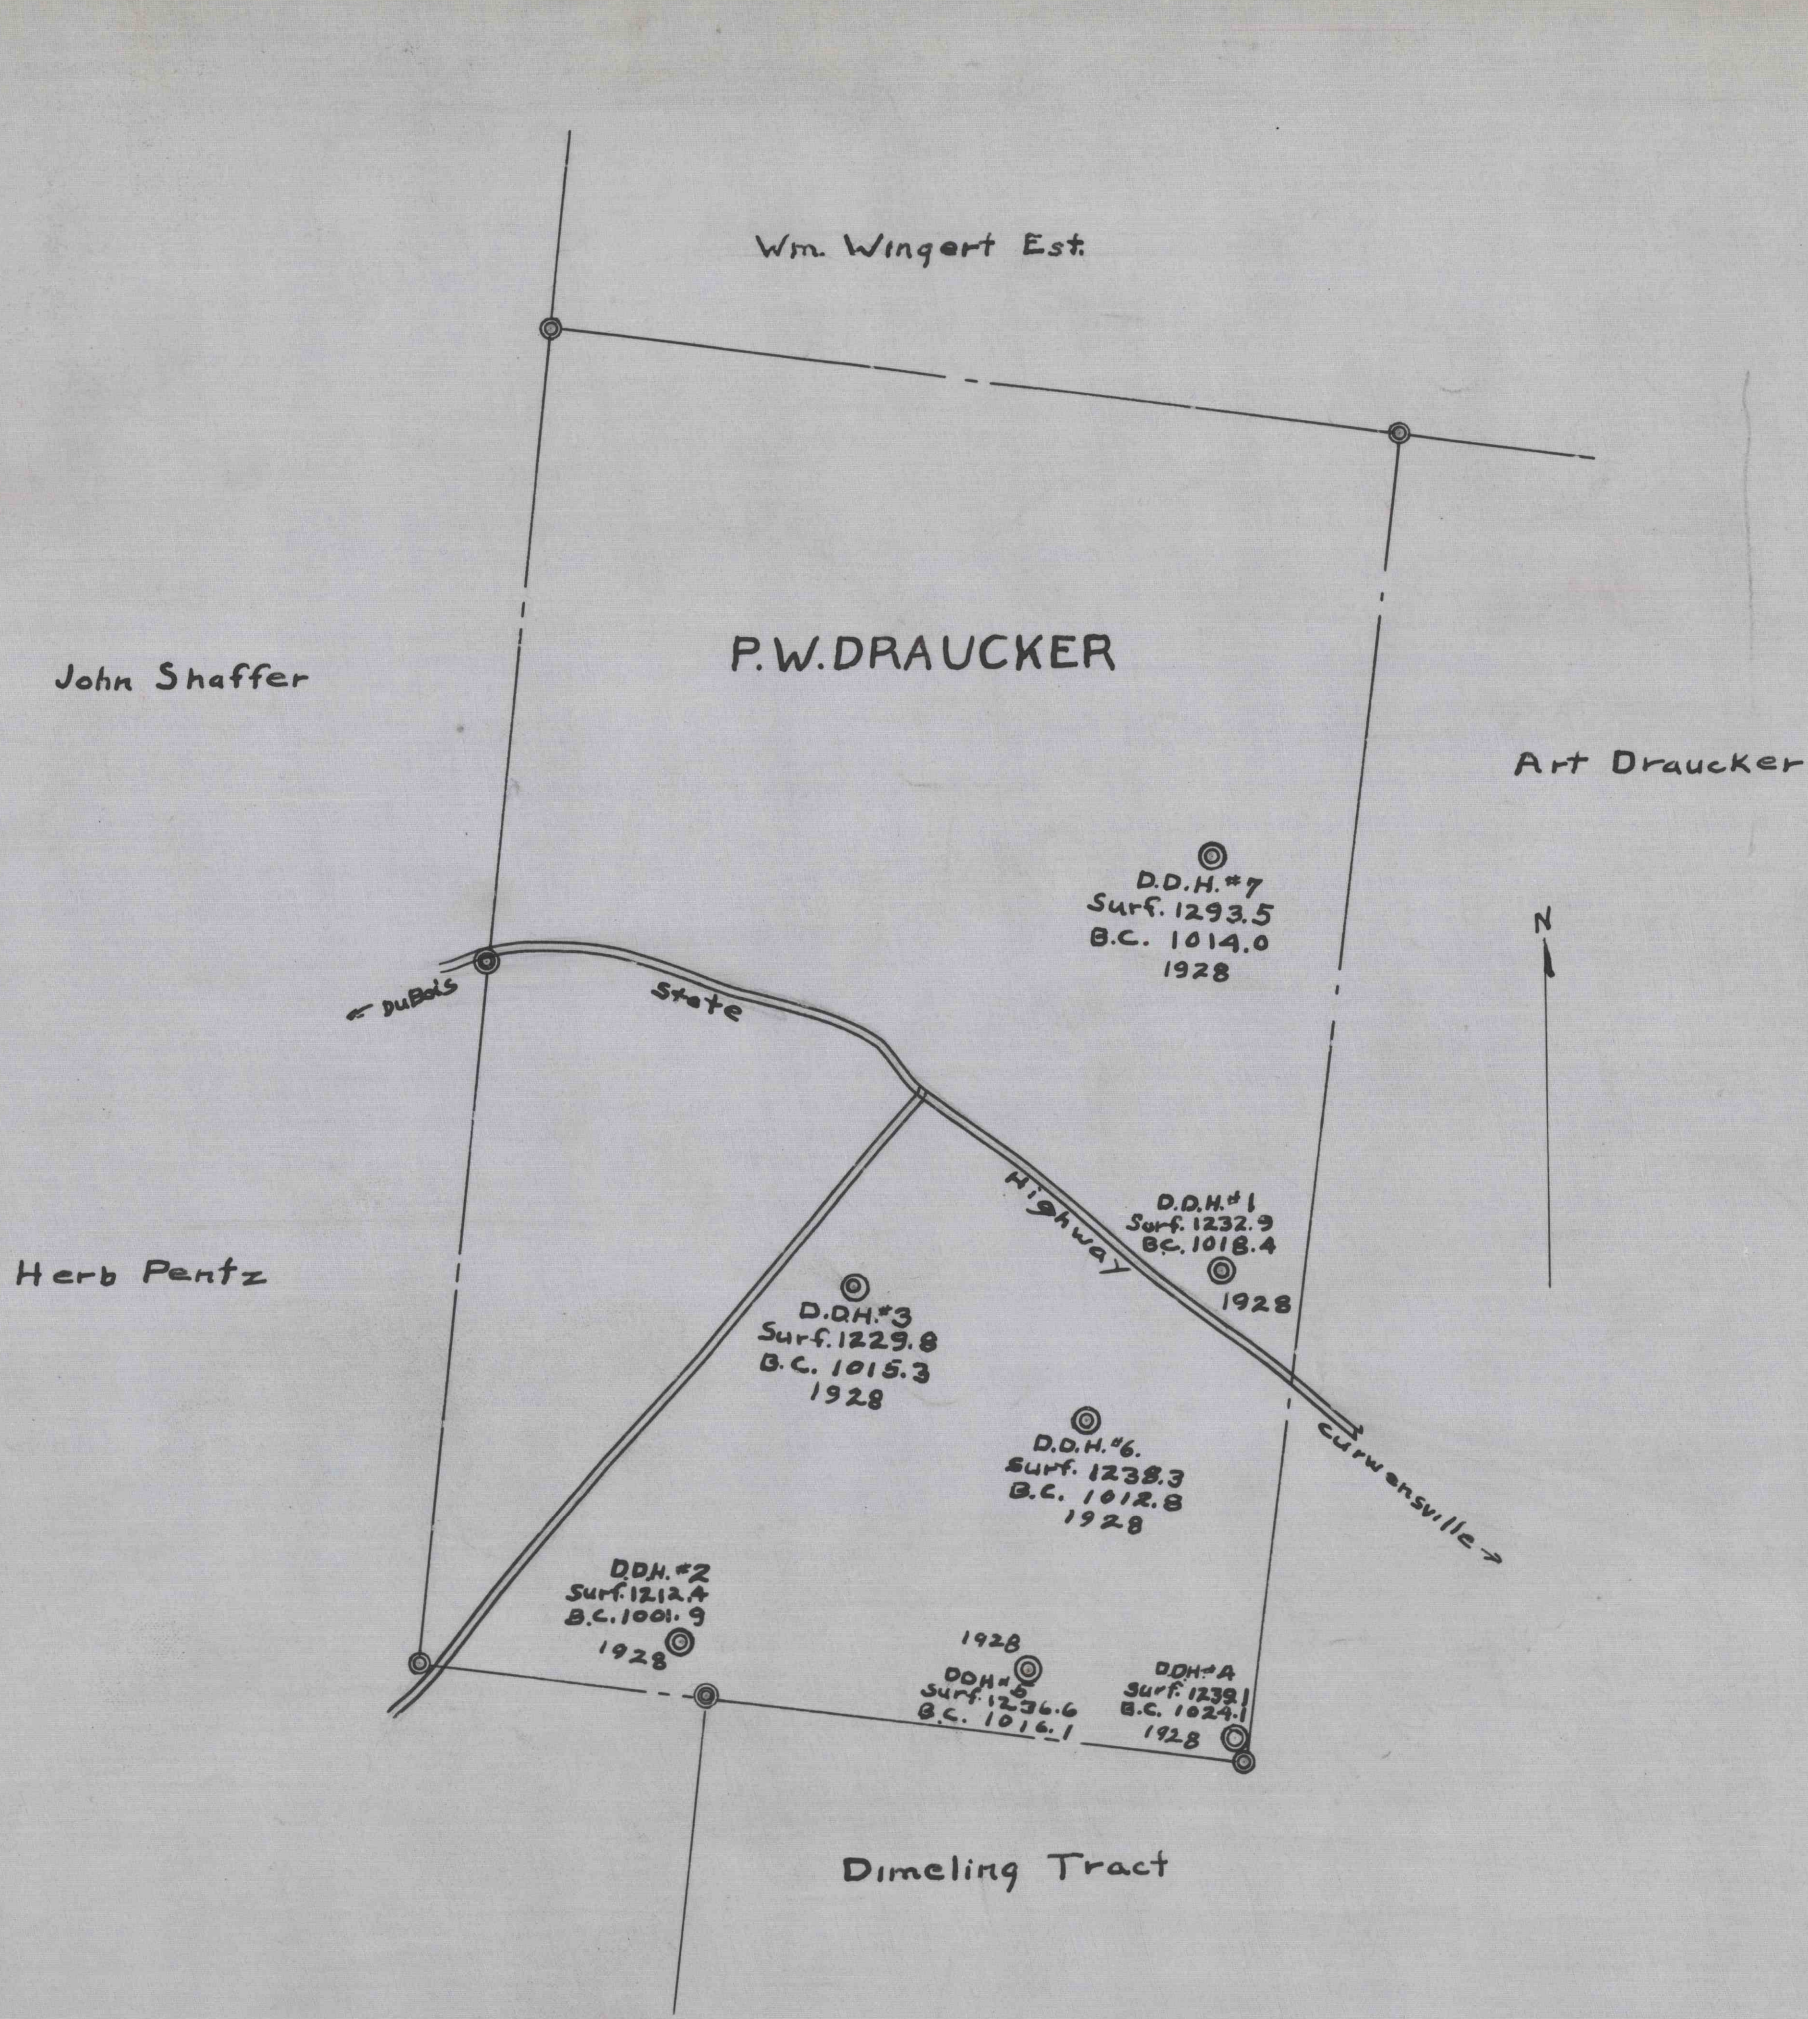

50-3-744

50-3-744