


scale 1 inch = 400 Ft.

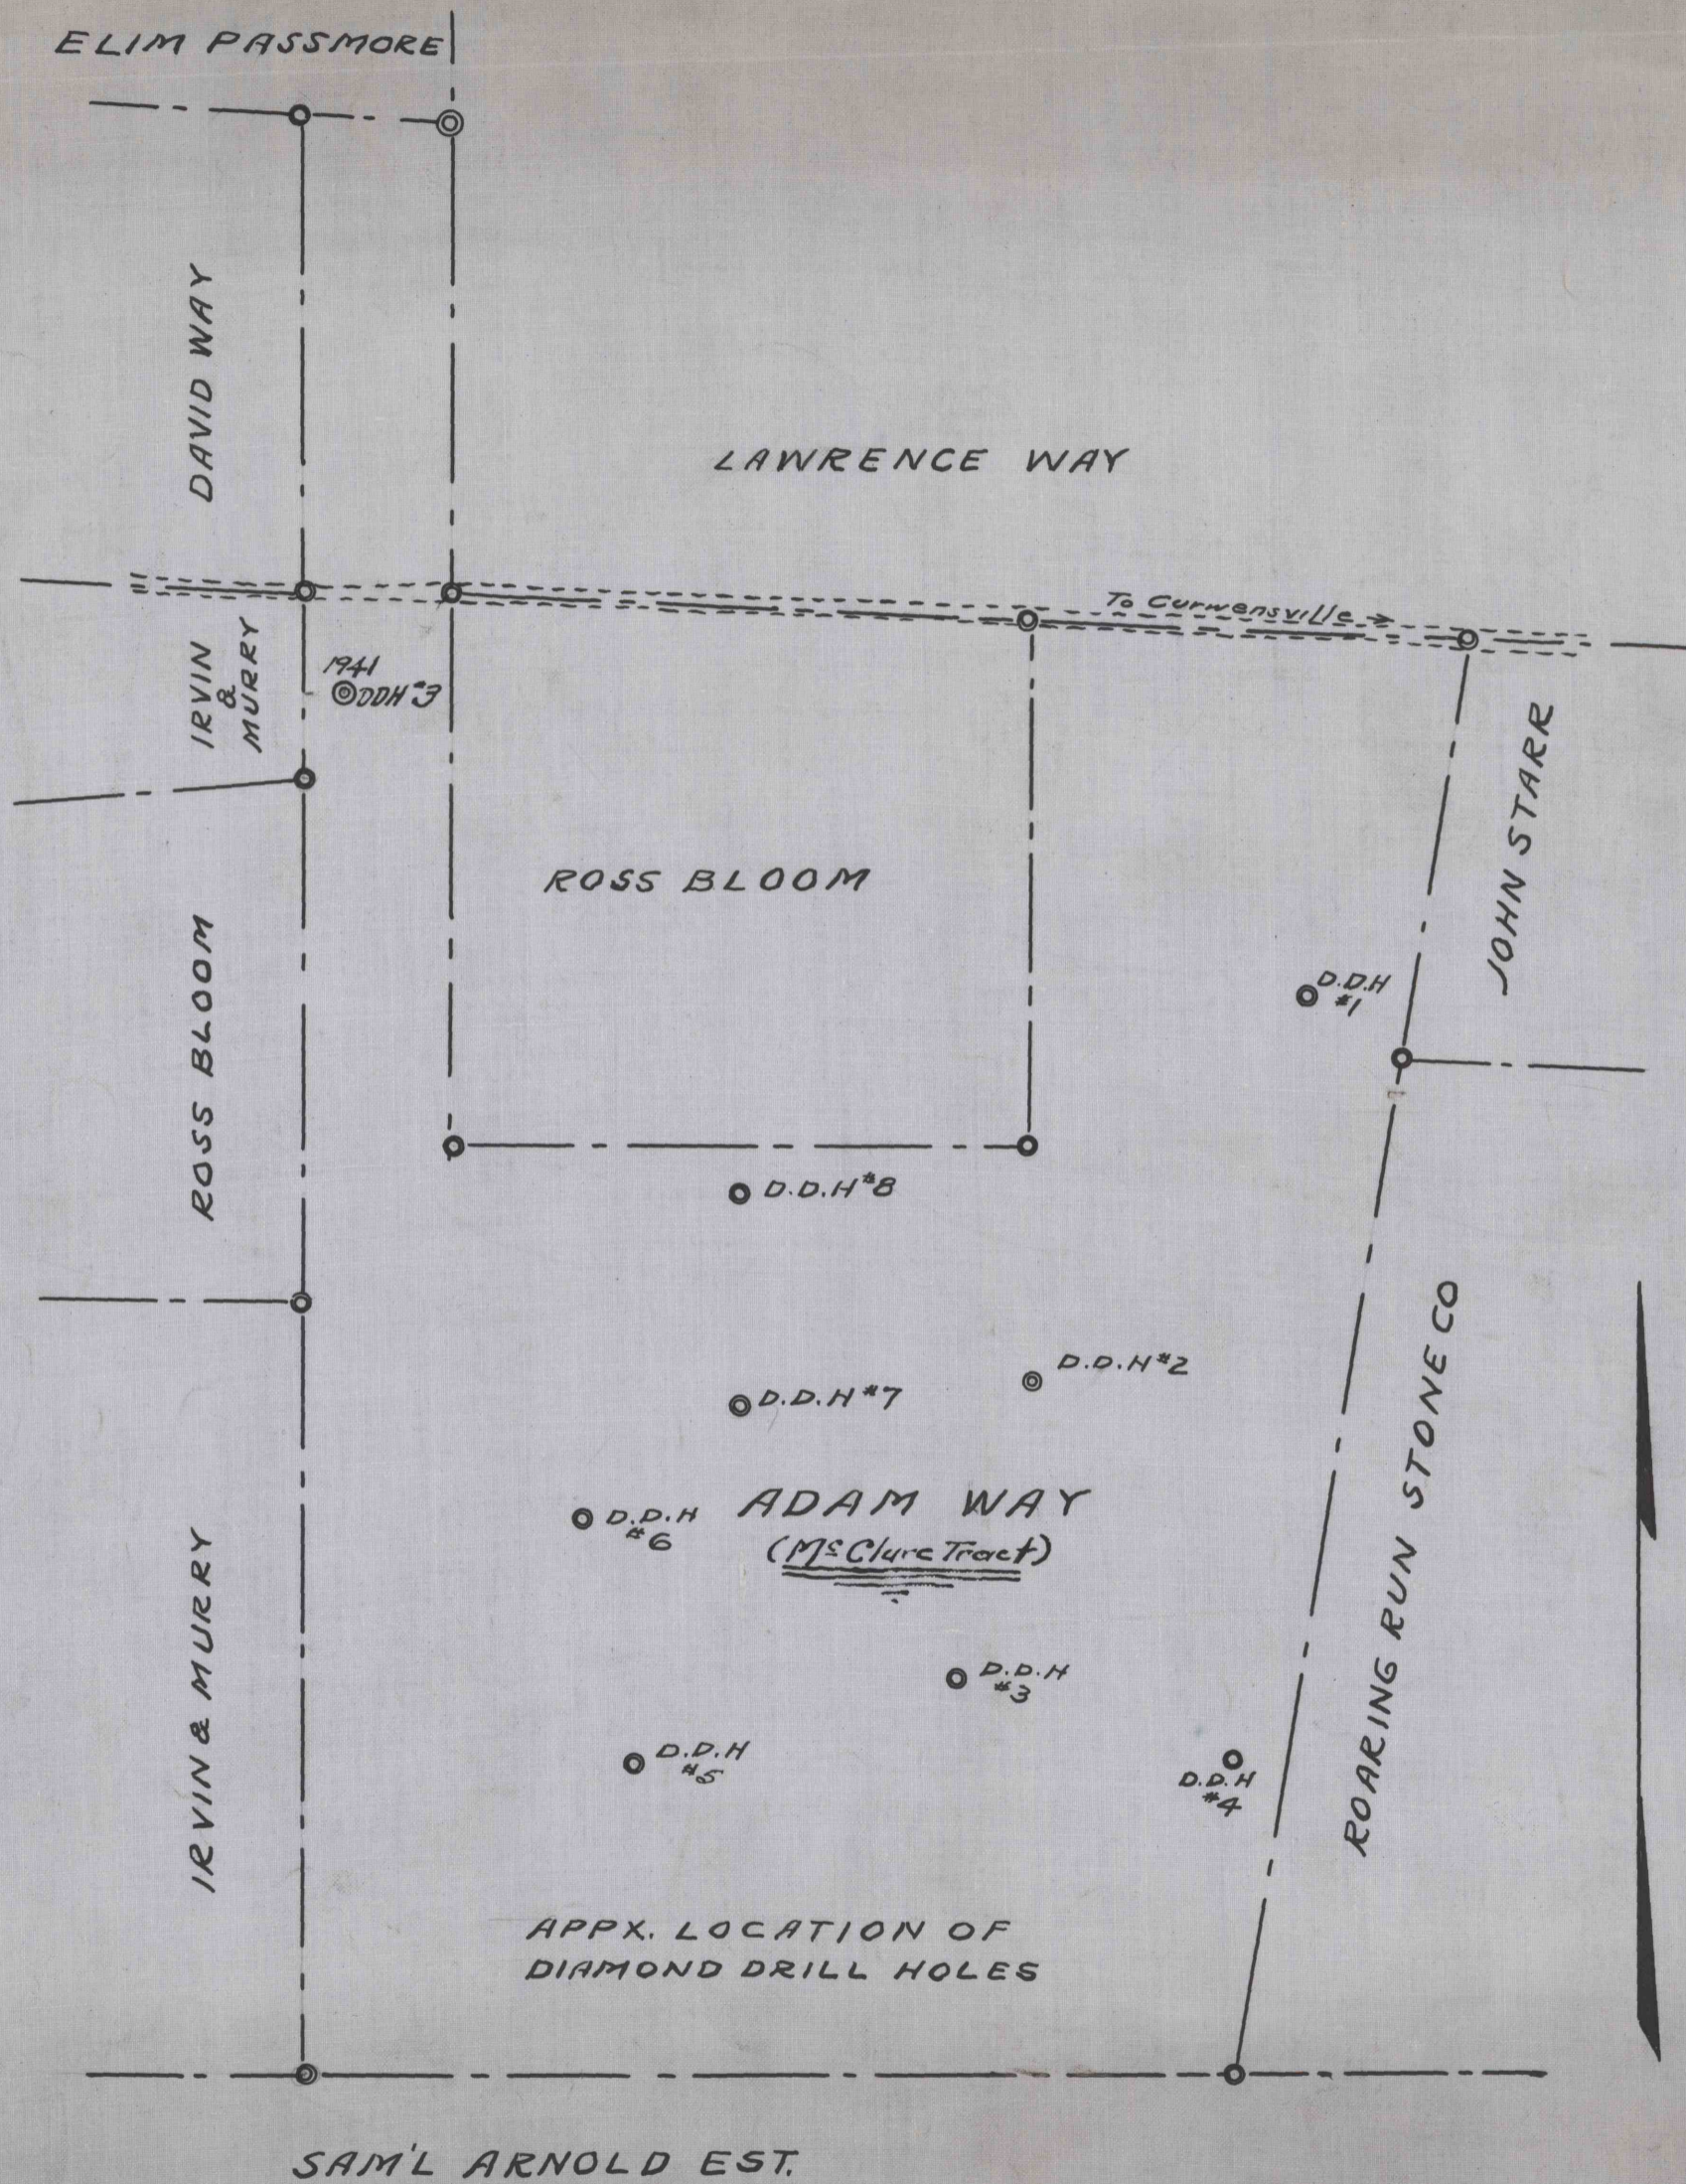

50-3-754

50-3-754