Scale 1 in. = 400 ft.

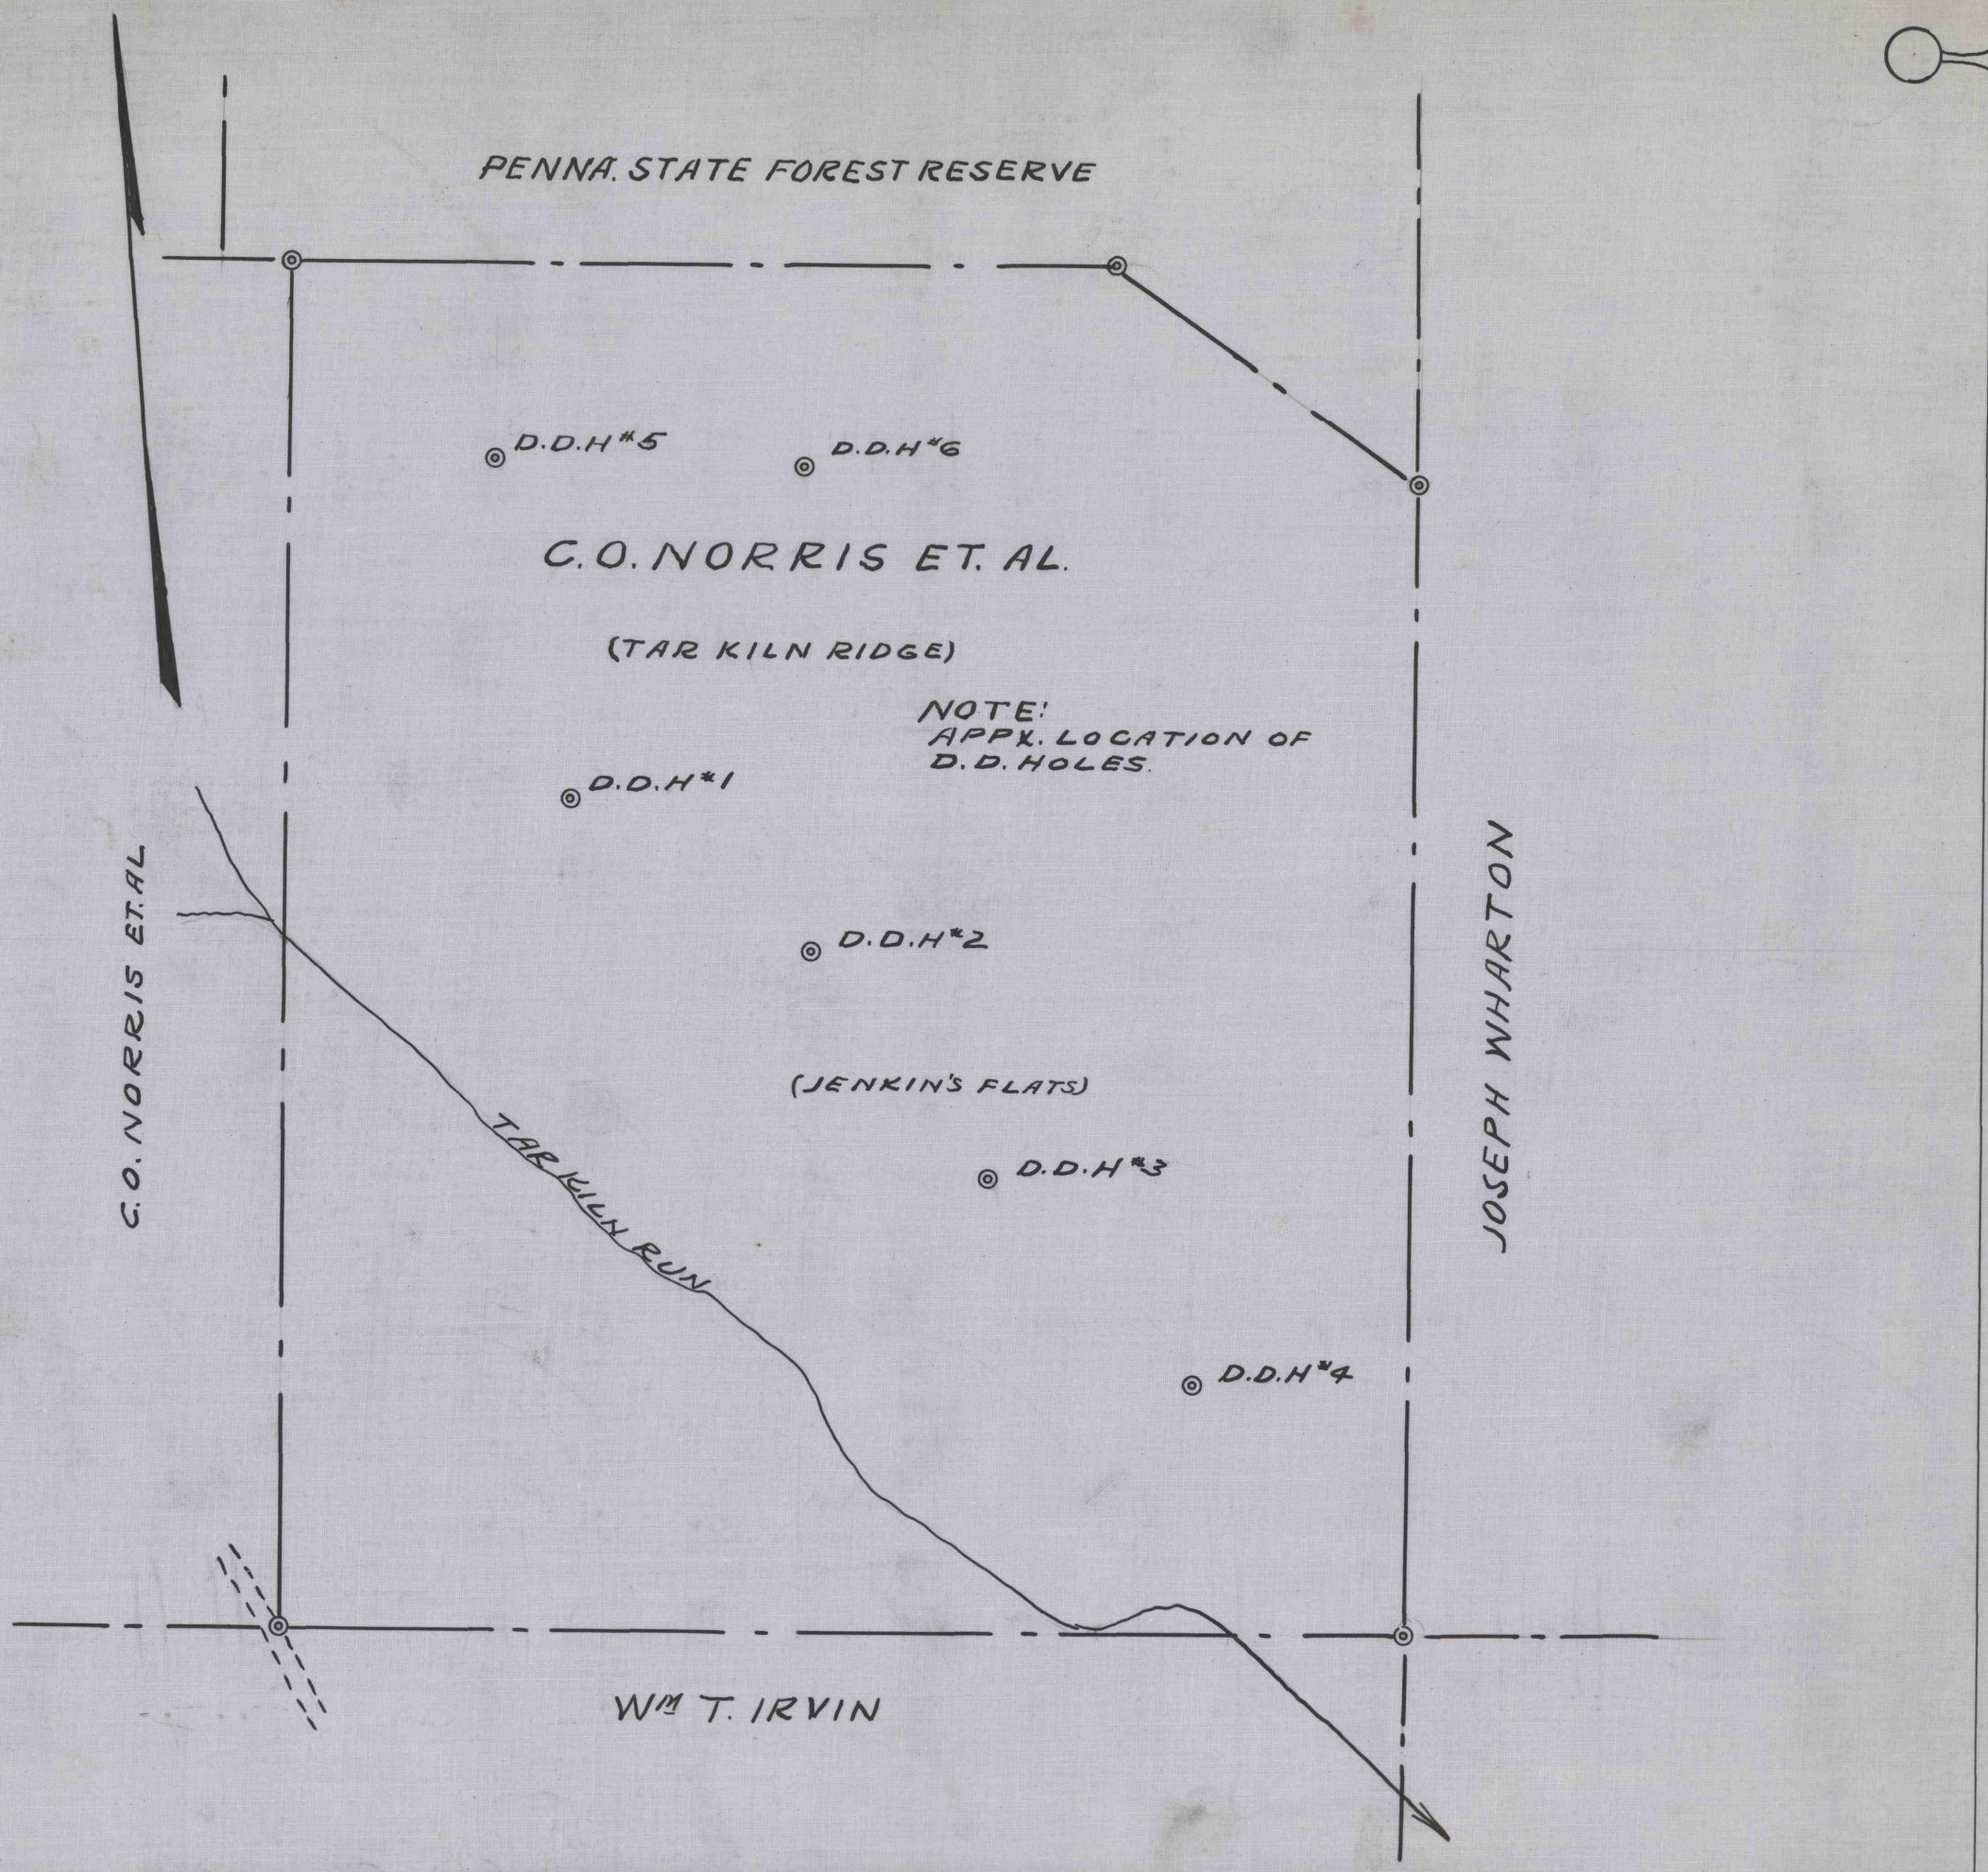

50-3-756

Received 50-3-756