


NOETH

Ralston-
Butler
&
Heart
Association

161 1/2 Acres

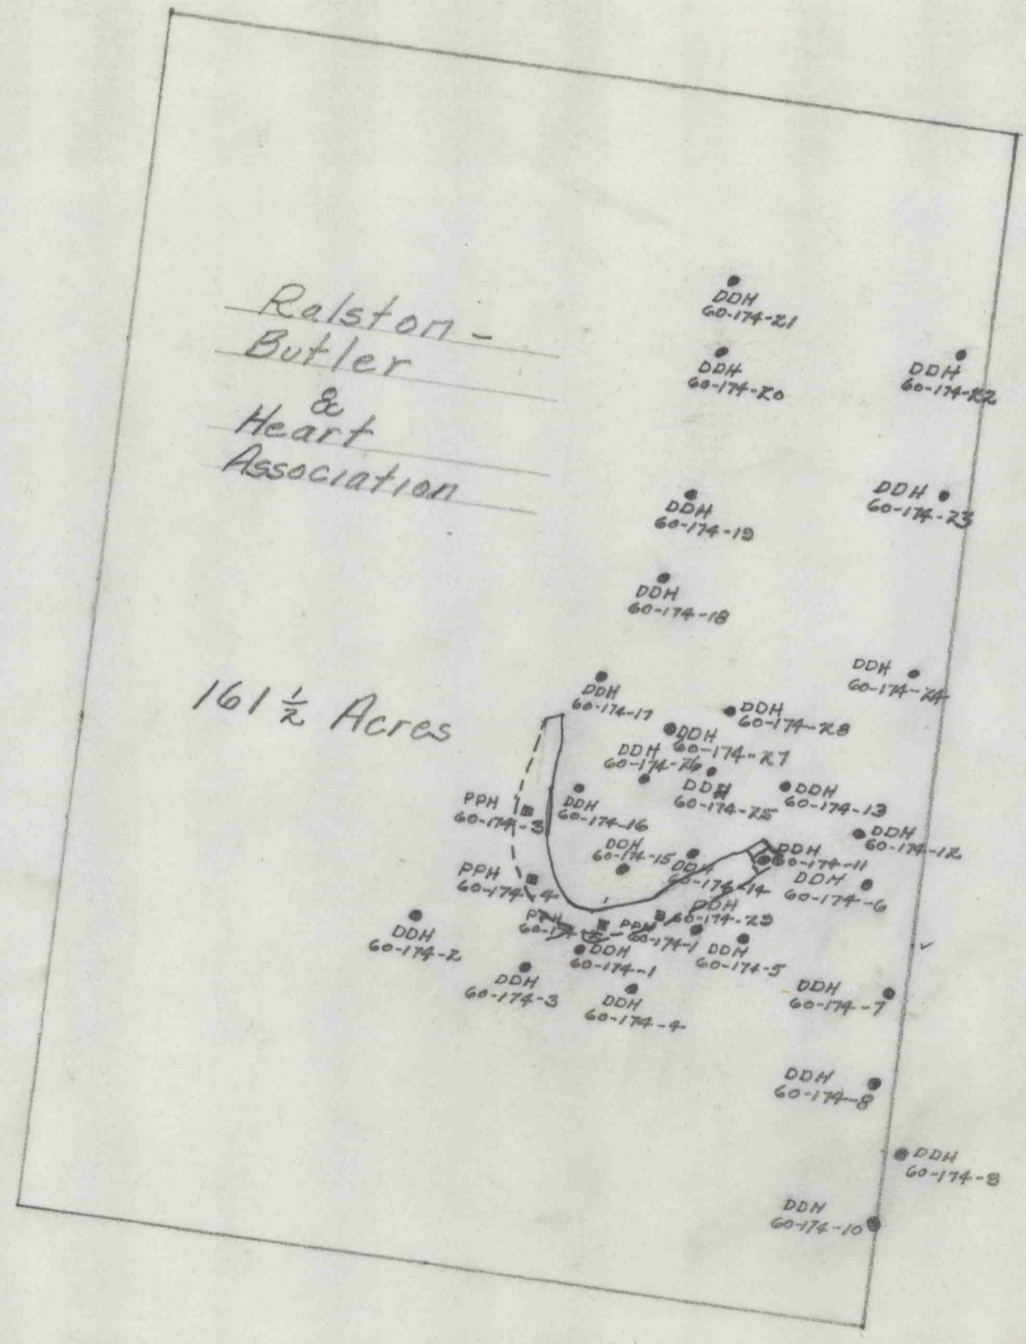

NORTH AMERICAN REFRACTORIES Co.
CLEVELAND, OHIO

MAP OF RALSTON-BUTLER-HEART
ASSOCIATION TRACT-SHOWING 1960 DRILLING

BOGGS TWP., CLEARFIELD CO., PENNSYLVANIA
SCALE: 1" = 500 FT. DRAWN FROM 50-3-1508 - J.R.H. Jr.
2-22-61

Index No. 50-3-1514