


SCALE - 1" = 500 FT
WORKED FROM 55-3-18

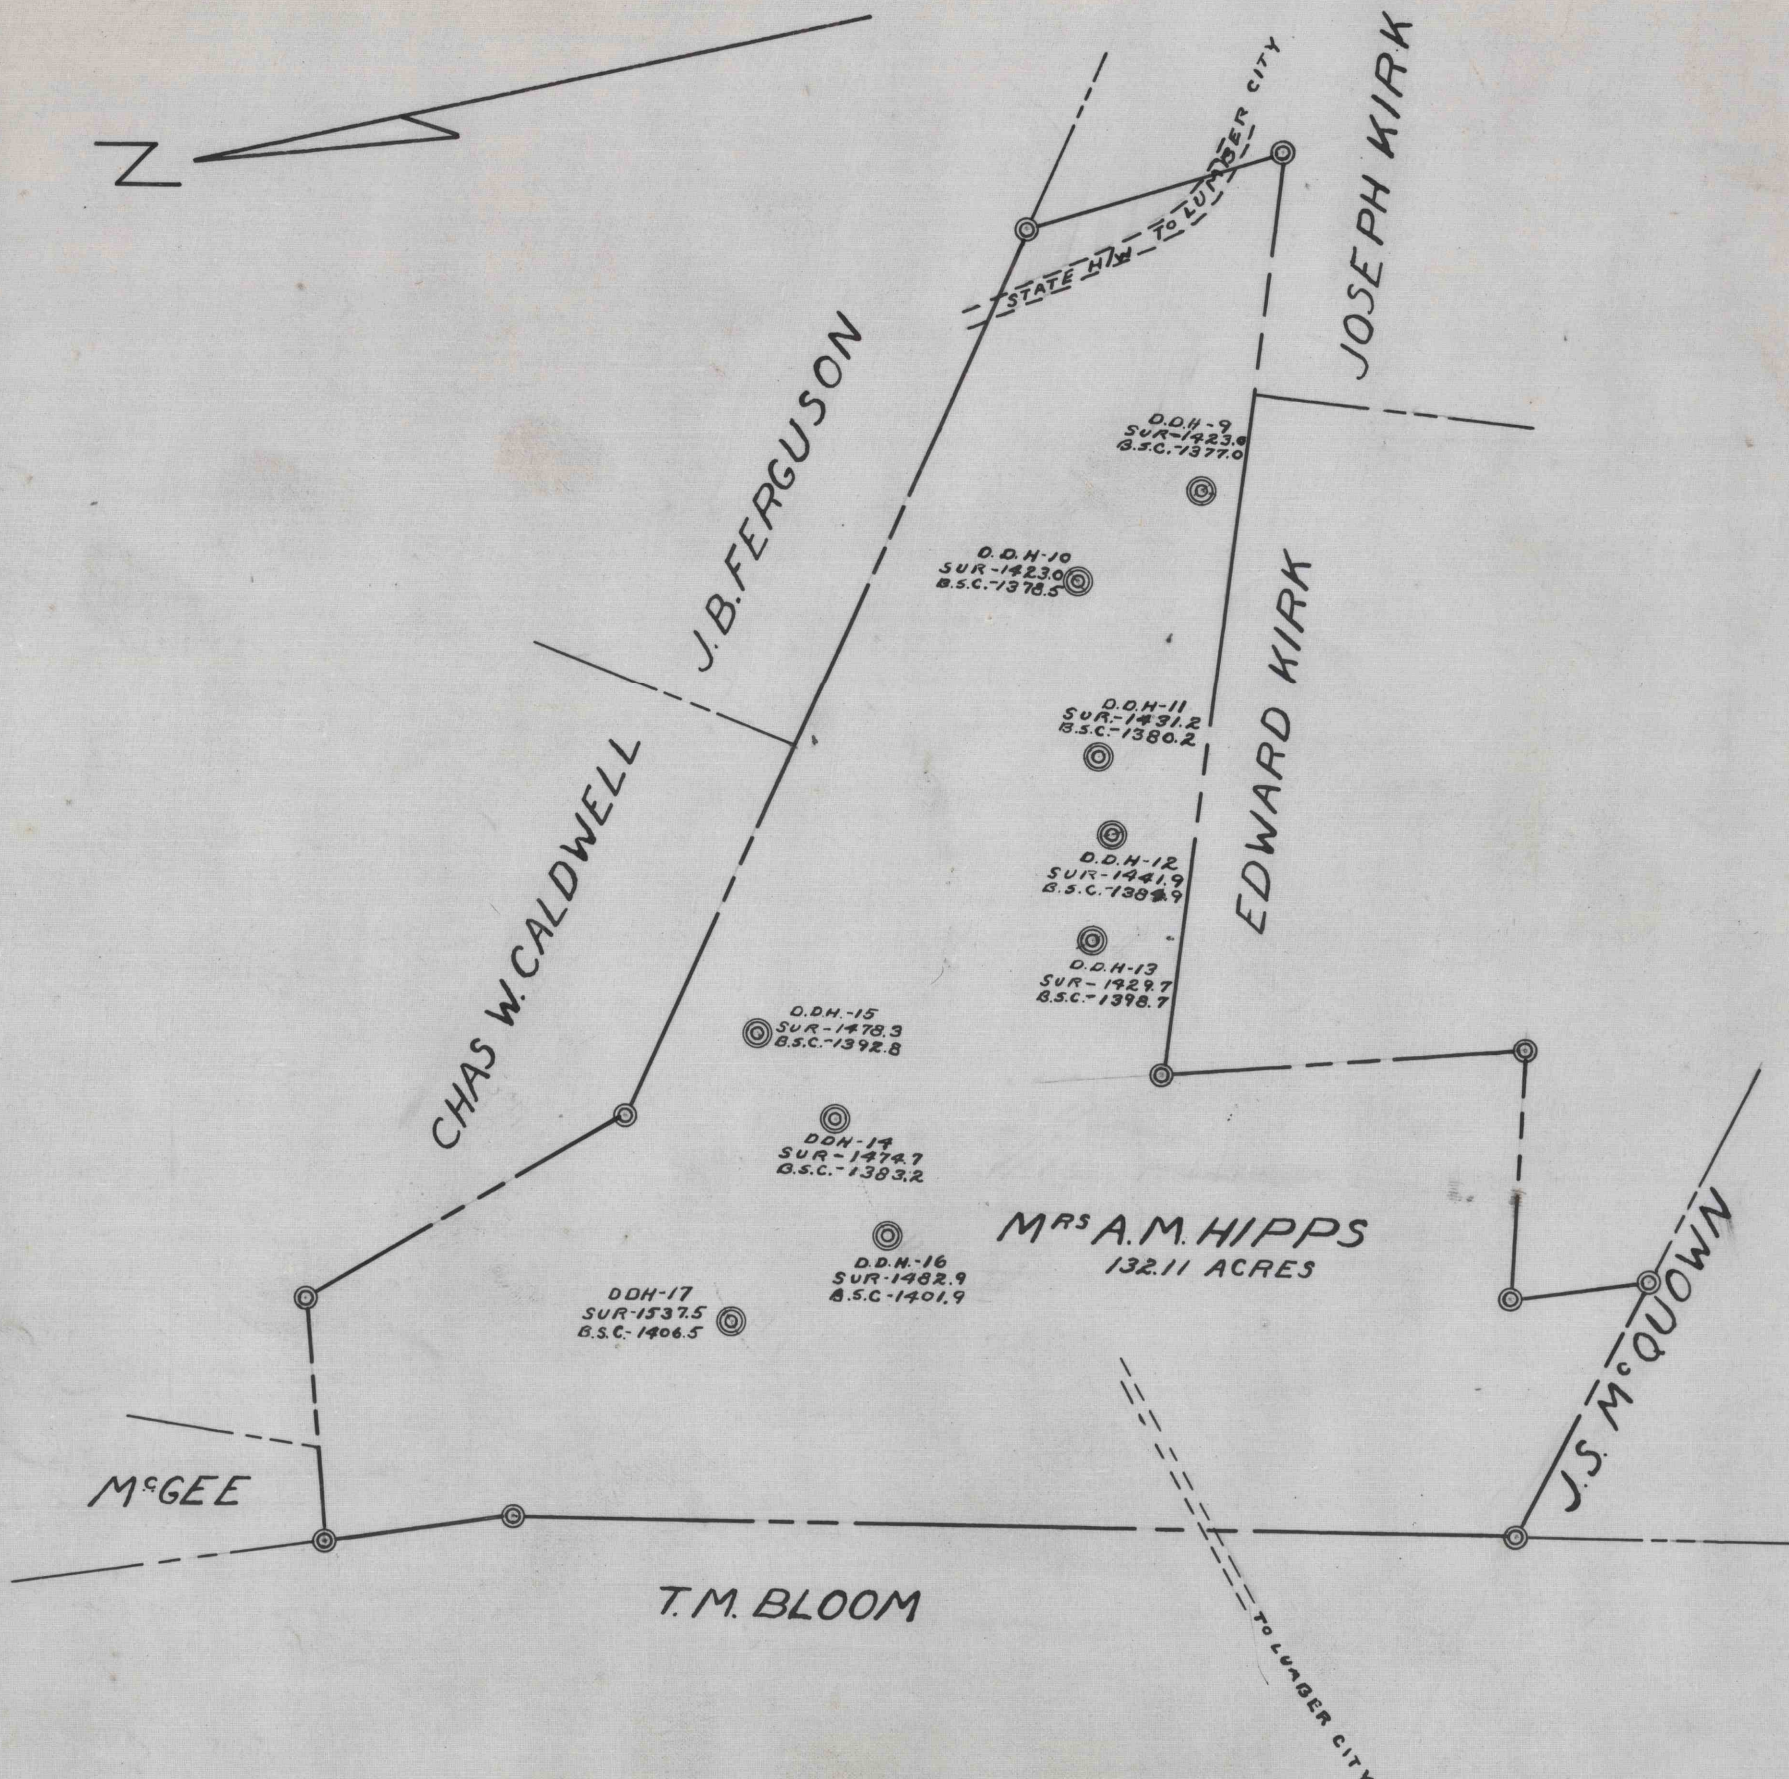

50-3-782

50-3-782

50-3-782

50-3-782