

8-E-07

8-E-07

NORTH AMERICAN REFRACTORIES CO.

1012 NATIONAL CITY—EAST 6TH BUILDING
CLEVELAND 14, OHIO


ENV. No.

SHEET No. 70-3-8

MAP SHOWING 1953 DRILLING ON ALLESHOUSE, LAB AND LIESER TRACTS - STRASBURG, OHIO.

SCALE 1" = 500'

DATE 5-12-54

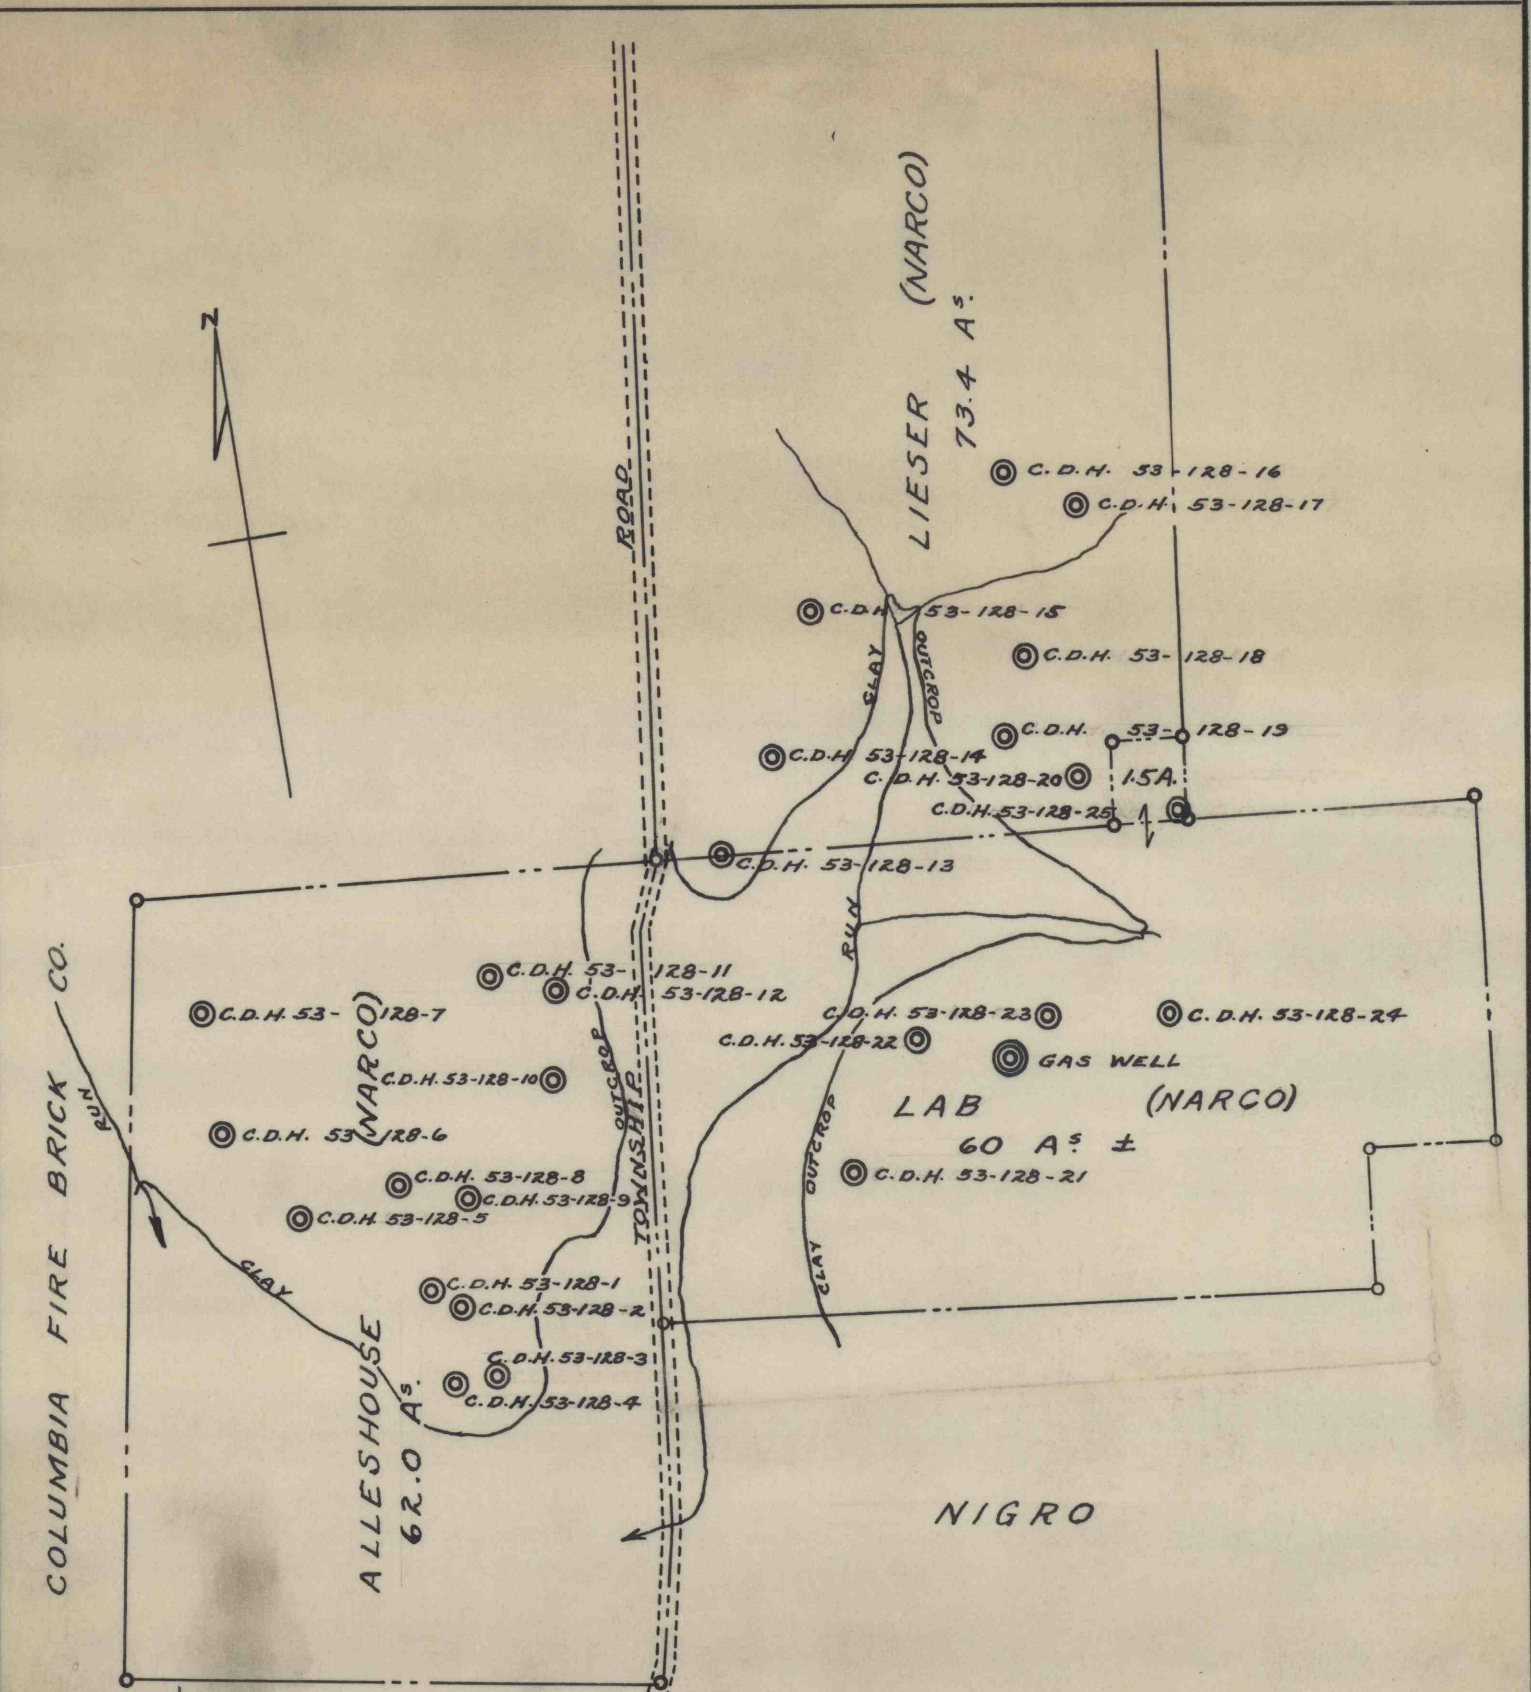

REVISION

DRAWN J.R.H., Jr.

CHECKED *[Signature]*

REFERENCE:

REVINT 00255 8-E-07