


NARCO

ABRAHAM GARBER - NARCO LEASE
86 ACRES
THOMAS L. KANE - NOW OWNS - 1946

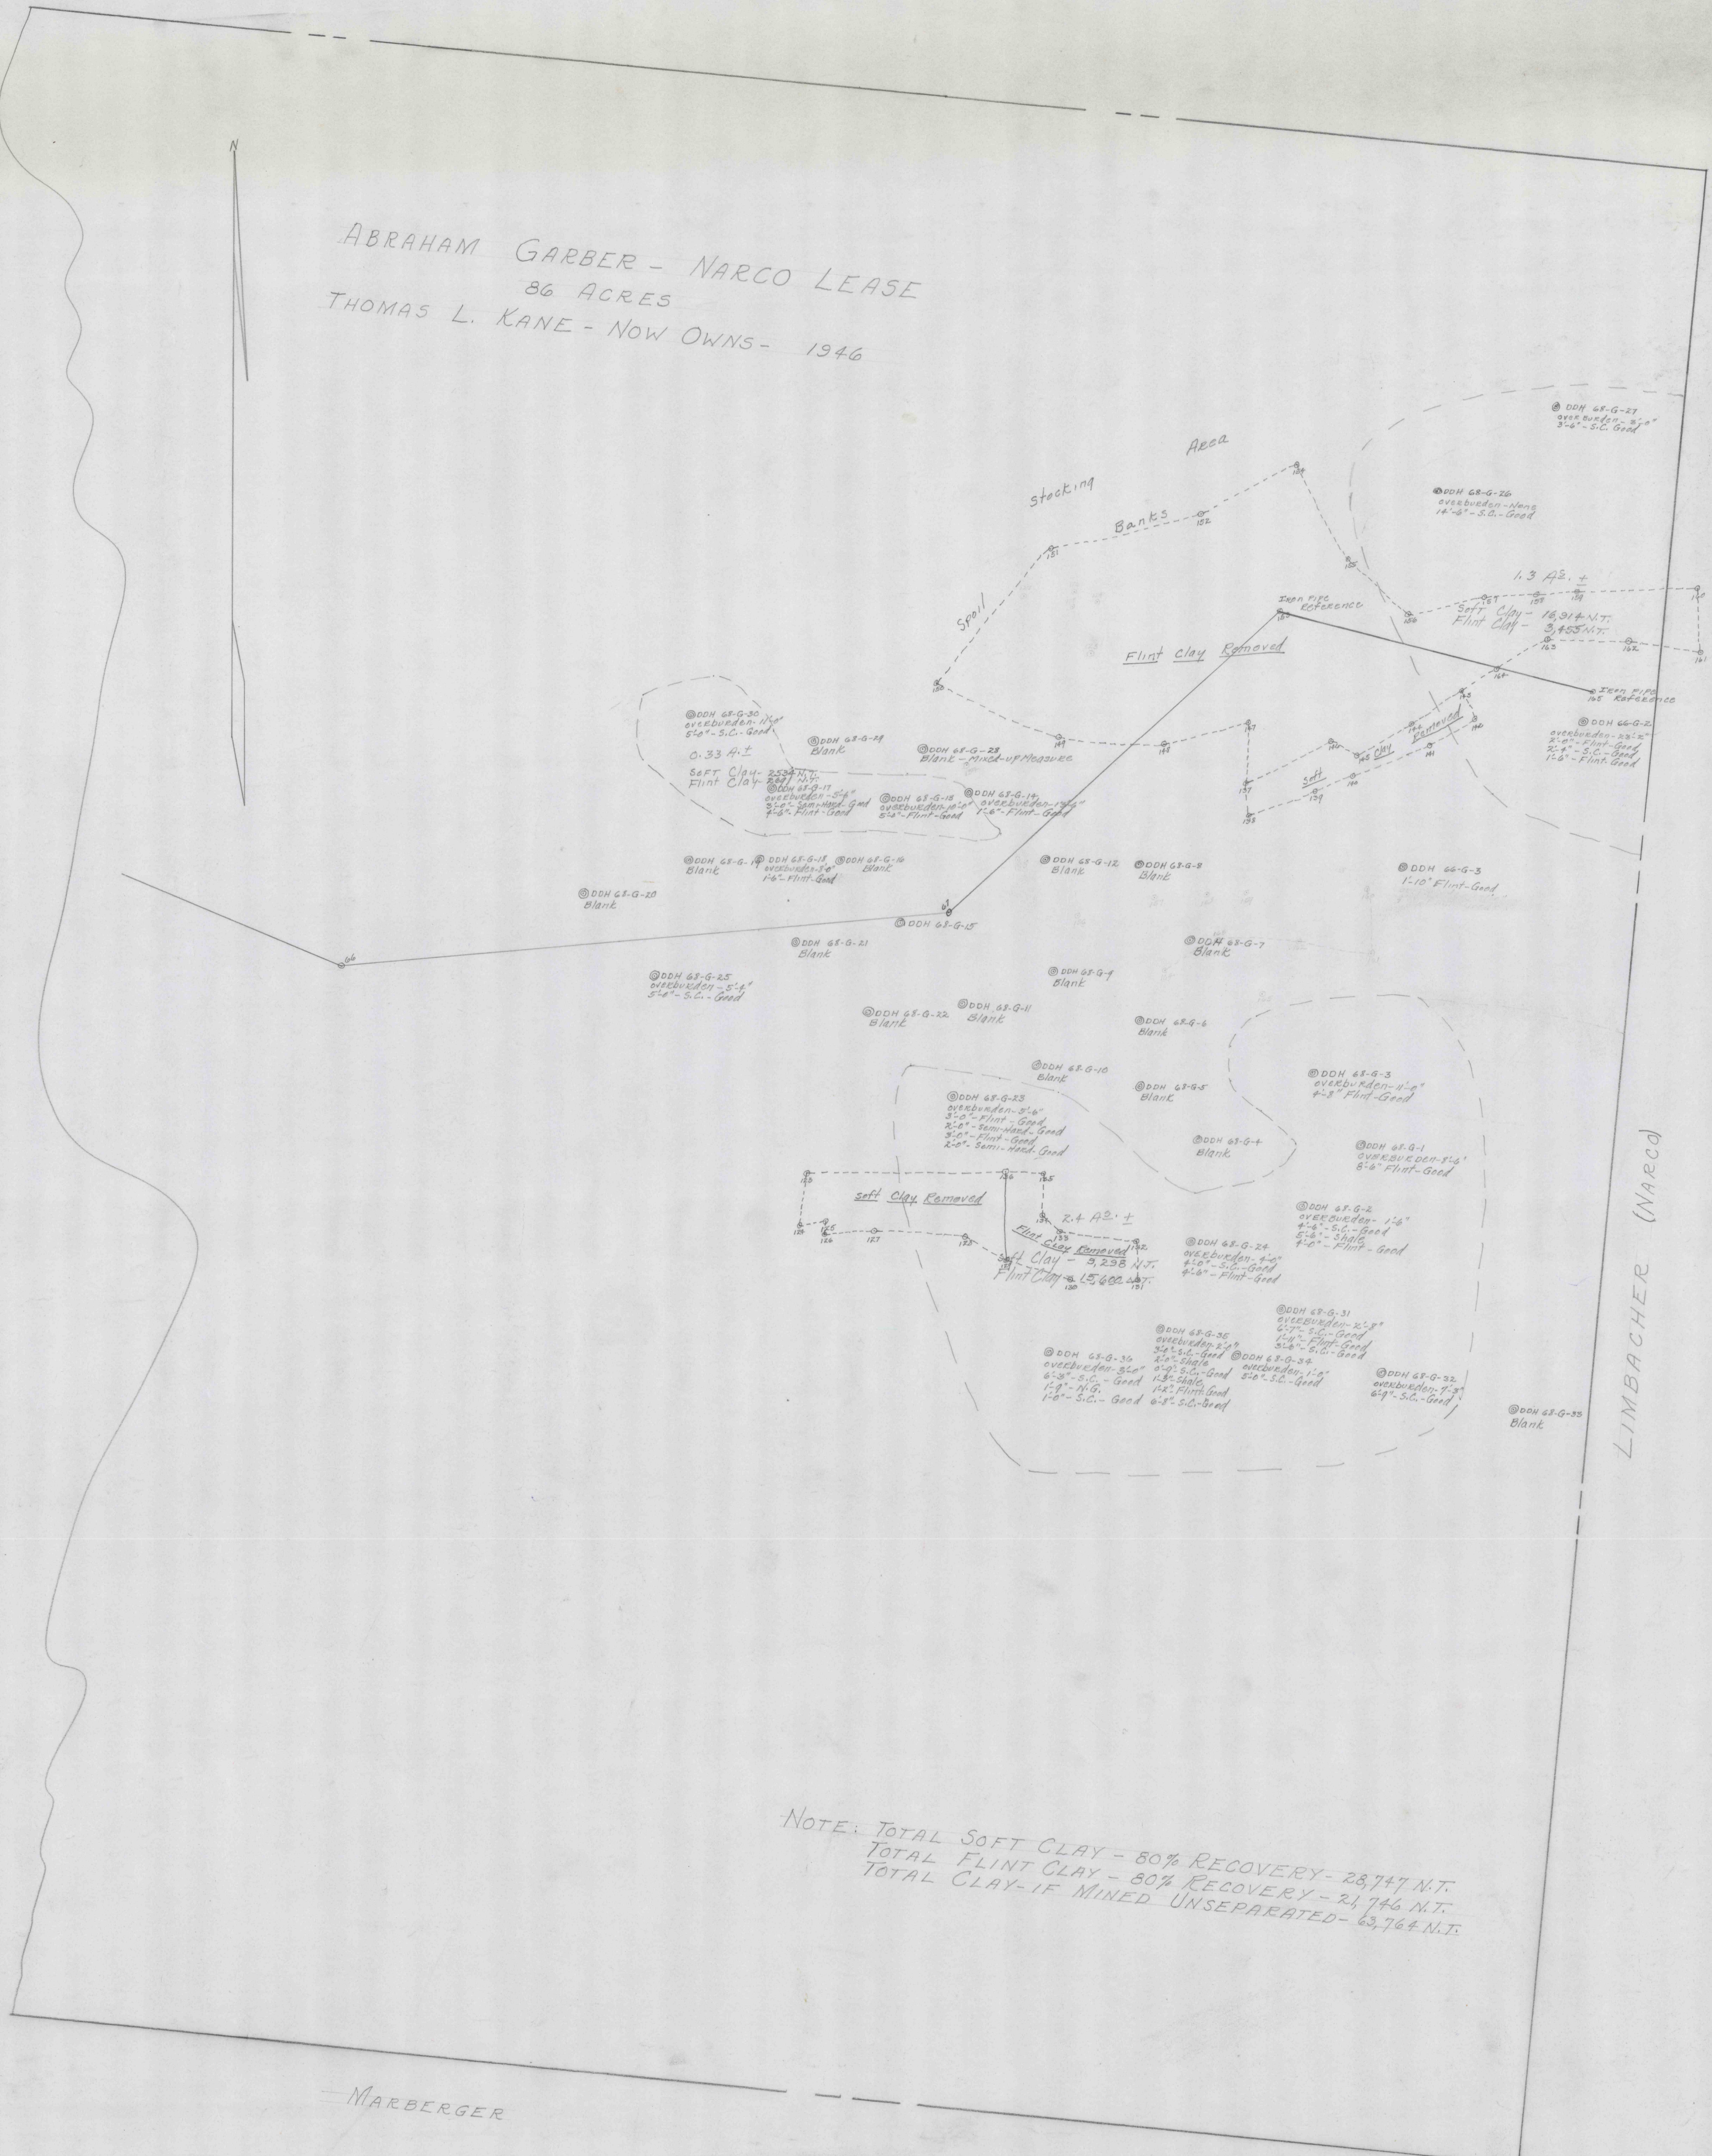

NOTE: TOTAL SOFT CLAY - 80% RECOVERY - 28,747 N.T.
 TOTAL FLINT CLAY - 80% RECOVERY - 21,746 N.T.
 TOTAL CLAY - IF MINED UNSEPARATED - 63,764 N.T.

MARBERGER

