


Mk B/p 1" writer

CHAS. E. PATTON

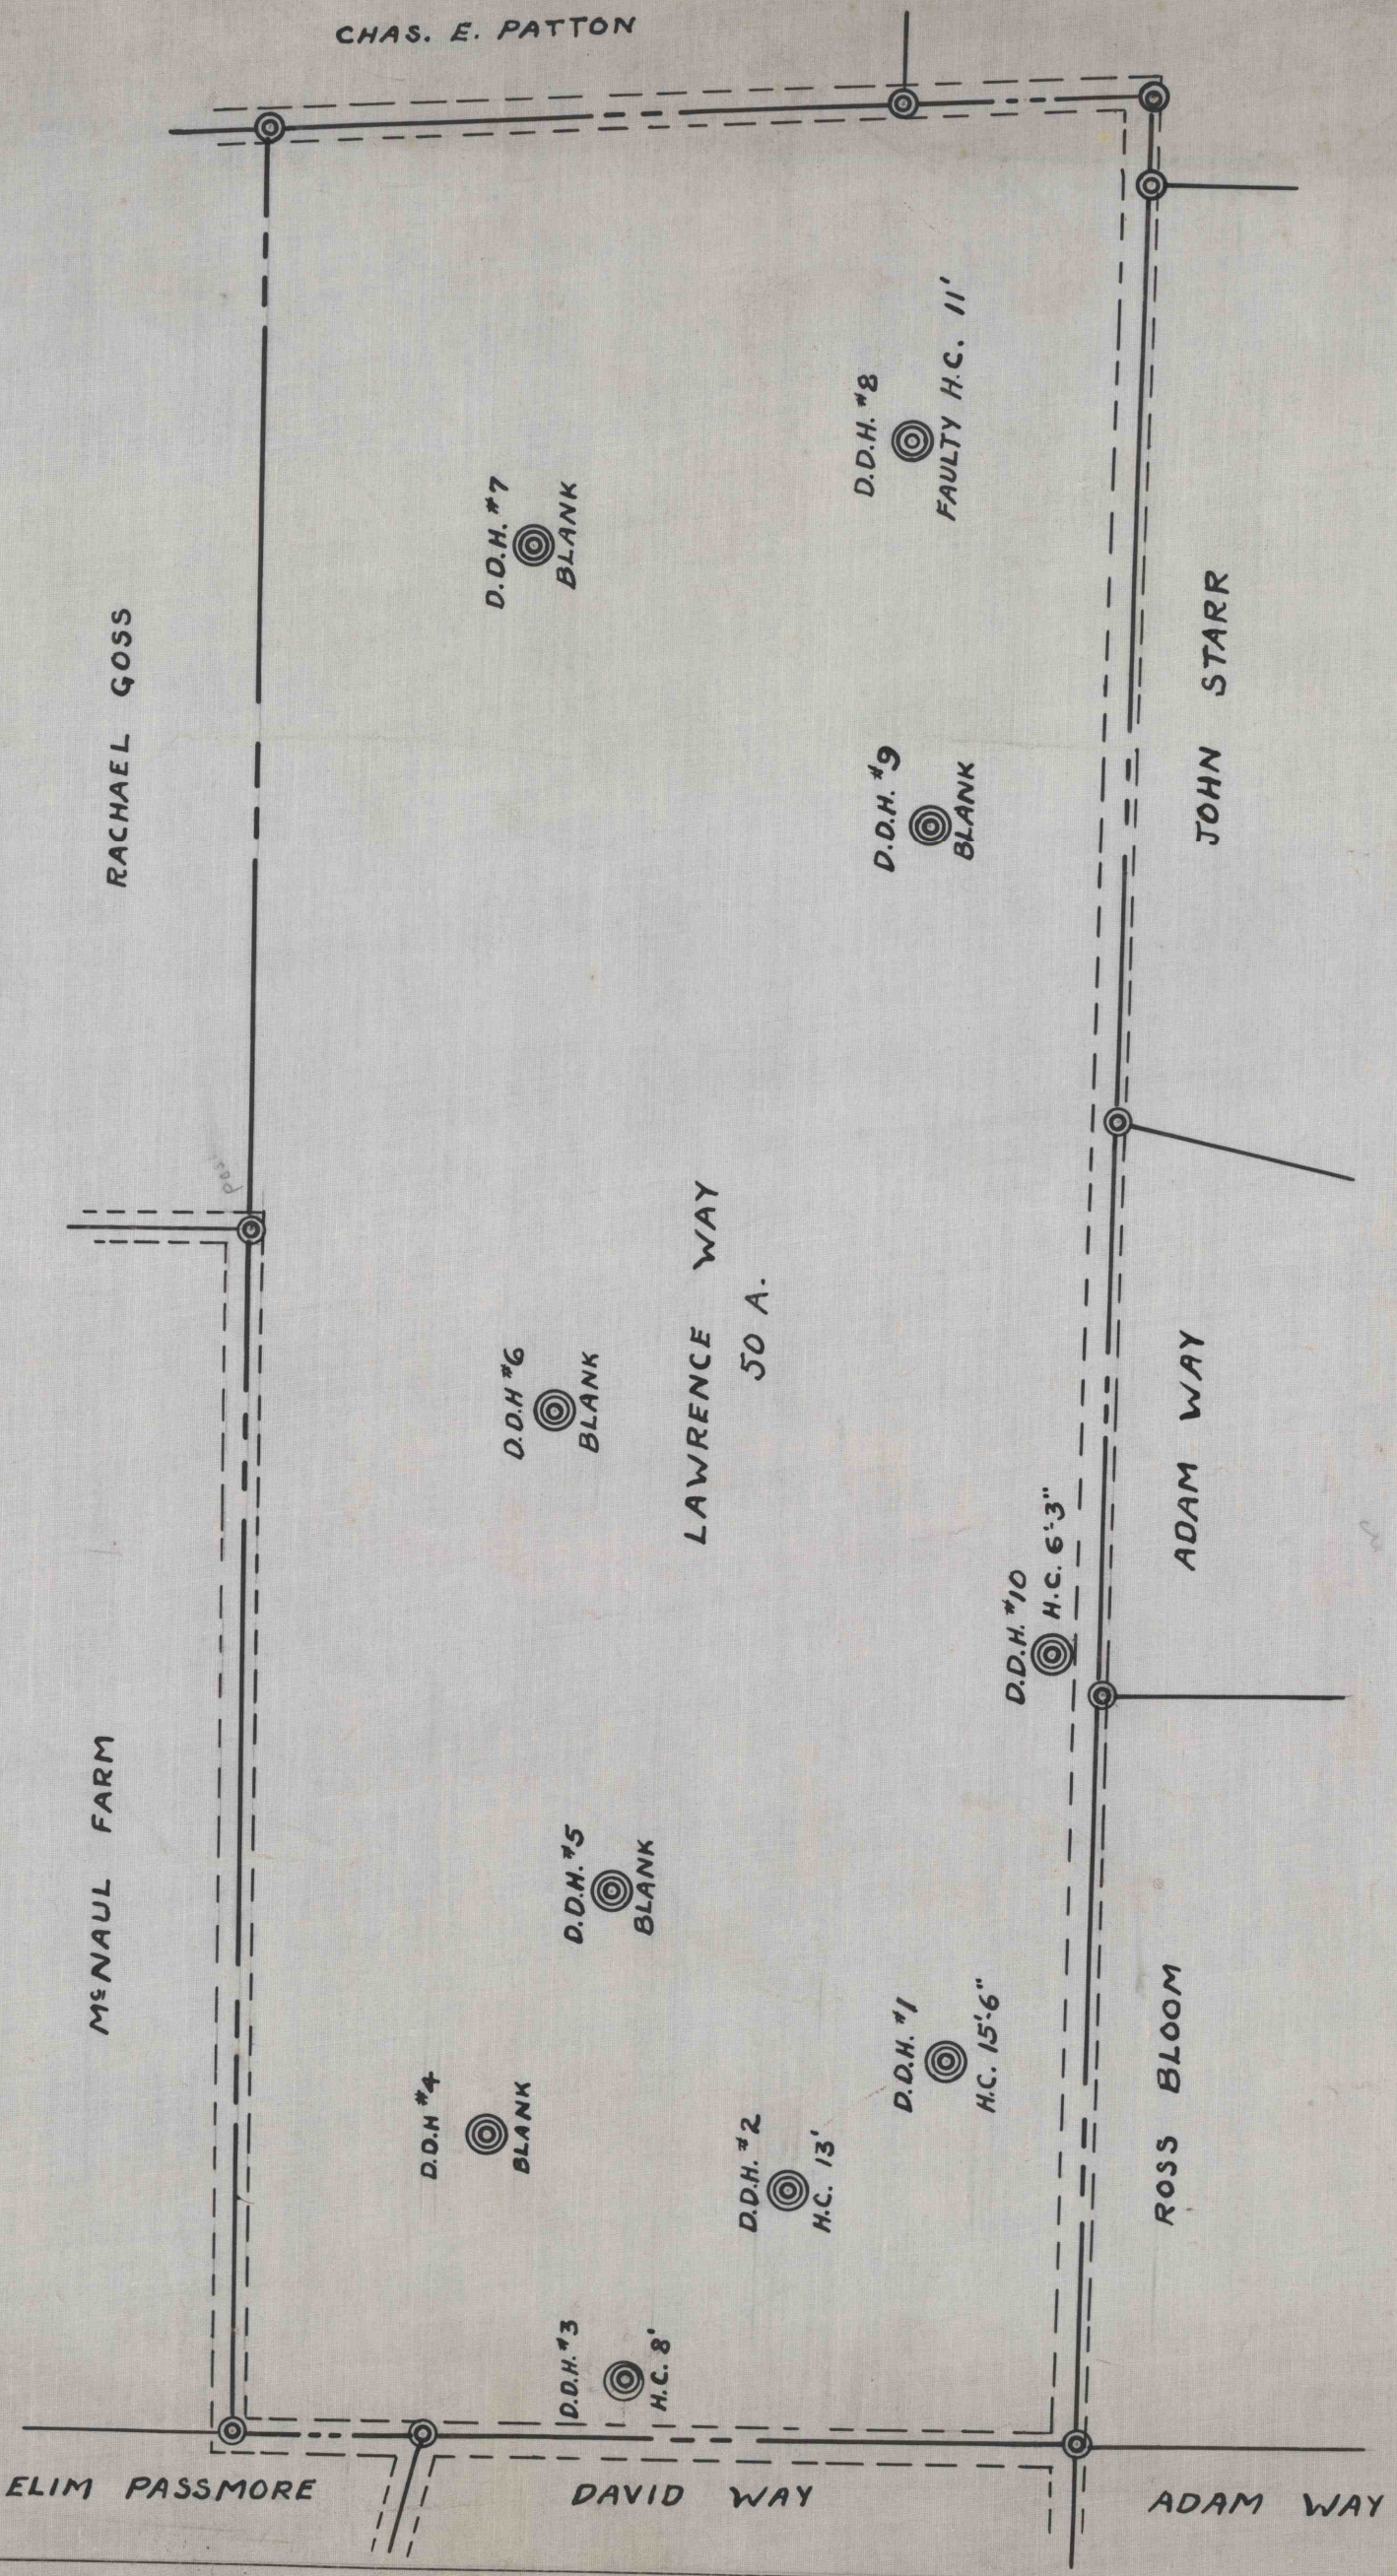

RACHAEL GOSS

MENAUL FARM

LAWRENCE WAY  
50 A.

JOHN STARR

ADAM WAY

ROSS BLOOM

ELIM PASSMORE

DAVID WAY

ADAM WAY