
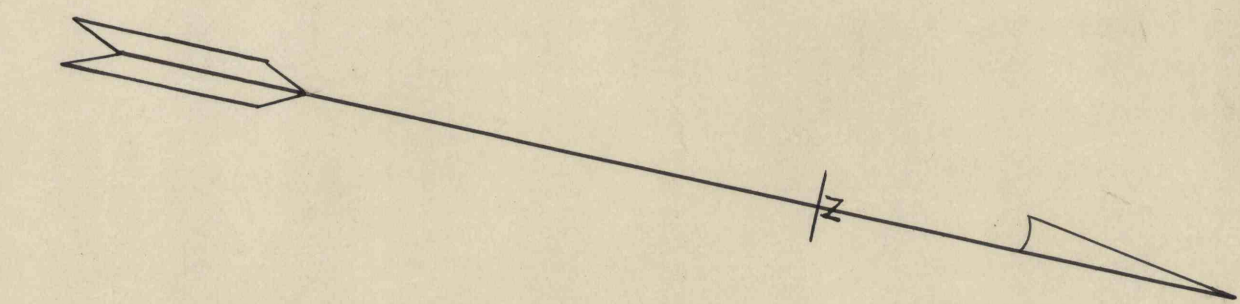


PLAN

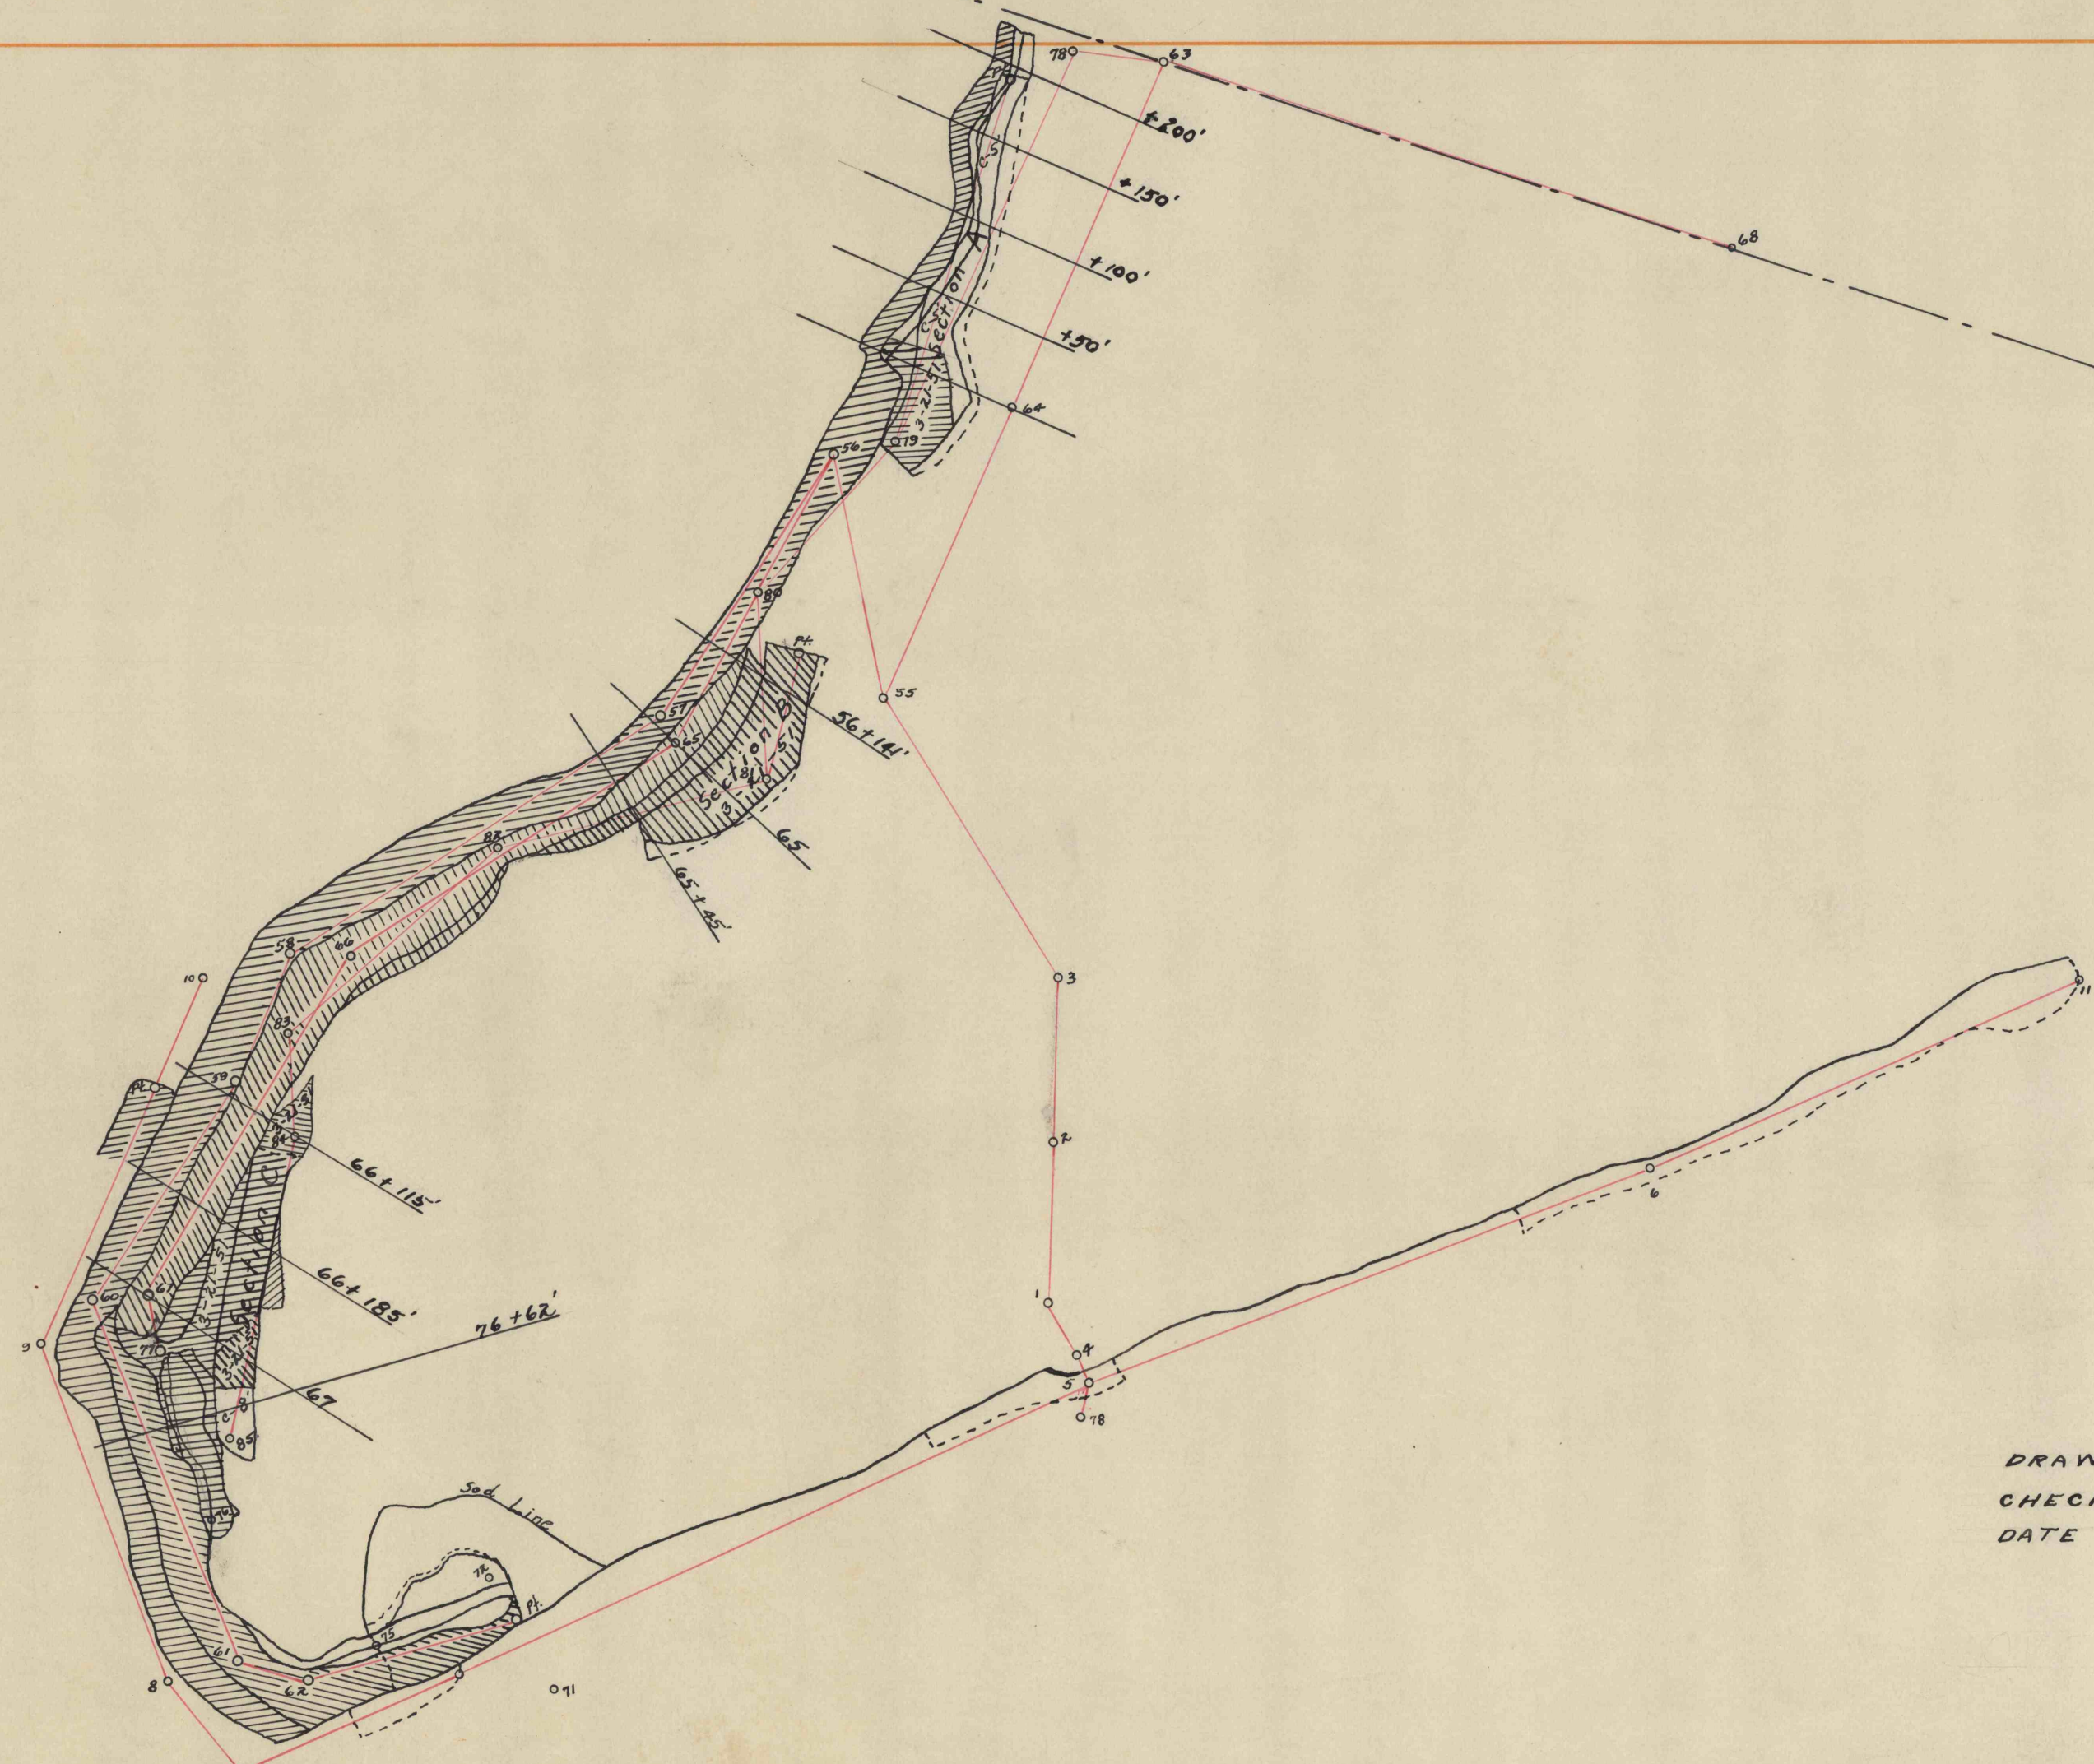

**NORTH AMERICAN REF. CO.**  
**CLEVELAND, OHIO**  
**PLAN & CROSS SECTIONS**

**RIVER HILL STRIPPING ----- 1950**  
**LOCK HAVEN, CLINTON CO., PA.**

DRAWN BY: J.R.H. JR.  
 CHECKED BY: J.C.M.  
 DATE SURVEYED: 6-28-50

PLAN SCALE: 1" = 100'  
 CROSS SECTION SCALE:  
 HOR. - 1" = 10' VER. - 1" = 5'  
 SCALE

INDEX NO 22-2-16

SECTION A



PLATE 1--CROSS SECTION U. P. R. & R. L. STANDARD  
 KEUFFEL & ESSER CO. NEW YORK

DATE \_\_\_\_\_  
 BY \_\_\_\_\_  
 SURVEYED \_\_\_\_\_  
 PLOTTED \_\_\_\_\_  
 NOTE BOOK \_\_\_\_\_  
 NO. \_\_\_\_\_  
 AREAS CHECKED \_\_\_\_\_

DATE \_\_\_\_\_  
 BY \_\_\_\_\_  
 SURVEYED \_\_\_\_\_  
 PLOTTED \_\_\_\_\_  
 NOTE BOOK \_\_\_\_\_  
 NO. \_\_\_\_\_  
 AREAS CHECKED \_\_\_\_\_

GEN 10181