

COLONIAL
WARRIORS MARK TWP

CLAY PITS
HUNTINGTON CO., PA.

OLD TRUCK GARDEN

REFERENCE DATA

NORTH AMERICAN REFRACTORIES CO.
1012 NATIONAL CITY BANK BUILDING
CLEVELAND, OHIO

ENV. No.


SHEET No.

40-3-84

SCALE 1"=100 FT.

DATE 3-30-43

- FROM G3 TO G4 - 104.2 FT.
- " G4 " G1 - 125.0 FT.
- " G1 " G5 - 100.3 FT.
- " G5 " G8 - 137.5 FT.
- " EAST END OF BIG POOL
TO G8 - 677. FT.

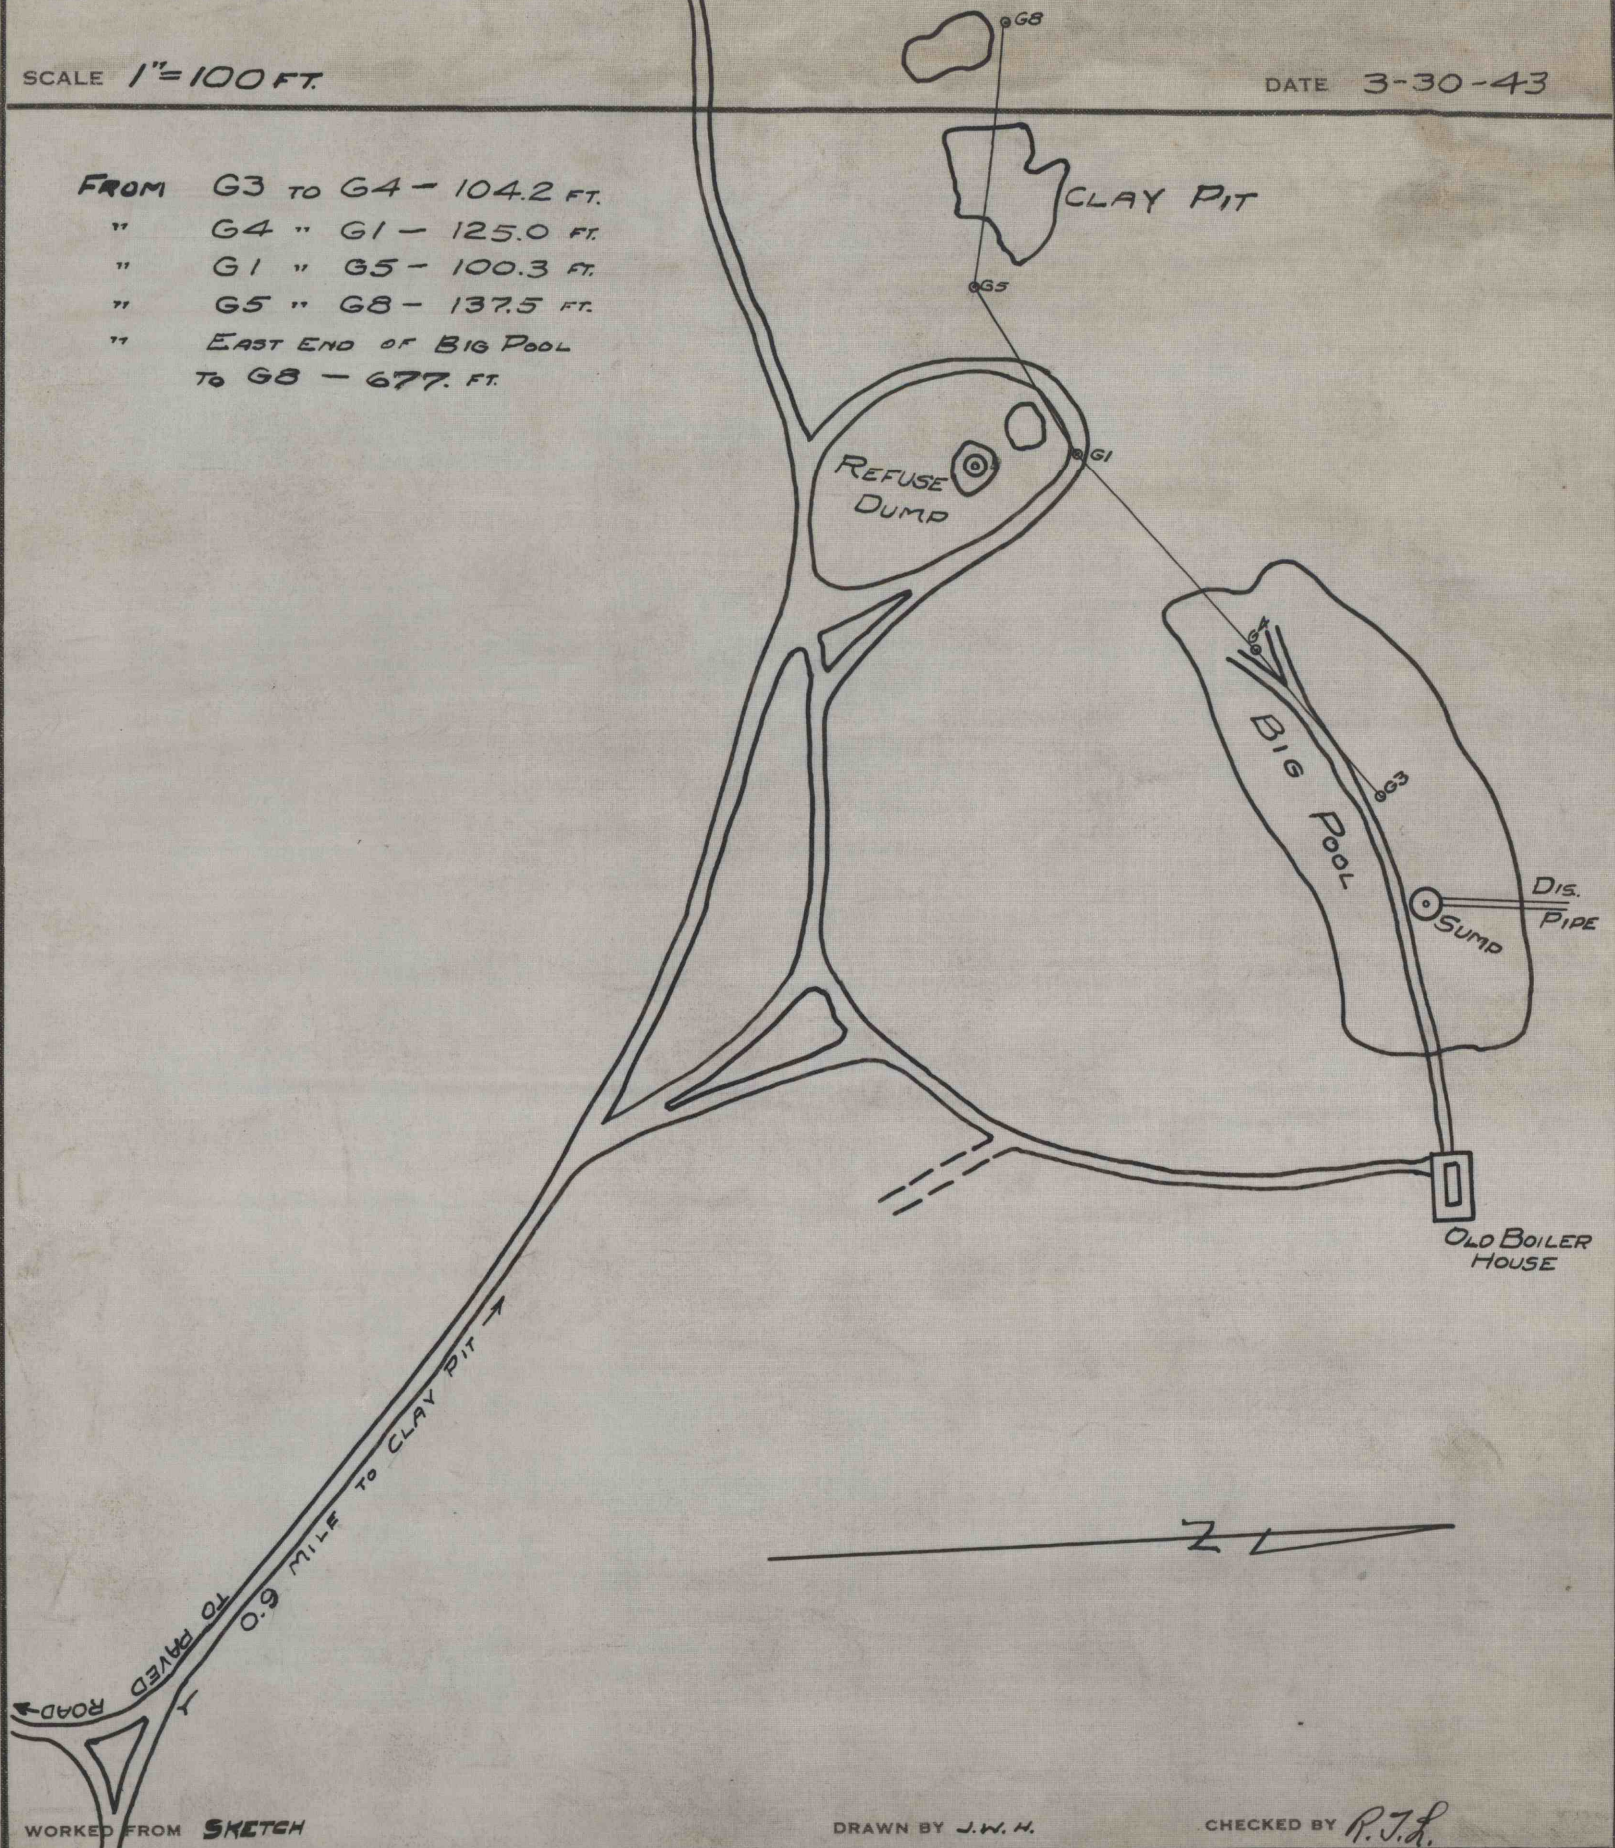

WORKED FROM SKETCH

DRAWN BY J.W.H.

CHECKED BY R.J.H.