

REFERENCE DATA


**BICKFORD FIRE BRICK COMPANY**  
 CURWENSVILLE, CLEARFIELD COUNTY, PA.  
 ENGINEERING DEPARTMENT

ENV. NO. L1  
 SHEET NO. 75  
 50-3-220

SCALE 1" = 100'

*East End Yard 18" T.C. Sewer*

DATE 8-17-16

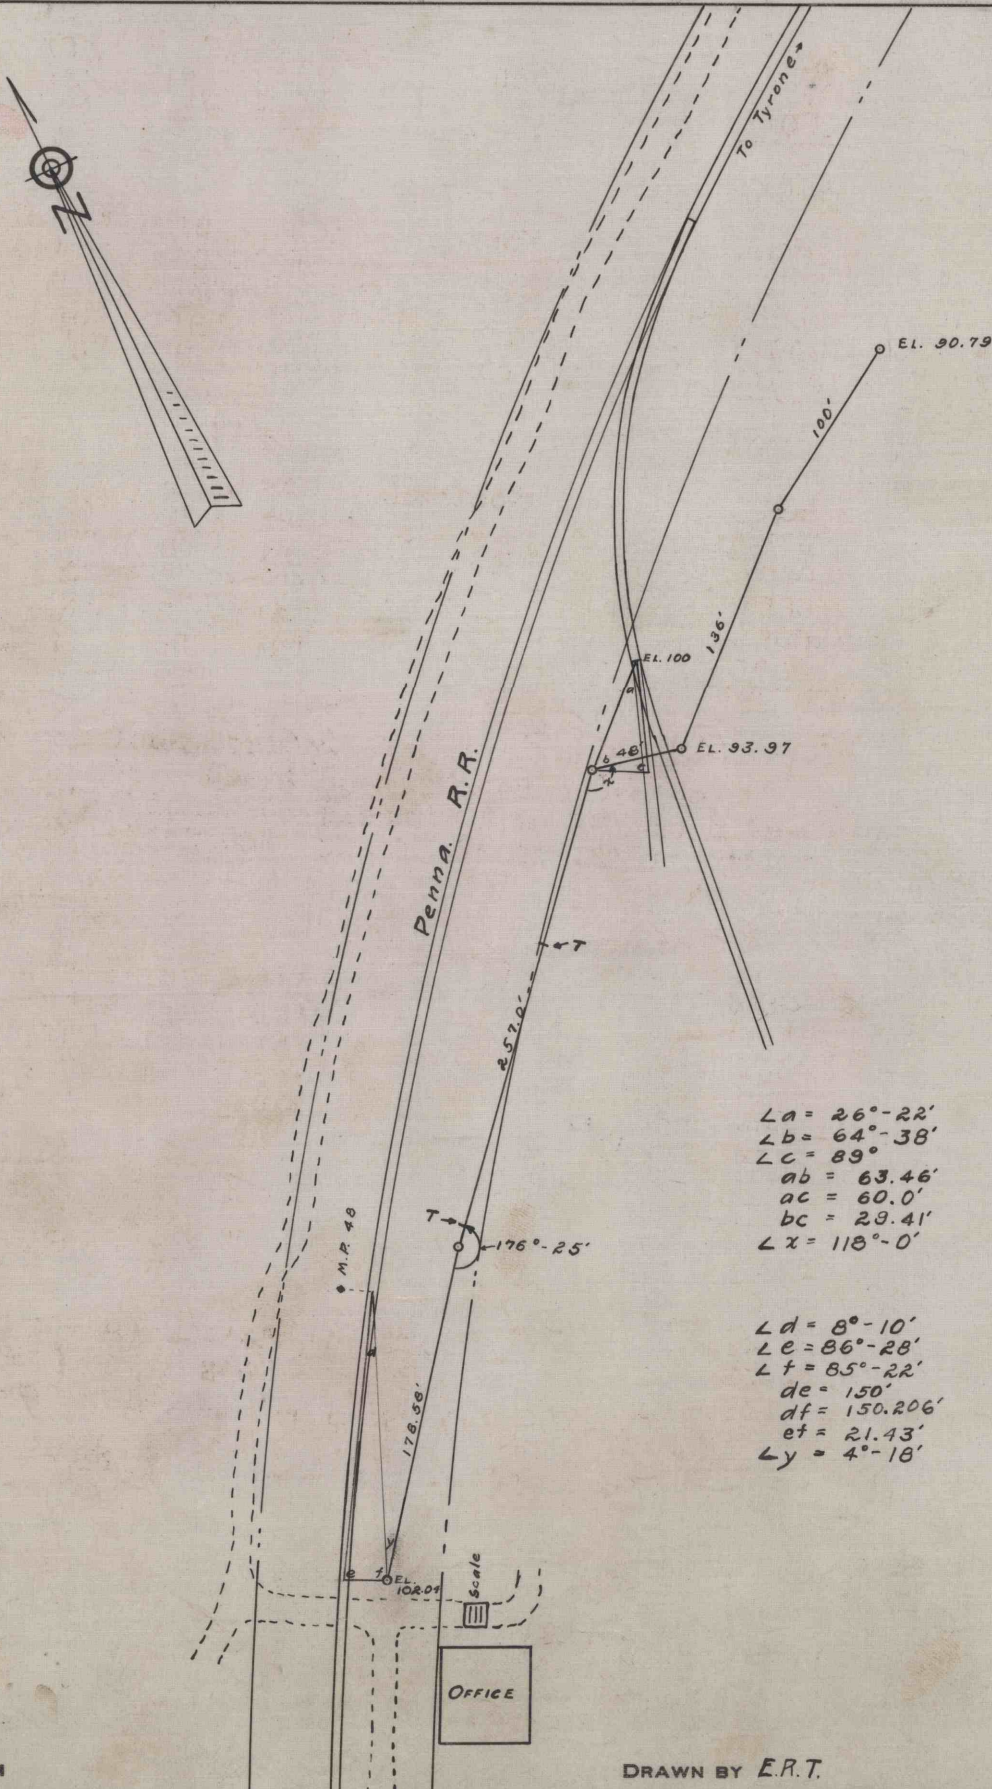

WORKED FROM

DRAWN BY E.R.T.

CHECKED BY *C.R.S.*