
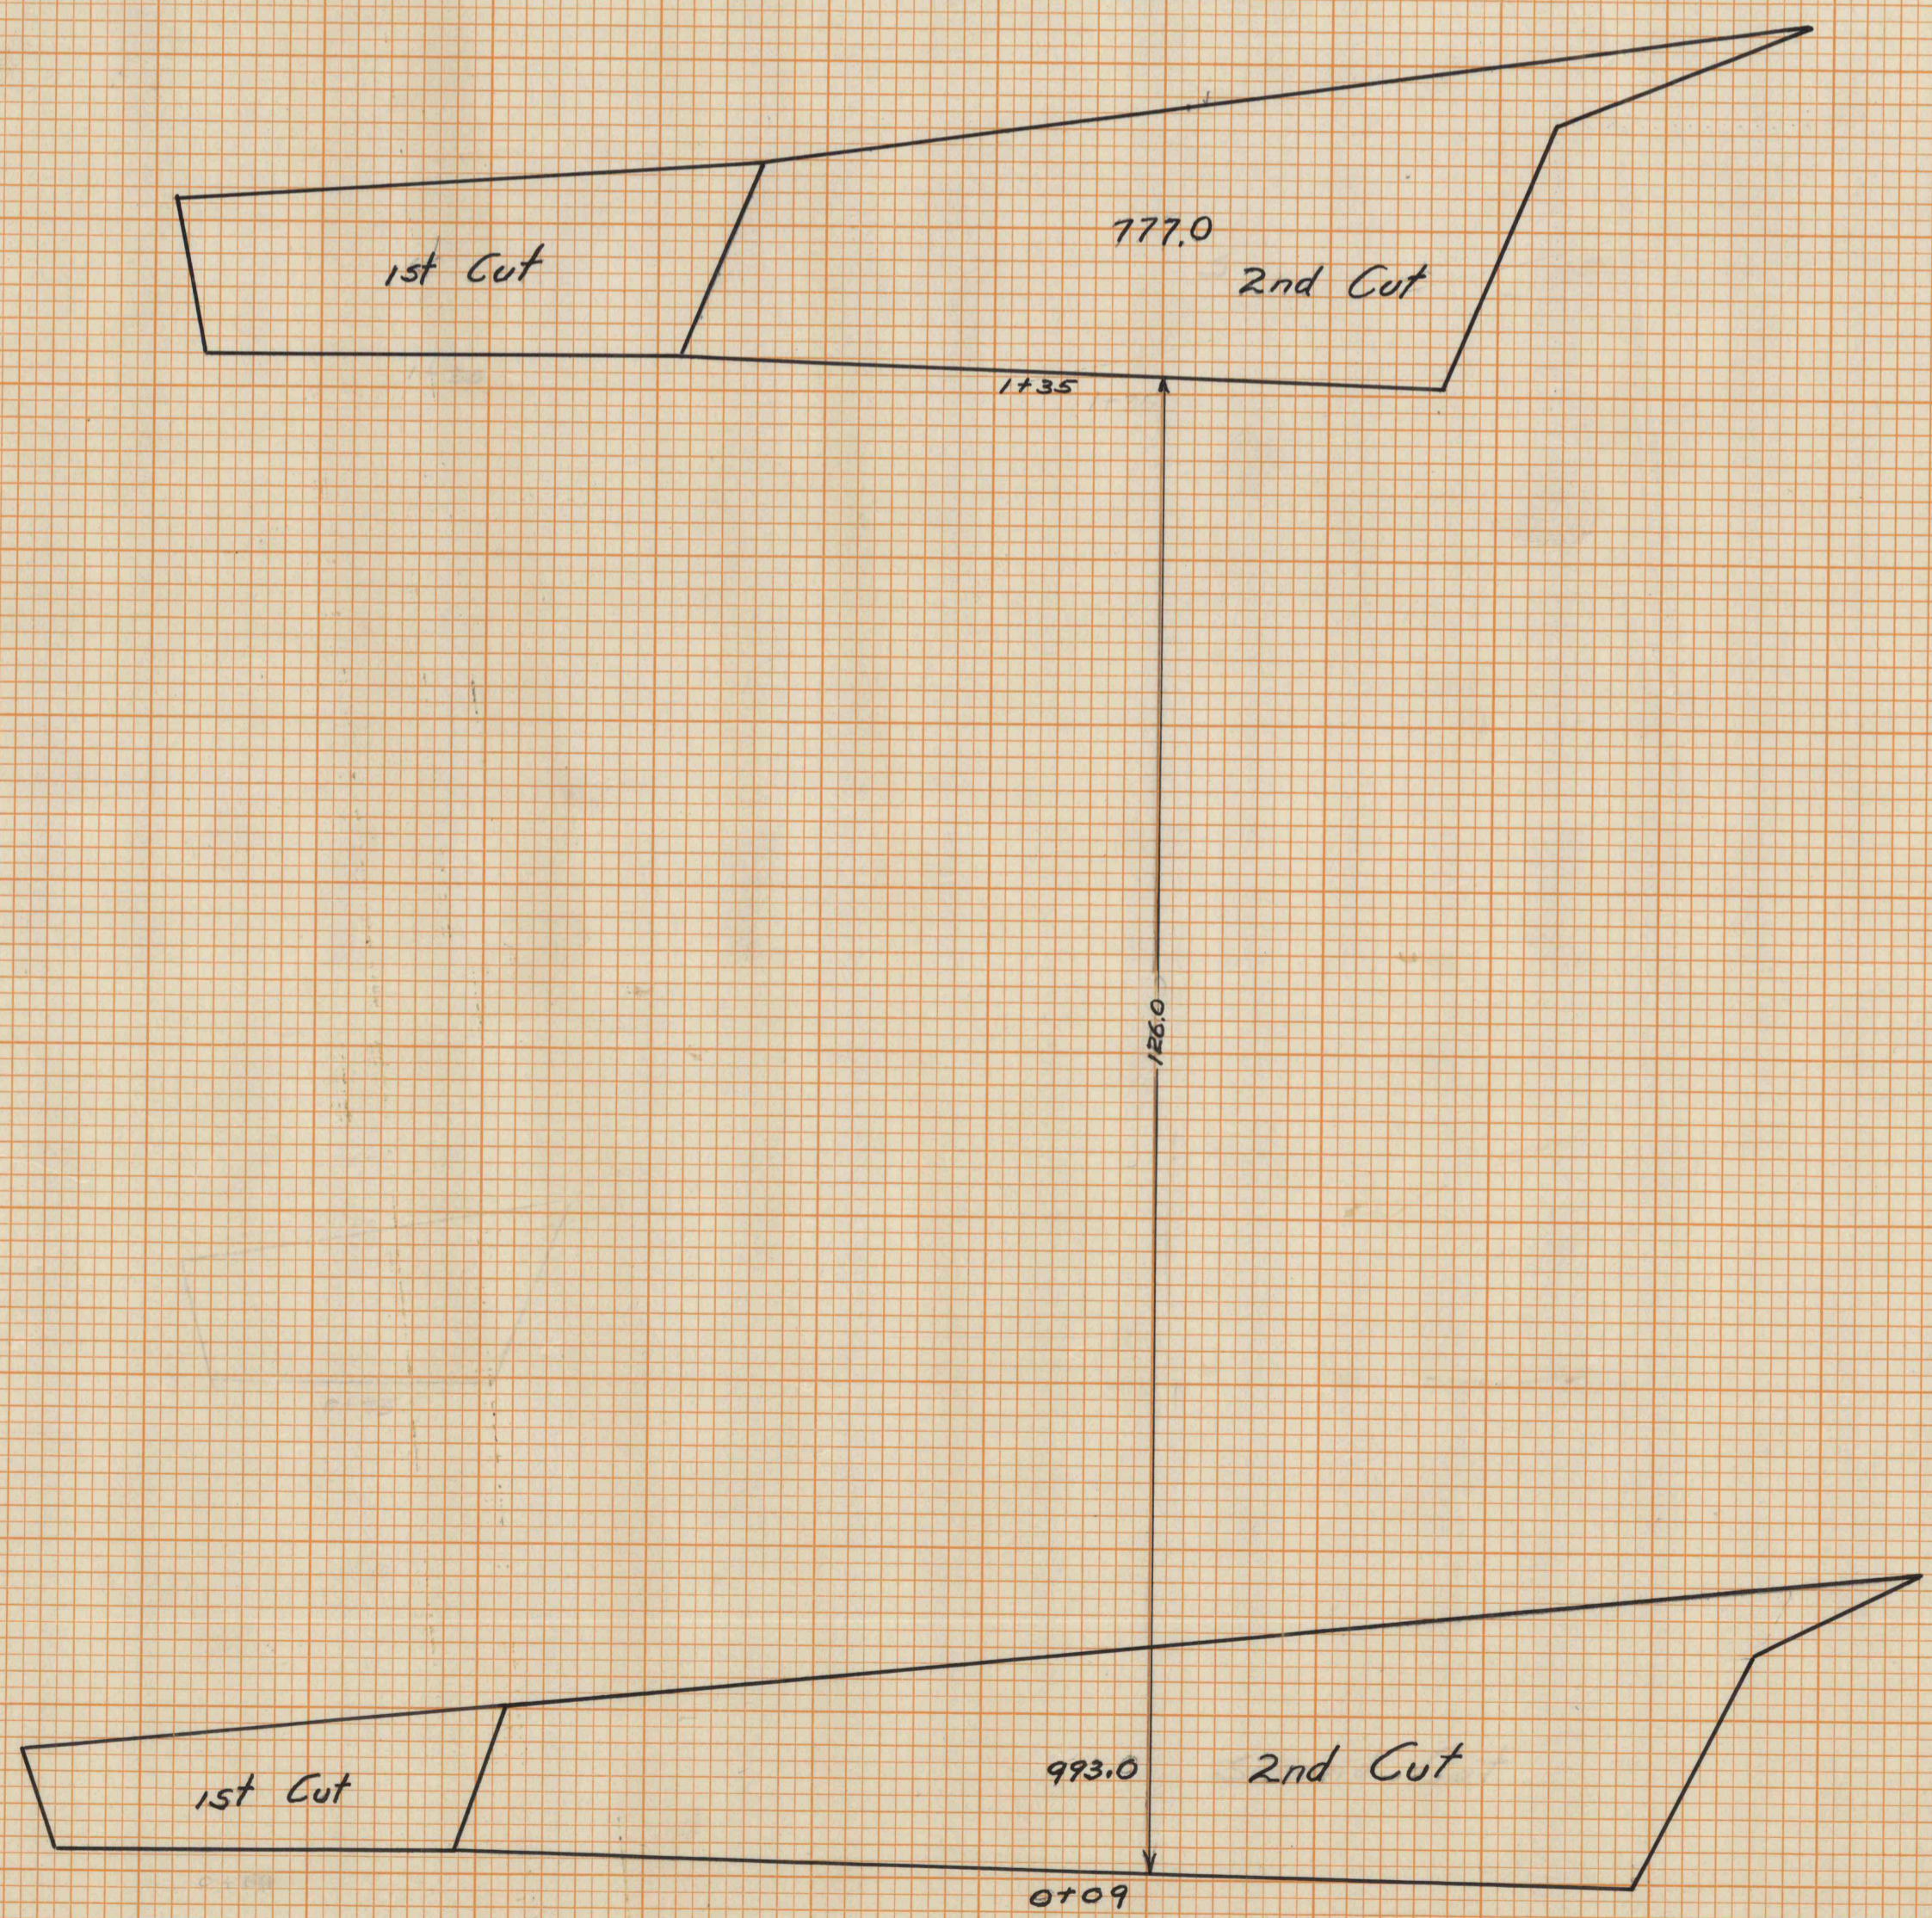


FINAL SURVEY SURVEYED, PLOTTED, NOTE BOOK, TEMPLATE, AREAS CHECKED, NO.

ORIGINAL SURVEY SURVEYED, PLOTTED, NOTE BOOK, TEMPLATE, AREAS CHECKED, NO.

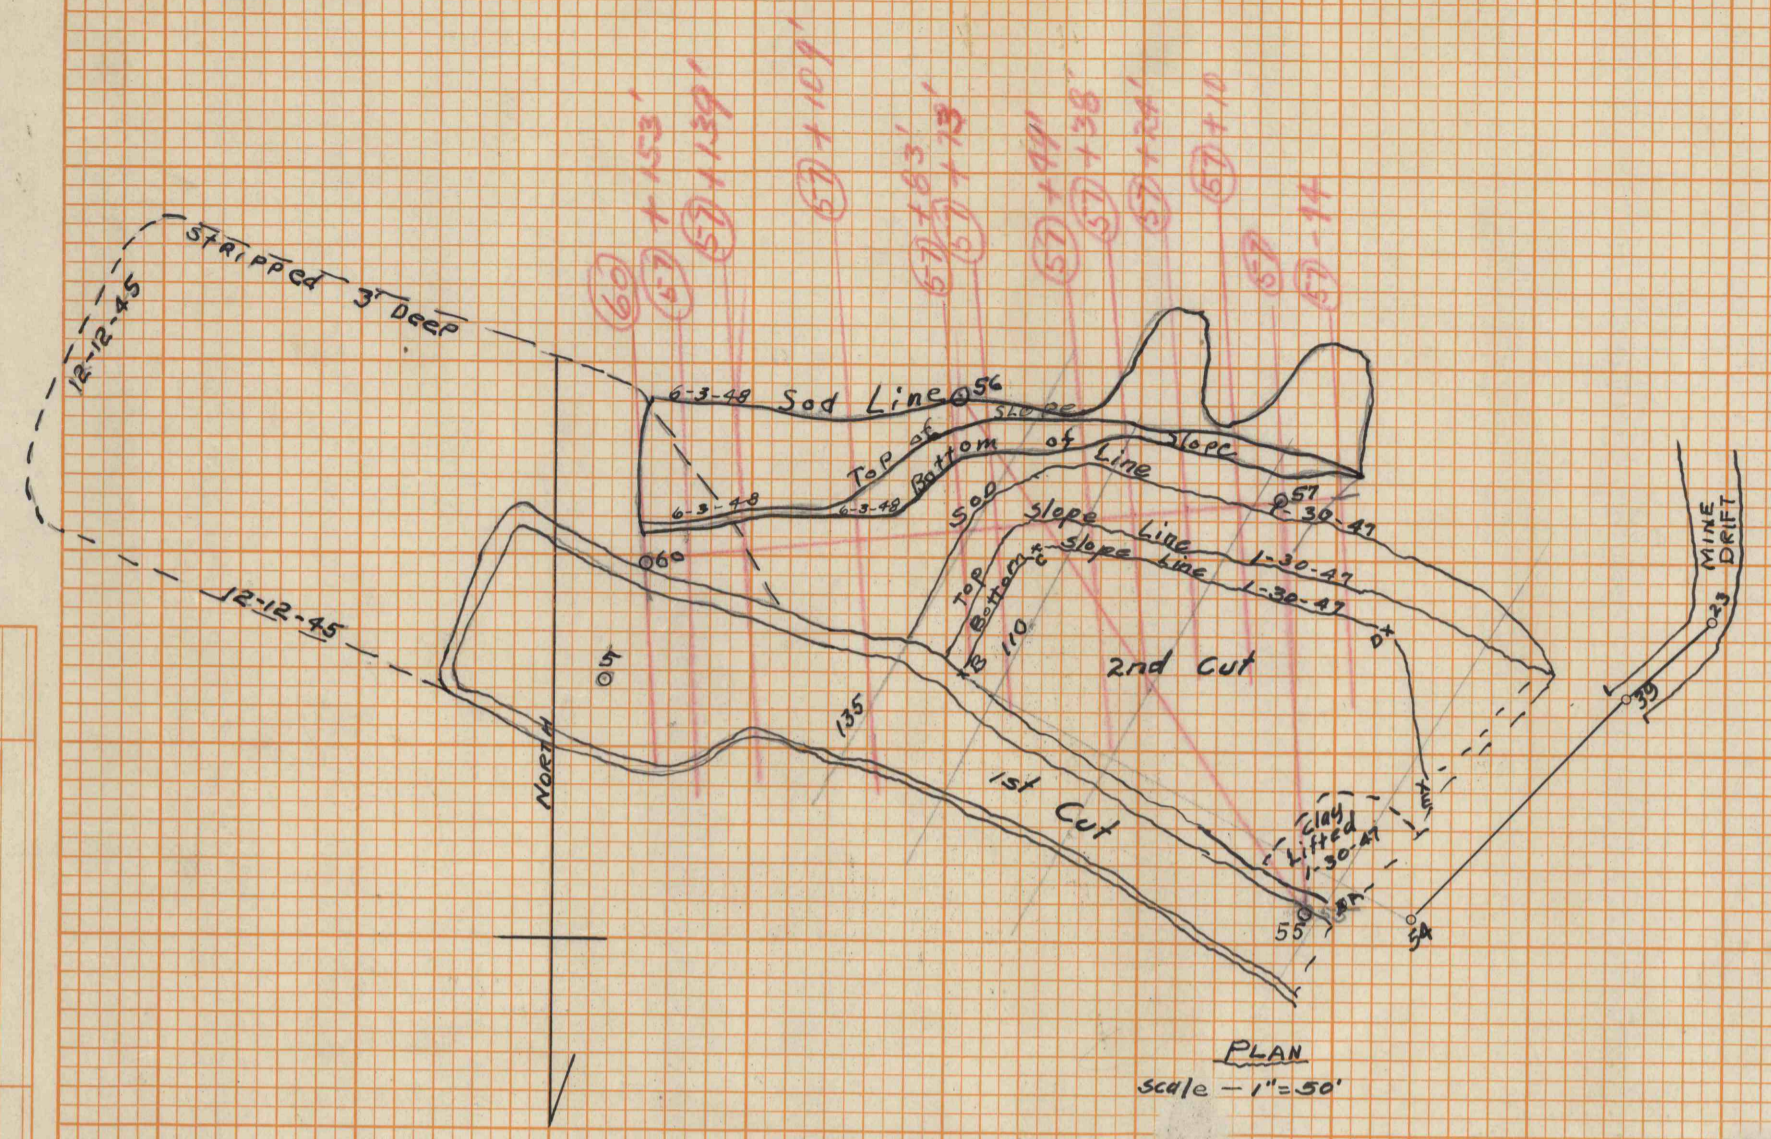

X Sections

BEECHER CLAY STRIPPING - LOCK HAVEN
NORTH EAST OF DRIFT - SECOND CUT

SURVEYED 1-30-47
CALCULATED 2-4-47 AEH
CHECKED JONGH
Scale Horizontal 1"=10'
Vertical 1"=10'

OVERBURDEN REMOVED - 4150 Cubic Yards

INDEX # 20-3-15B SHEET # 2