

TRUCK BRIDGE FORMERLY AT NORTH BEND PLANT

REFERENCE DATA

GEO. S. GOOD FIRE BRICK CO.

CURWENSVILLE, CLEARFIELD COUNTY, PA.
ENGINEERING DEPARTMENT


ENV. No.

SHEET No.

25-3-6

SCALE 1" = 10 FT.

DATE July 16, 1936.

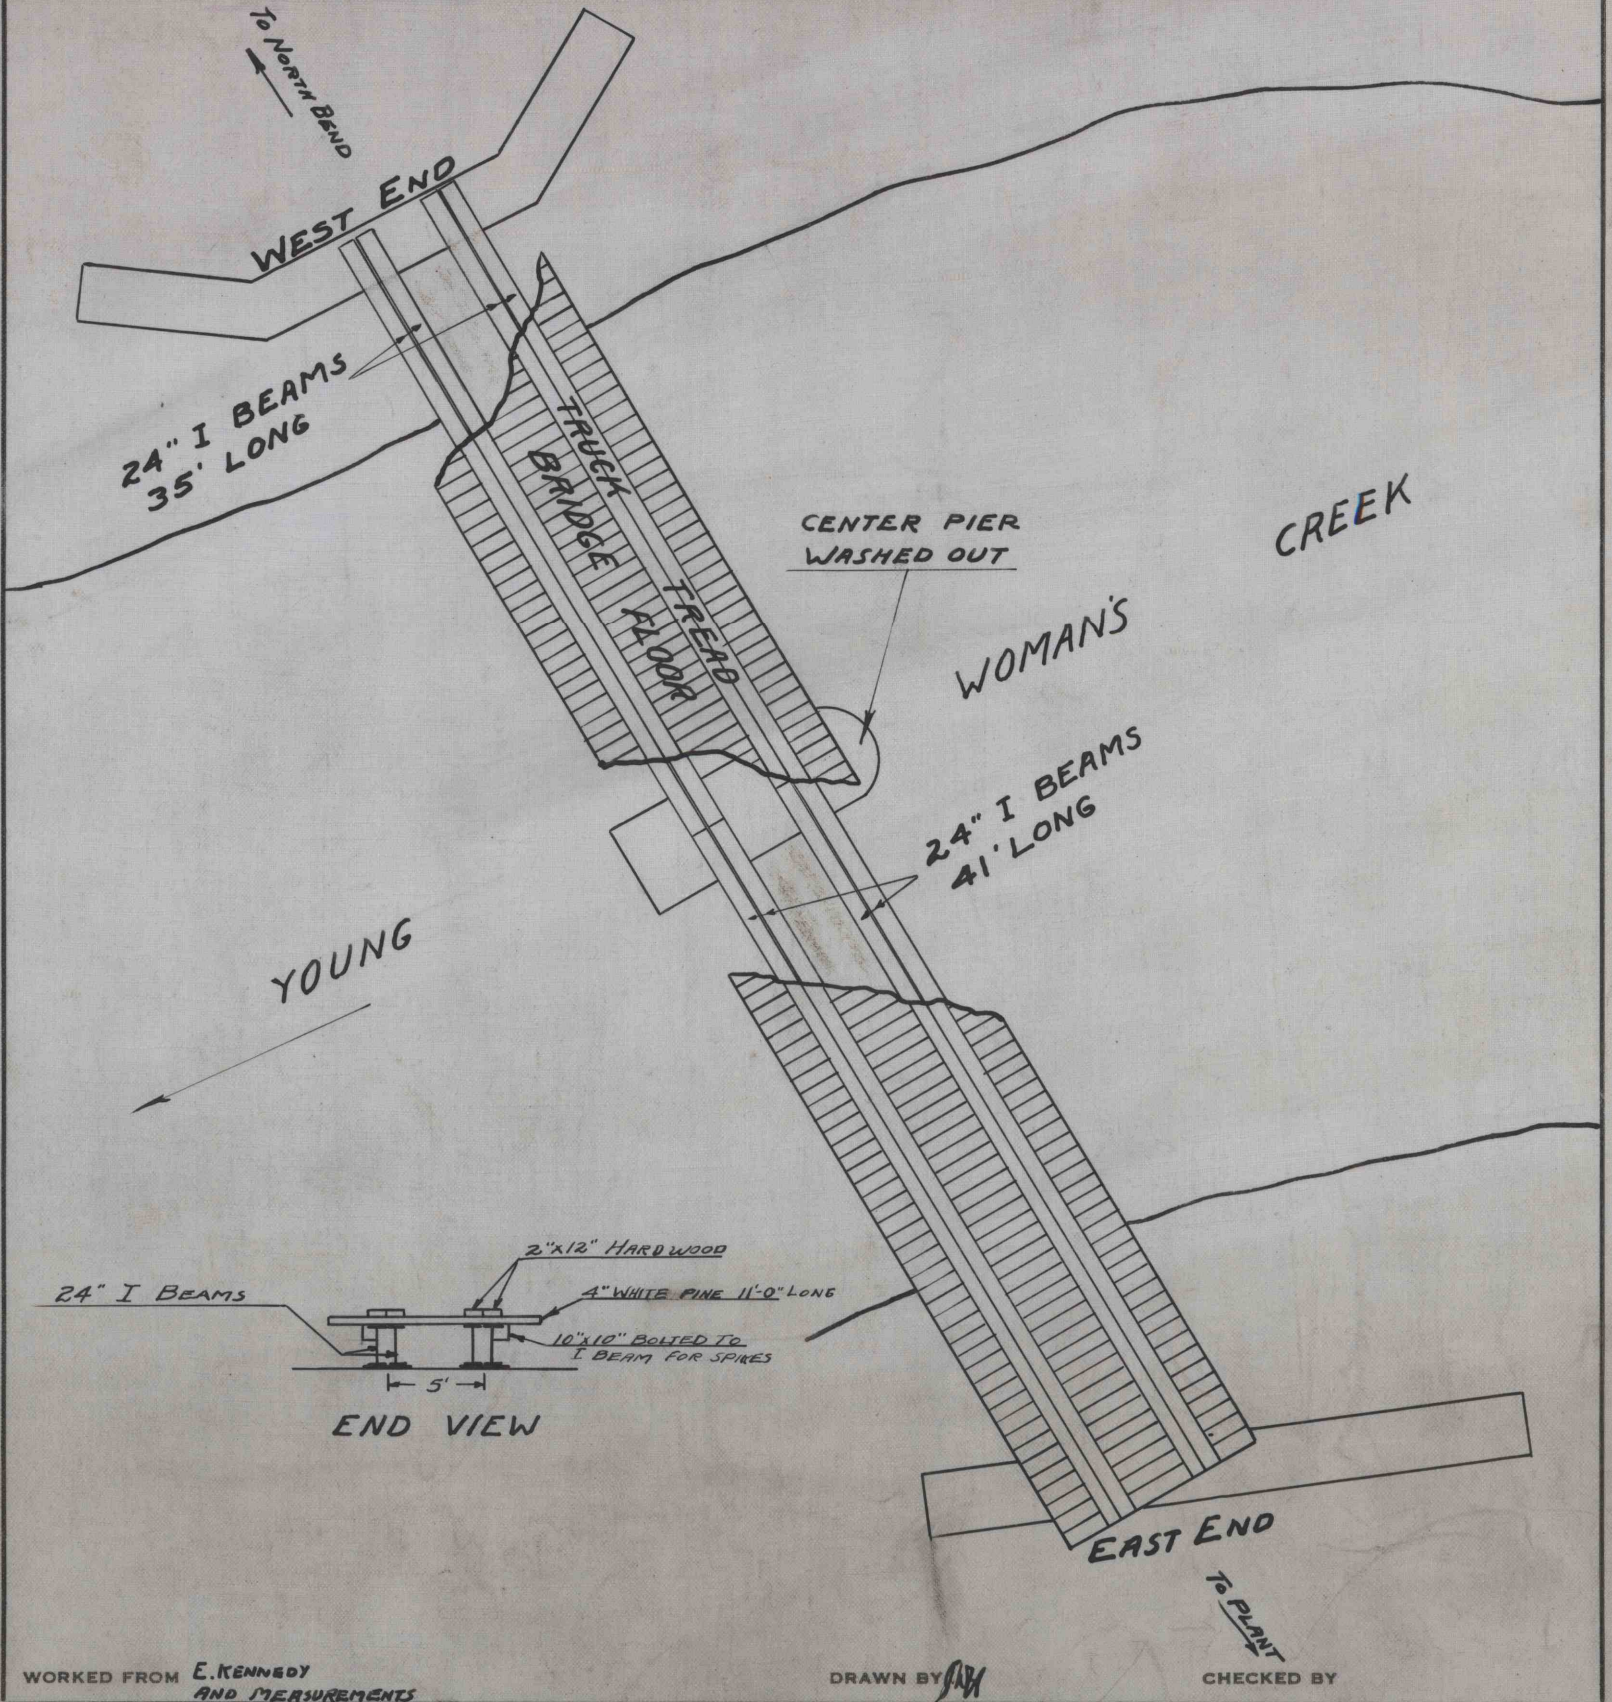

5-0-32

52-3-6