


DATE	
BY	
SURVEYED	
PLOTTED	
ALIGNMENT CHECKED	
RT. OF WAY CHECKED	
PLAN	
NOTE BOOK	
NO.	

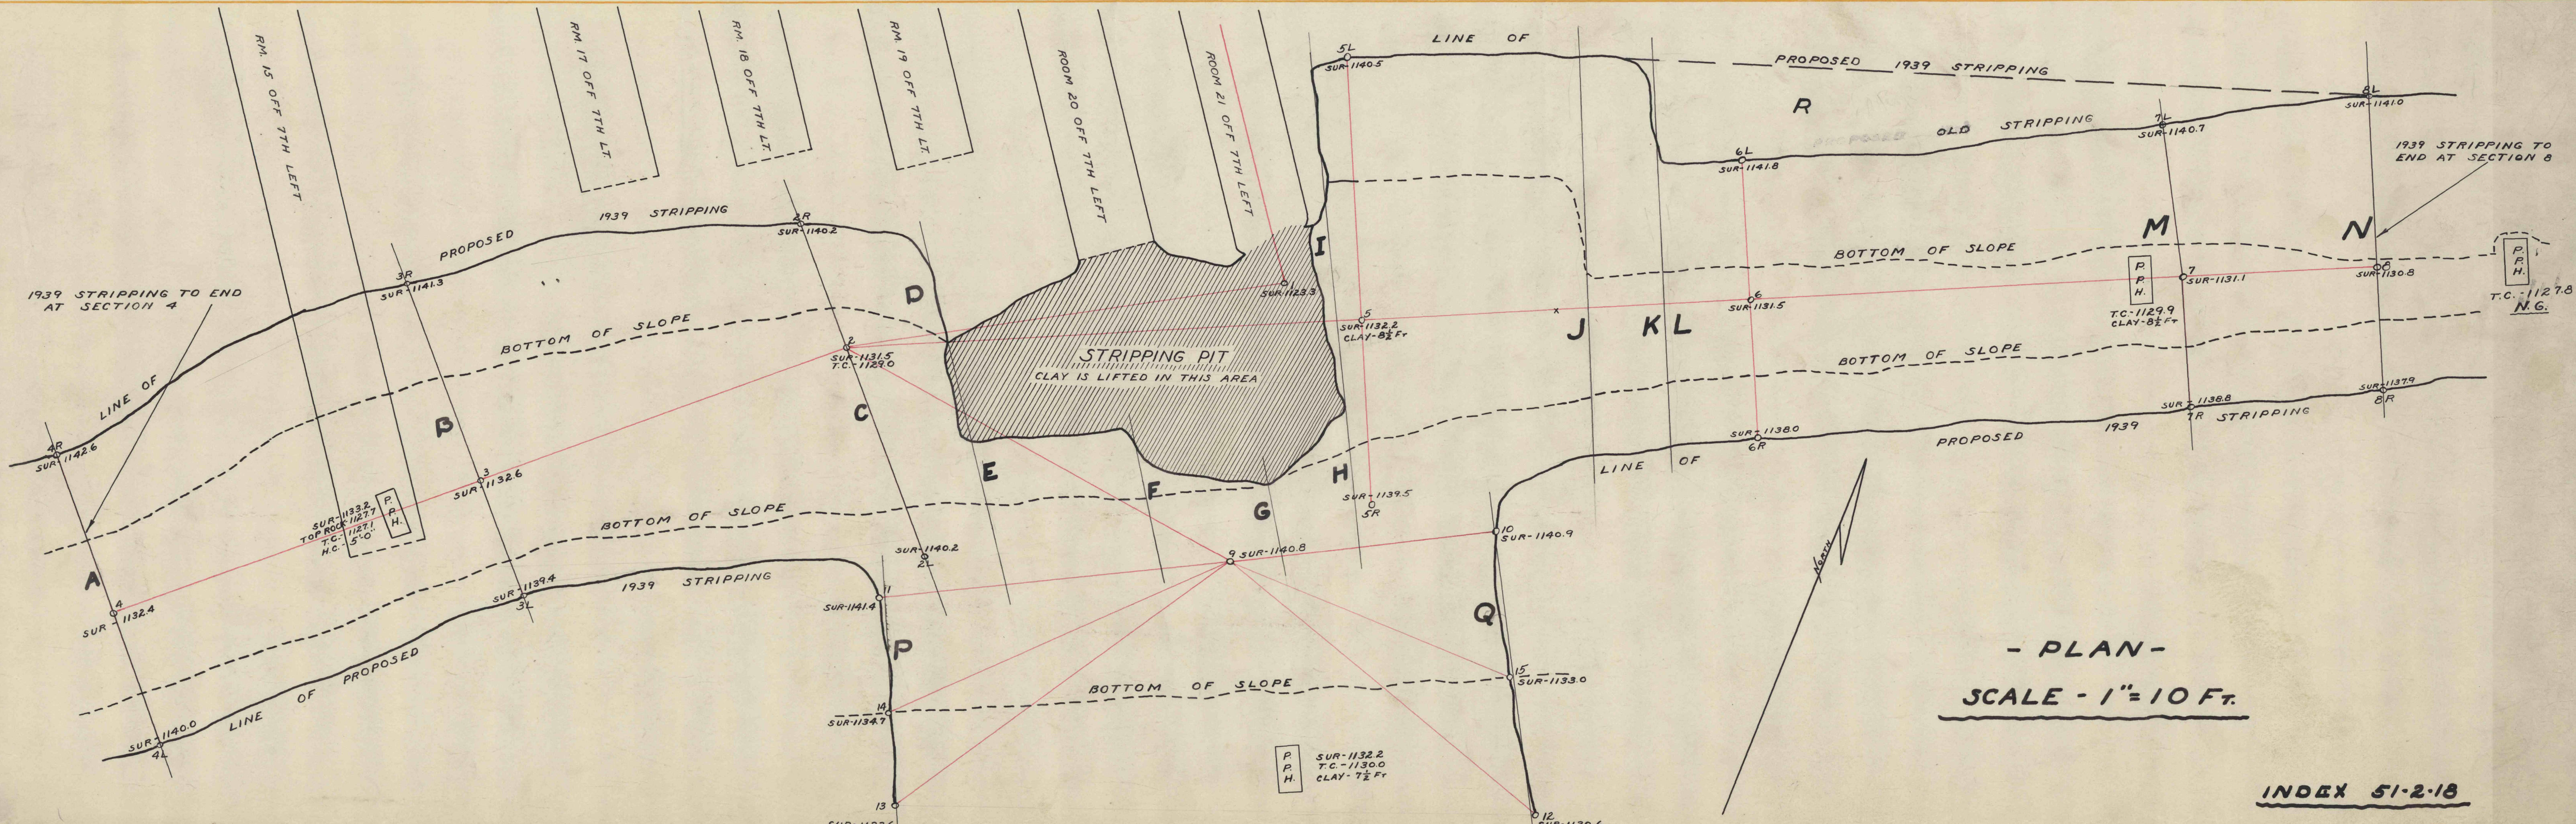

- PLAN -
 SCALE - 1" = 10 FT.

INDEX 51-2-18