

ENV. NO. L 2

# BICKFORD FIRE BRICK COMPANY


1122 FARMERS BANK BLDG., PITTSBURG, PA.  
ENGINEERING DEPARTMENT

SHEET NO. ~~99~~  
50-1-352

SCALE 1" = 200'

8" WATER LINE. C.I.

DATE 11-8-17

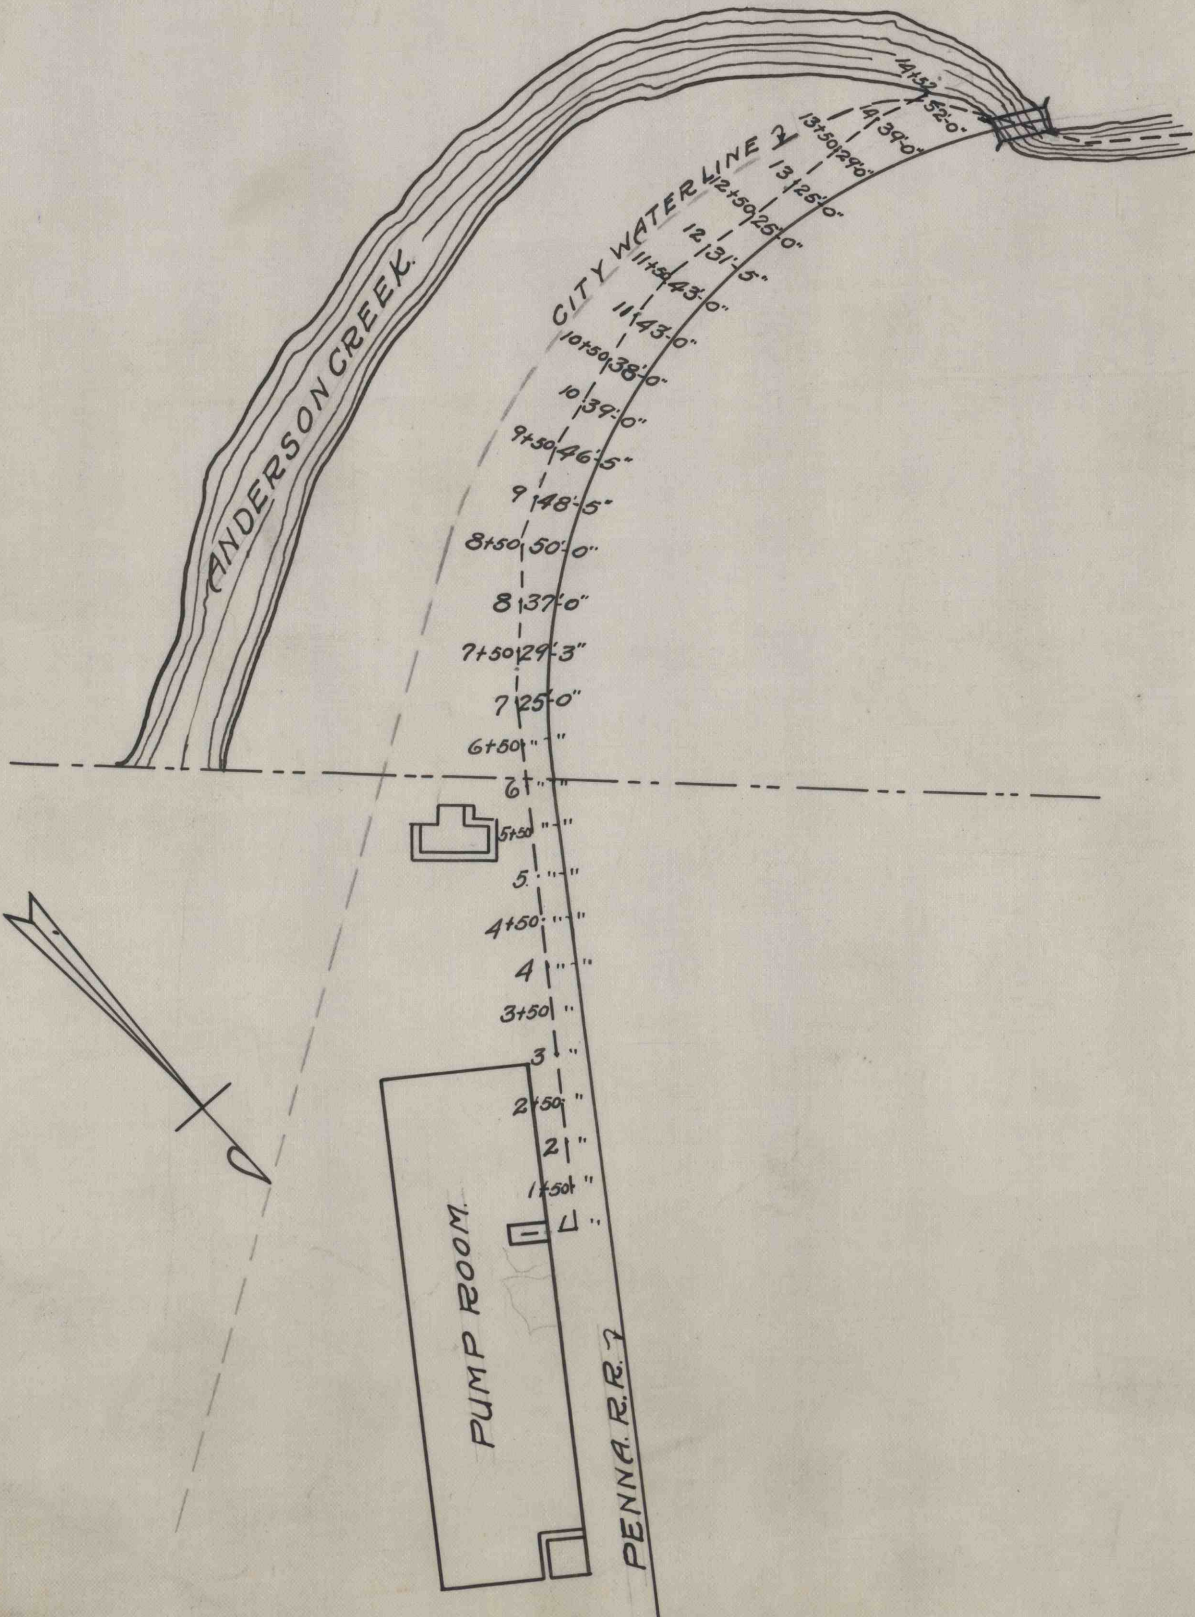

WORKED FROM

DRAWN BY E.R.E.

CHECKED BY

R.A.N.

PENNA-0150