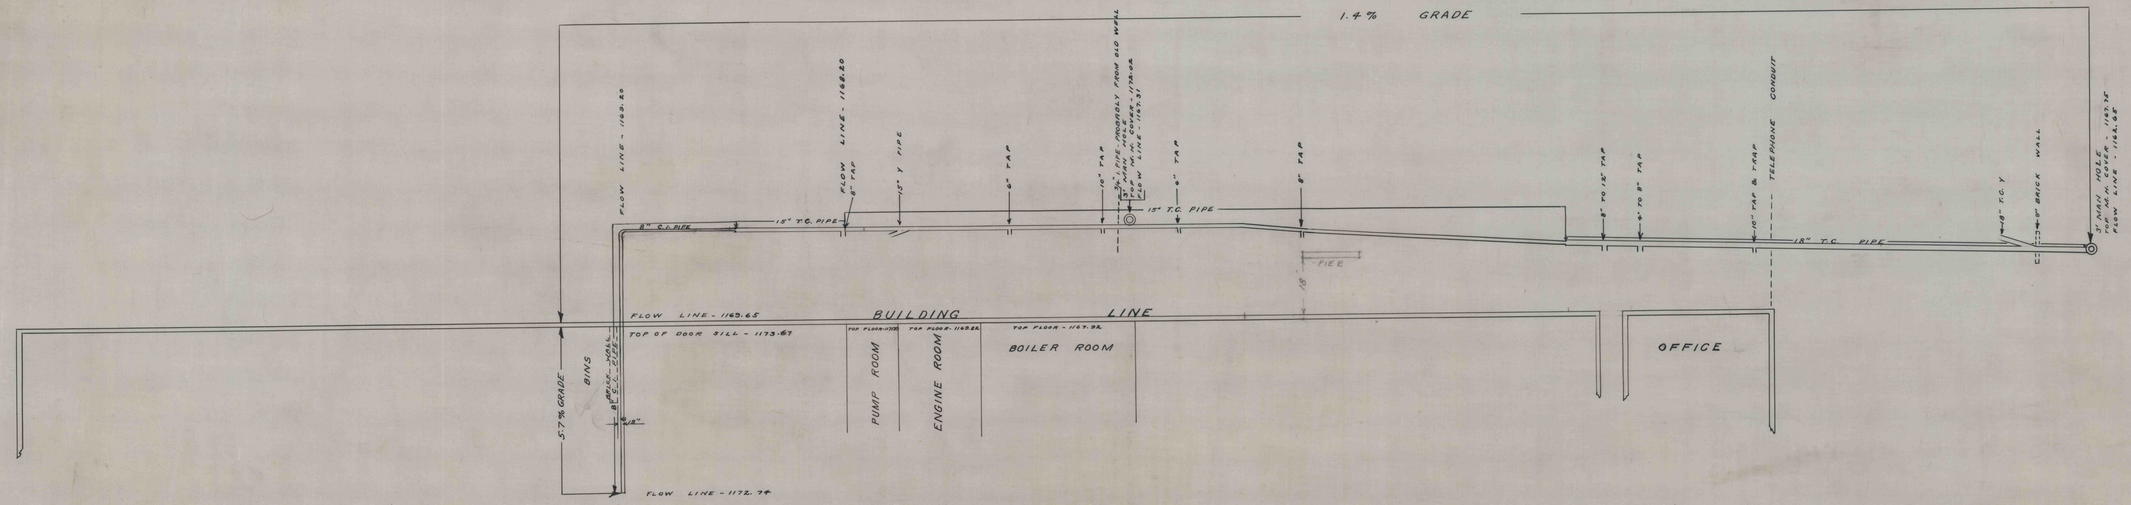

NORTH AMERICAN REFRACTORIES CO.
1012 NATIONAL CITY BANK BUILDING
CLEVELAND, OHIO

LOCATION OF PLANT DRAIN AT CURWENSVILLE

DRAWN J.R.H., Jr.	SCALE 1" = 20'	50-1-2126
CHECKED	DATE 5-10-51	
REFERENCE SURVEY N.E. 180-257 & 90-257, P.27-28-29	TRACED BY J.R.H., Jr.	