


20-2-102

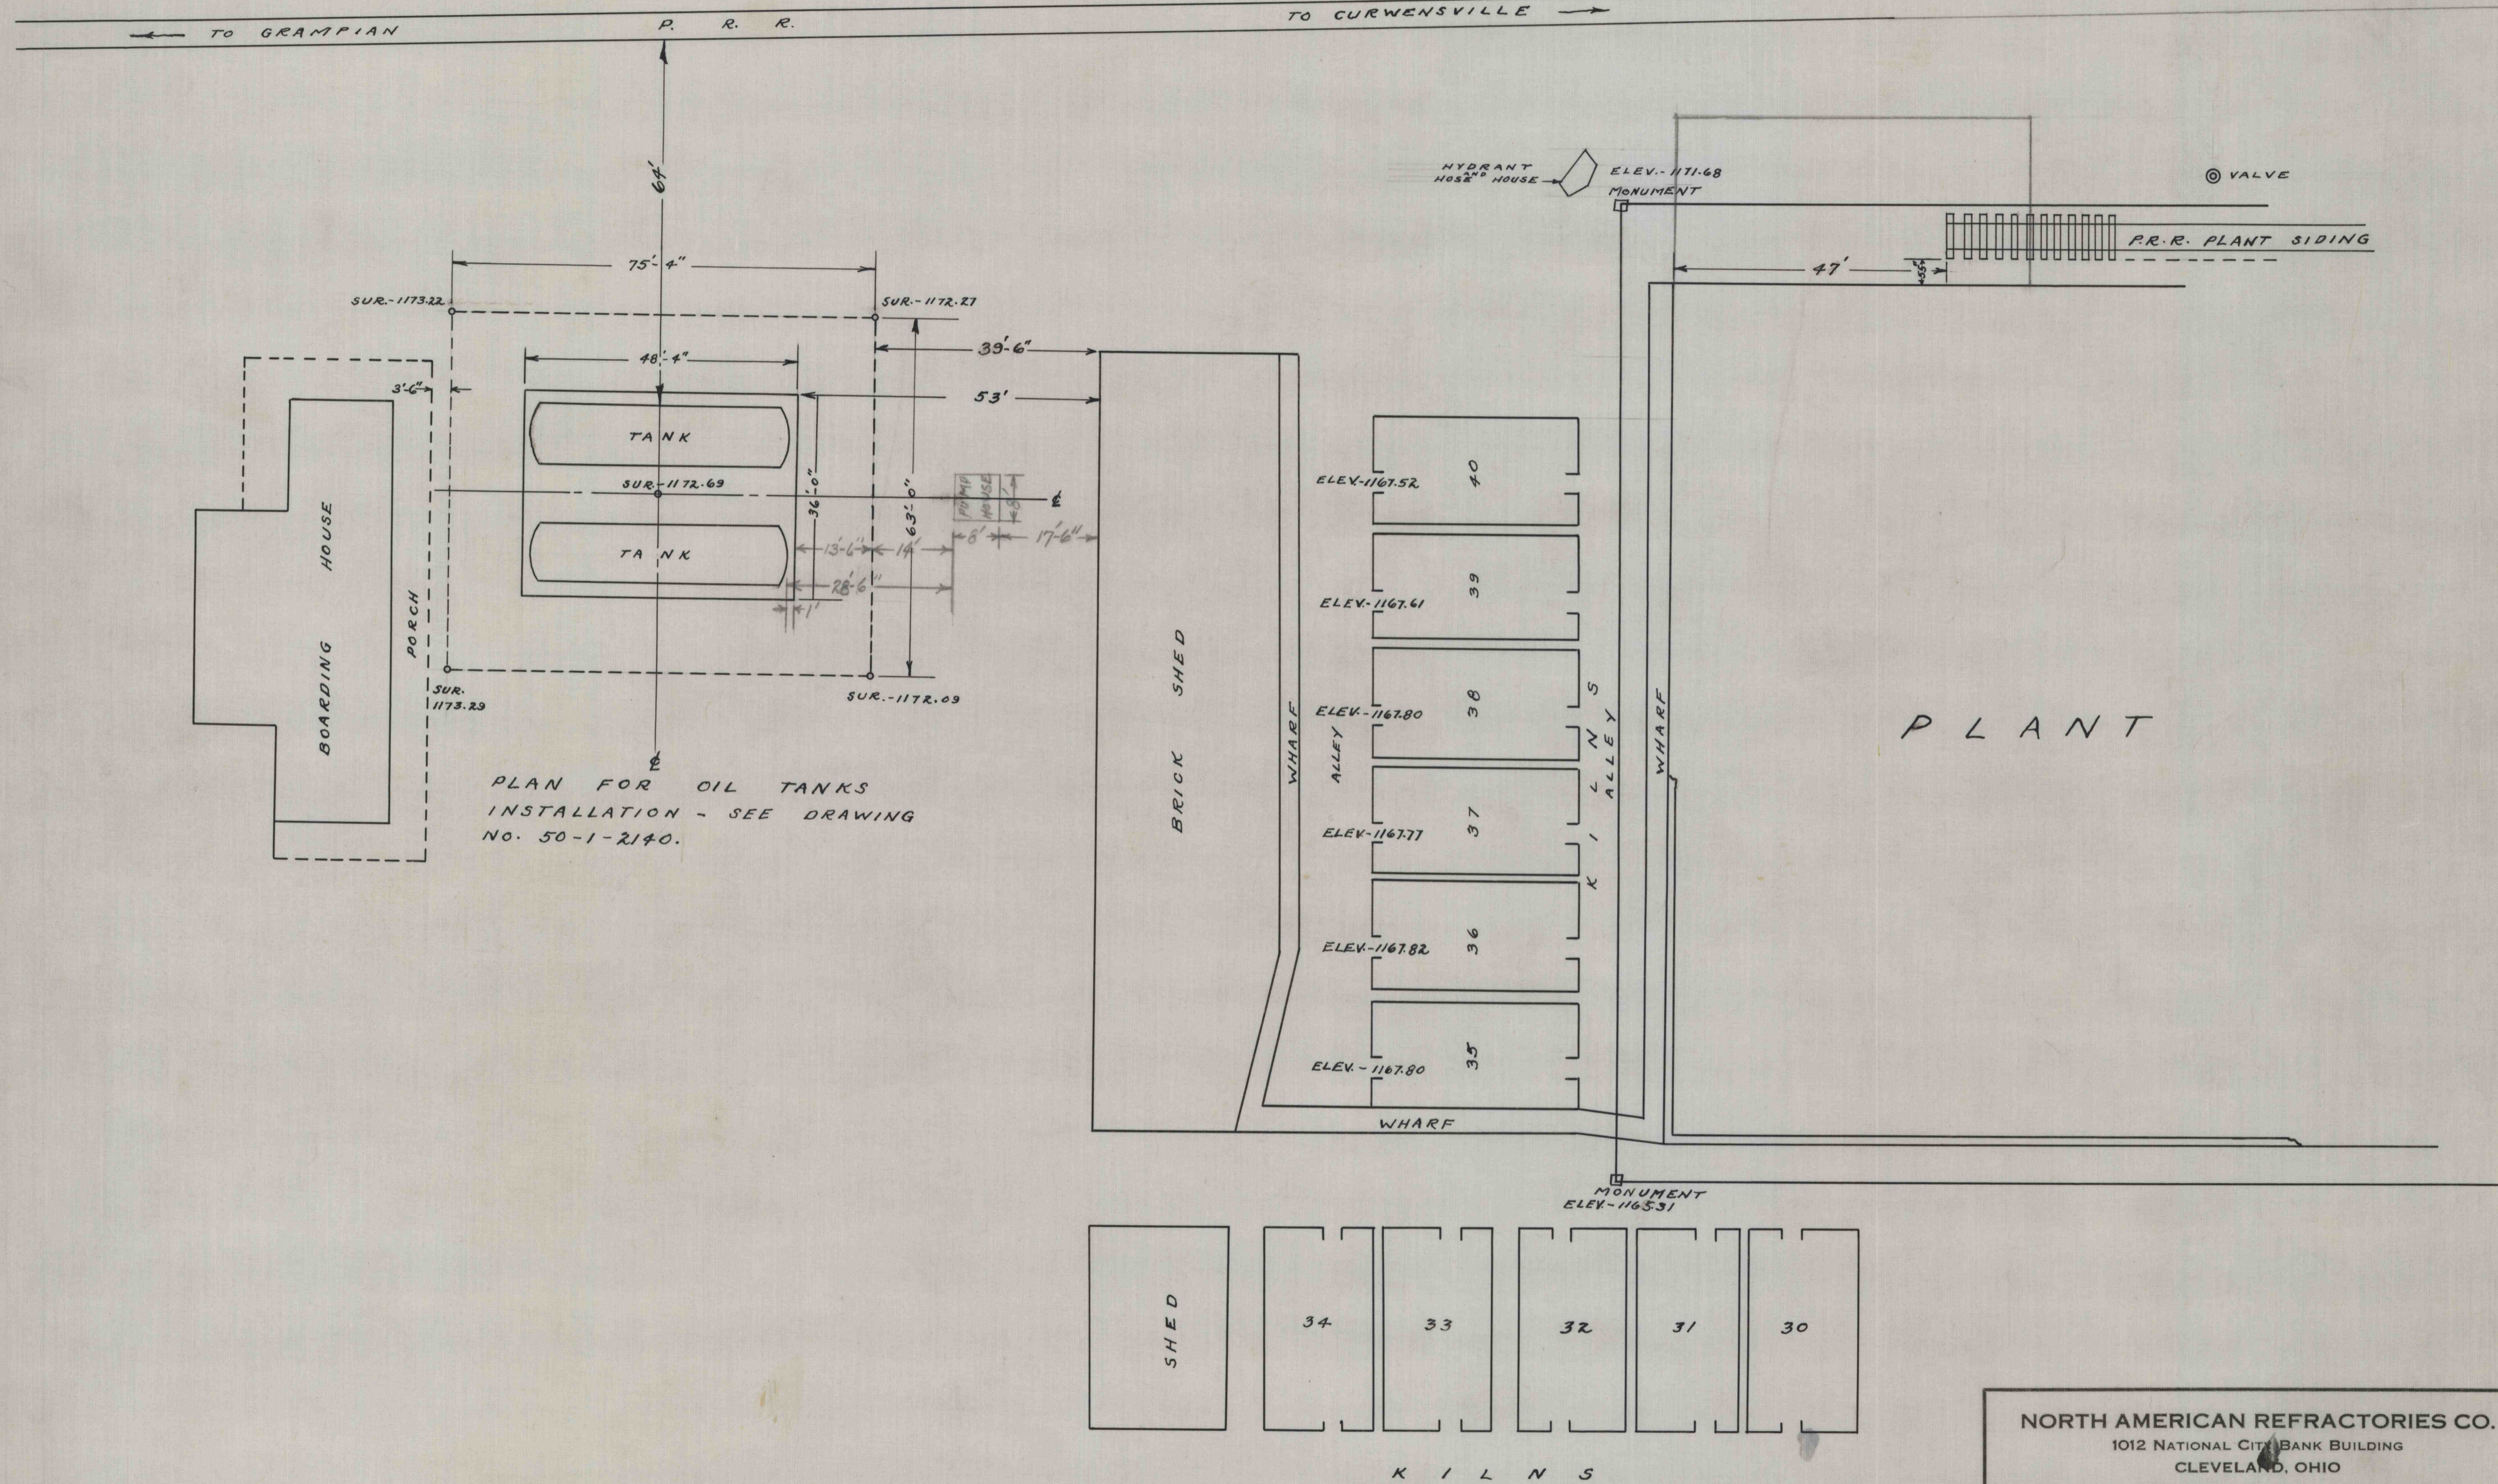

PLAN FOR OIL TANKS
 INSTALLATION - SEE DRAWING
 NO. 50-1-2140.

NORTH AMERICAN REFRACTORIES CO.
 1012 NATIONAL CITY BANK BUILDING
 CLEVELAND, OHIO

MAP SHOWING LOCATION
 OF OIL TANKS INSTALLATION
 AT CURWENSVILLE PLANT
 (REVISED)

DRAWN J.R.H.Je.	SCALE 1" = 20'	50-3-1378
CHECKED J.R.H.Je.	DATE 1-30-52	50-1-2154
REFERENCE	TRACED BY J.R.H.Je.	

20-2-1338